


U. S. PUBLIC LAND SURVEY MONUMENT RECORD

SECTION 25 T 15 N, R 7 W, TOWN OF SHELBY

LA CROSSE COUNTY

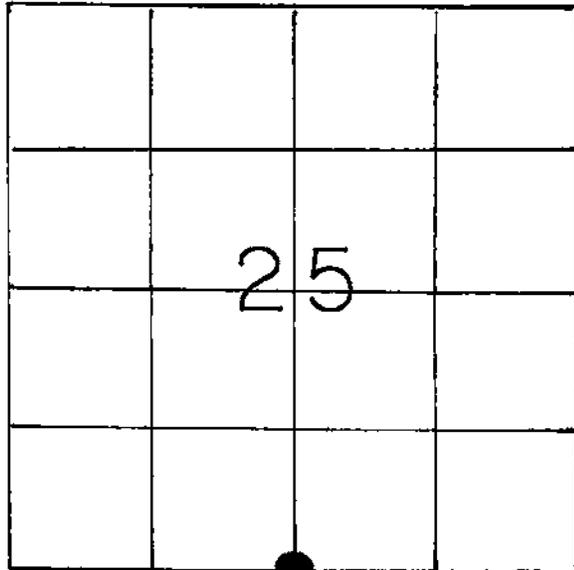

LOCATION OF LANDMARK

WISCONSIN COORDINATE SYSTEM

North

East

Theta Angle

Horiz. Order

Vert. Order

TYPE OF LANDMARK

Existing 1" iron pipe

BEARINGS ARE REFERENCED TO

Crew: William C. Jung
Peter F. Follansbee

Date: 9/10/91

Describe any record evidence, monument evidence, testimonial evidence or any other material evidence you considered and whether the monument was found or restored through acceptance of an obliterated evidence location.

I found an iron pipe at the occupied corner (North and West). This point had been used as the corner in a previous survey. I accepted this location as the best available evidence of the original government corner position.


Describe or show any material discrepancy between the location of the restored corner and that of the corner previously restored or reestablished.

None known.

RECORD OF DURABLE WITNESS MONUMENTS

Magnetic North

NO	DESCRIPTION	BEARING	DISTANCE
1	P.K. nail in a 18" hickory	S88°W	slope=27.47
2	" 8" white oak	N10°E	6.02
3	" 2' double white oak	S64°E	slope=36.42
4	" 10" oak	S21°E	slope=11.05

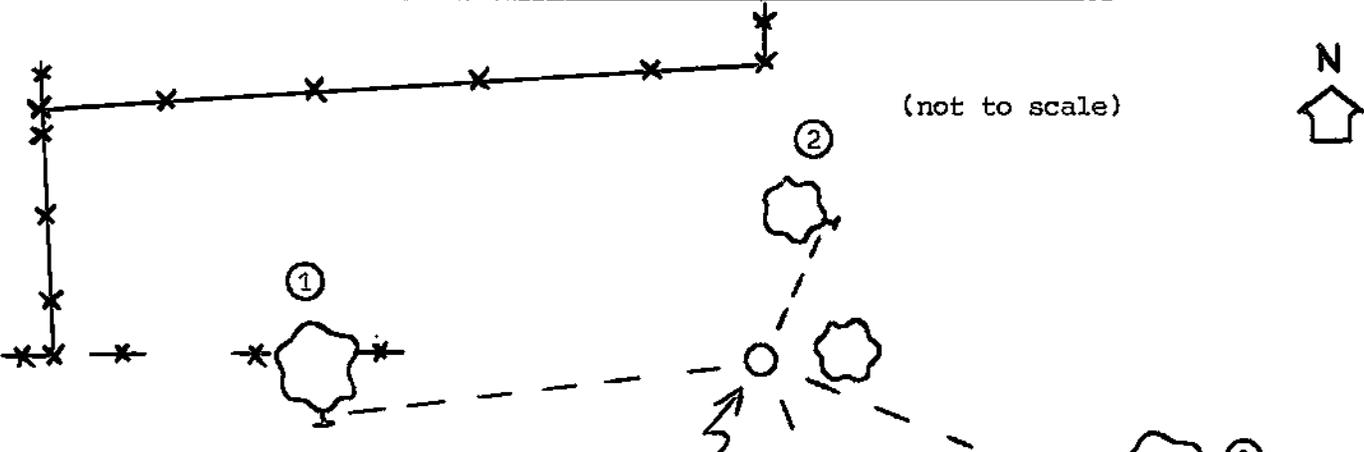

Found a 1" iron pipe, up 6", with a red Hofmeister plug, and surrounded by 3 steel fence posts and wire. Each tree has a new blaze and an old Hofmeister blaze. 1.7' to the East of the pipe is the center of a 6" hickory w/sign.

PLAN VIEW DRAWING OF REFERENCE TIES



MAP SHOWING DISTANCE AND DIRECTION TO OTHER PUBLIC LAND SURVEY CORNERS USED FOR REESTABLISHING THE CORNER

No field measurements by me at this time. This location had been verified by a previous survey.

I, William C. Jung, Deputy County Surveyor,
 HEREBY CERTIFY THAT THE CORNER LOCATION SHOWN ON THIS RECORD
 WAS DETERMINED BY ME OR UNDER MY DIRECTION AND CONTROL AND
 THAT THIS U. S. PUBLIC LAND SURVEY MONUMENT RECORD IS CORRECT
 AND COMPLETE TO THE BEST OF MY KNOWLEDGE AND BELIEF.

William C. Jung 9/11/91
 Signature Date



Seal