


21507260020

U. S. PUBLIC LAND SURVEY MONUMENT RECORD

SECTION 26 T 15 N, R 7 W, TOWN OF SHELBY

LA CROSSE COUNTY

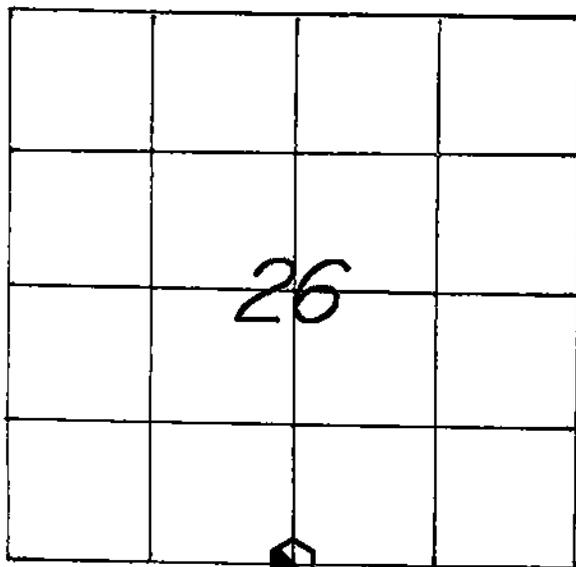

LOCATION OF LANDMARK

CREW: WILLIAM C. JUNG
 PETER F. FOLLANSBEE
 DATE: 3/18/2004

WISCONSIN COORDINATE SYSTEM

North

East

Theta Angle

Horiz. Order

Vert. Order

TYPE OF LANDMARK

4" BERNTSEN TOP IN A 2" IRON PIPE.

BEARINGS ARE REFERENCED TO

Describe any record evidence, monument evidence, testimonial evidence or any other material evidence you considered and whether the monument was found or restored through acceptance of an obliterated evidence location.

We found an iron pipe at the corner that had been used as the corner in previous survey work. I accepted the pipe as the best available evidence of the original government corner position. We set a 4" Berntsen top in a square channel iron in the existing pipe and tied it off.

Describe or show any material discrepancy between the location of the restored corner and that of the corner previously restored or reestablished.

NONE KNOWN.

