


21507262000

U. S. PUBLIC LAND SURVEY MONUMENT RECORD

SECTION 26 T 15 N, R 7 W, TOWN OF SHELBY

LA CROSSE COUNTY

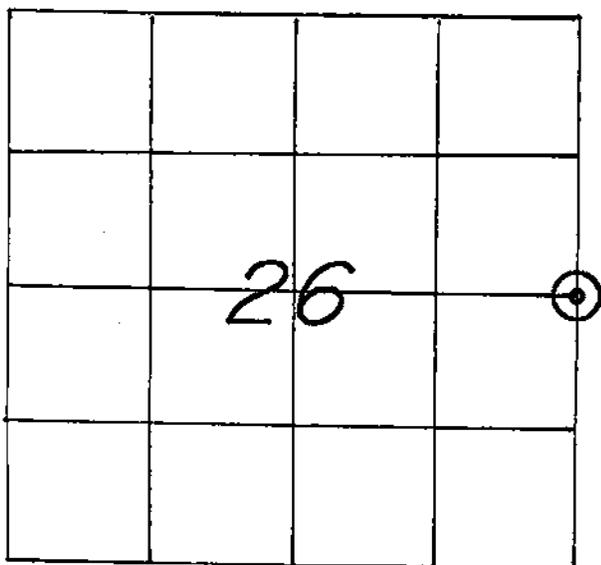

LOCATION OF LANDMARK

CREW: WILLIAM C. JUNG
 PETER F. FOLLANSBEE
 DATE: 4/14/2004

WISCONSIN COORDINATE SYSTEM
North
East
Theta Angle
Horiz. Order
Vert. Order
TYPE OF LANDMARK
1" IRON PIPE WITH PLASTIC PLUG.
BEARINGS ARE REFERENCED TO

Describe any record evidence, monument evidence, testimonial evidence or any other material evidence you considered and whether the monument was found or restored through acceptance of an obliterated evidence location.


We found a pipe at the corner that had been used as the corner in previous survey work. I accepted the pipe as the best available evidence of the original government corner and tied it off.

Describe or show any material discrepancy between the location of the restored corner and that of the corner previously restored or reestablished.

NONE KNOWN.

RECORD OF DURABLE WITNESS MONUMENTS

NO	DESCRIPTION	MAGNETIC	
		BEARING	DISTANCE
1	EXIST. 1-1/4" IRON PIPE NEAR THE EDGE OF THE WOODS	N 89° W	44.63 FT.
2	EXIST. 1-1/4" IRON PIPE SOUTHWEST OF THE ROADWAY	S 36° W	93.40 FT.
3	CENTER OF STEEL FENCE CORNER POST (N.E.-CORNER)	S 17° W	149.21 FT.
4	NUT & BOLT BY A BENT 1-1/4" IRON PIPE	S 01° W	123.35 FT.

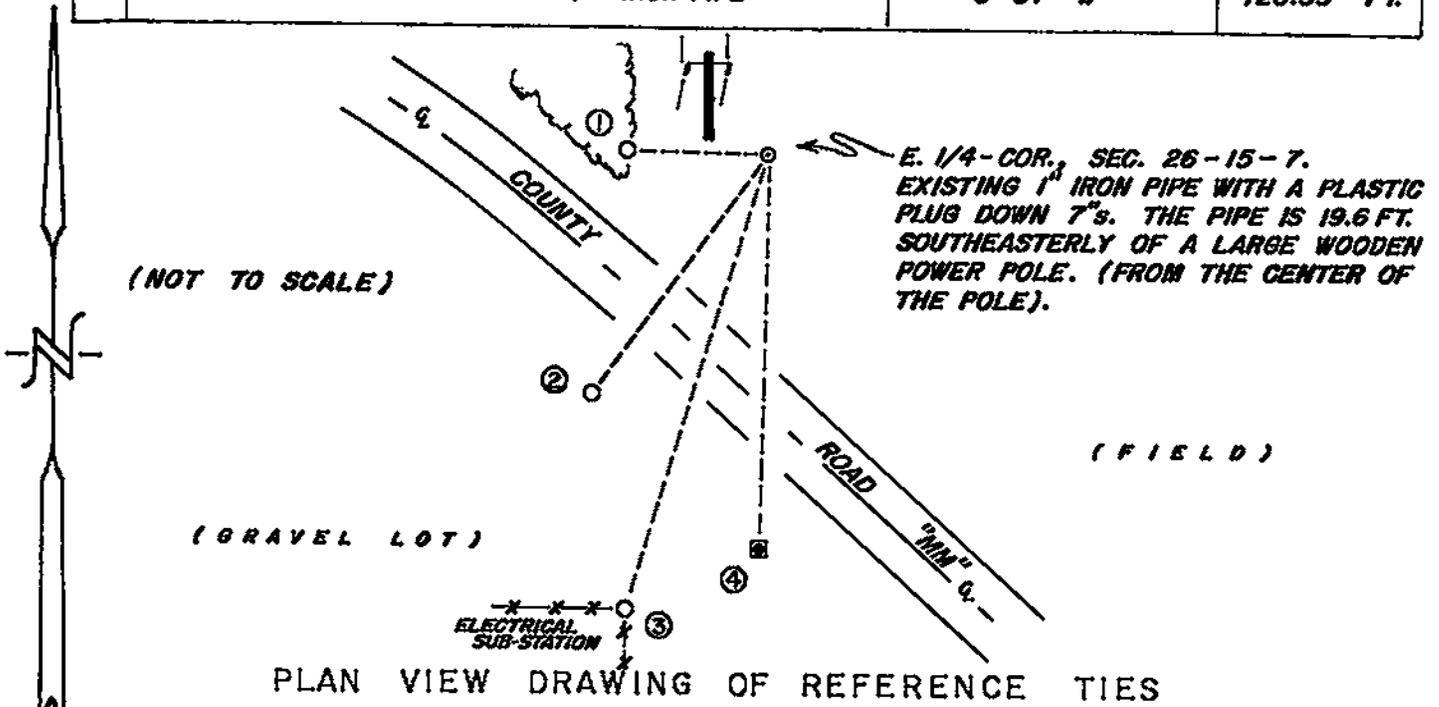


MAP SHOWING DISTANCE AND DIRECTION TO OTHER PUBLIC LAND SURVEY CORNERS USED FOR REESTABLISHING THE CORNER

I made no further section measurements at this time. The location of this corner was previously confirmed by others.

I, WILLIAM C. JUNG, COUNTY SURVEYOR
HEREBY CERTIFY THAT THE CORNER LOCATION SHOWN ON THIS RECORD
WAS DETERMINED BY ME OR UNDER MY DIRECTION AND CONTROL AND
THAT THIS U. S. PUBLIC LAND SURVEY MONUMENT RECORD IS CORRECT
AND COMPLETE TO THE BEST OF MY KNOWLEDGE AND BELIEF.

William C. Jung 1/5/05
Signature Date

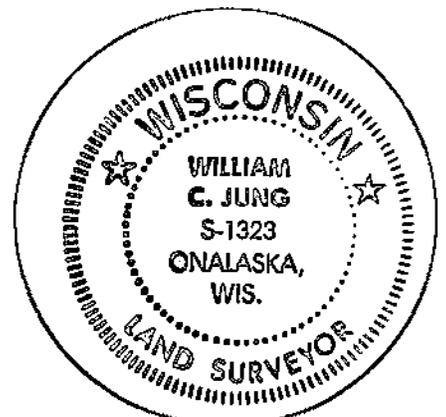

Seal