


U. S. PUBLIC LAND SURVEY MONUMENT RECORD

SECTION 27 T 15 N, R 7 W, TOWN OF SHELBY

LA CROSSE COUNTY

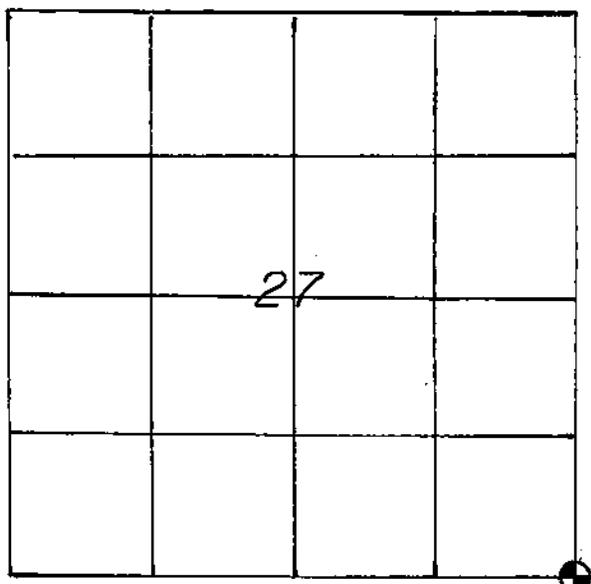

LOCATION OF LANDMARK

CREW:  
BILL JUNG, PERRY DAHL  
DATE: 9-5-86

South Zone

WISCONSIN COORDINATE SYSTEM	
North	636,413.138
East	1,685,424.352
Theta Angle	
Horiz. Order	
Vert. Order	
TYPE OF LANDMARK	
LUNDE MARKER WITH BRASS CAP	
BEARINGS ARE REFERENCED TO	
Grid North	

Describe any record evidence, monument evidence, testimonial evidence or any other material evidence you considered and whether the monument was found or restored through acceptance of an obliterated evidence location.

Greg Hofmeister set an iron pipe at a computed location. He set the pipe proportionately between the NE Corner of Section 27 and the SE Corner of Section 34, and also 3.2 chains East of the cliff as per the original notes. This would also almost agree with the Corps surveyors as they computed their corner to be about 3.27 chains East of the cliff. The Corps surveyors in my opinion did not set a final corner from their random corner. I searched for but could not find another

(continued below)


Describe or show any material discrepancy between the location of the restored corner and that of the corner previously restored or reestablished.

monument. I'm sure that the Corps surveyors had error in this rough terrain, so any difference between their computed corner and Greg's corner would have been minimal. Chalsma has used and accepted Greg's pipe as the corner. It apparently has been accepted by area land-owners too. I removed Greg's pipe and replaced it with a Lunde marker.

RECORD OF DURABLE WITNESS MONUMENTS

NO	DESCRIPTION	MAGNETIC	
		BEARING	DISTANCE
1	P.K. NAIL IN DOUBLE-BLAZED OAK, 15"	N55°W	12.53'
* 2	P.K. NAIL IN DOUBLE-BLAZED OAK, 11"	N75°W	18.07'
* 3	P.K. NAIL IN DOUBLE-BLAZED OAK, 16"	S37°W	28.3'
4	1" IRON PIPE	N88°E	32.94'
* 5	P.K. NAIL IN DOUBLE-BLAZED DEAD TREE, 8"	N80°E	31.77'


\*Hofmeister bearing tree

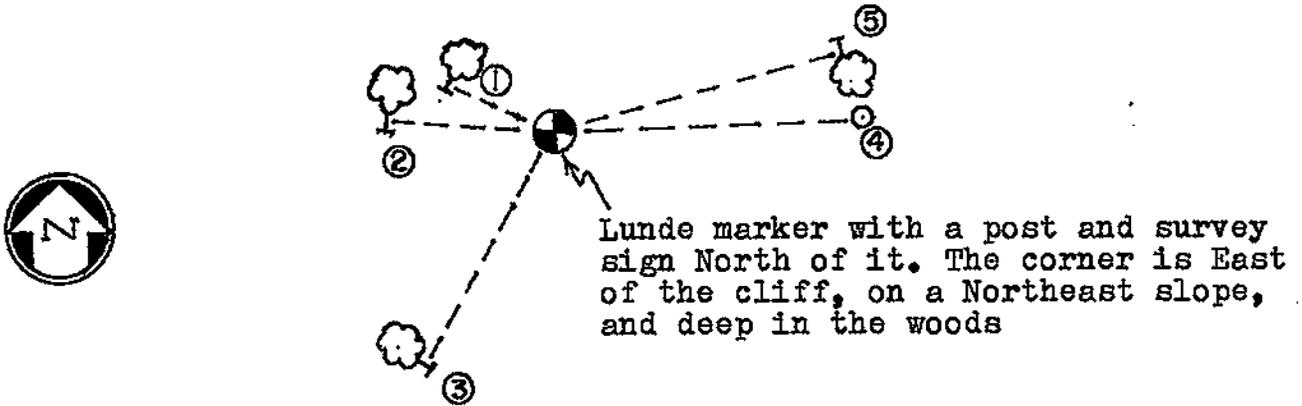

PLAN VIEW DRAWING OF REFERENCE TIES

MAP SHOWING DISTANCE AND DIRECTION TO OTHER PUBLIC LAND SURVEY CORNERS USED FOR REESTABLISHING THE CORNER (not to scale)

Grid bearing to the nearest second and grid distance to the nearest hundredth.

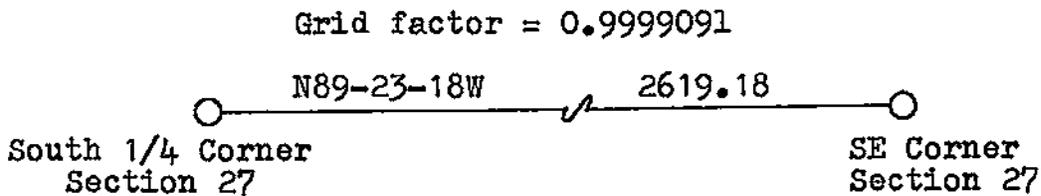

I, William C. Jung, Deputy County Surveyor,  
 HEREBY CERTIFY THAT THE CORNER LOCATION SHOWN ON THIS RECORD  
 WAS DETERMINED BY ME OR UNDER MY DIRECTION AND CONTROL AND  
 THAT THIS U. S. PUBLIC LAND SURVEY MONUMENT RECORD IS CORRECT  
 AND COMPLETE TO THE BEST OF MY KNOWLEDGE AND BELIEF.

William C. Jung Signature      October 6, 1986 Date

