


## U. S. PUBLIC LAND SURVEY MONUMENT RECORD

SECTION 27 T 15 N, R 7 W, TOWN OF SHELBY

LA CROSSE COUNTY

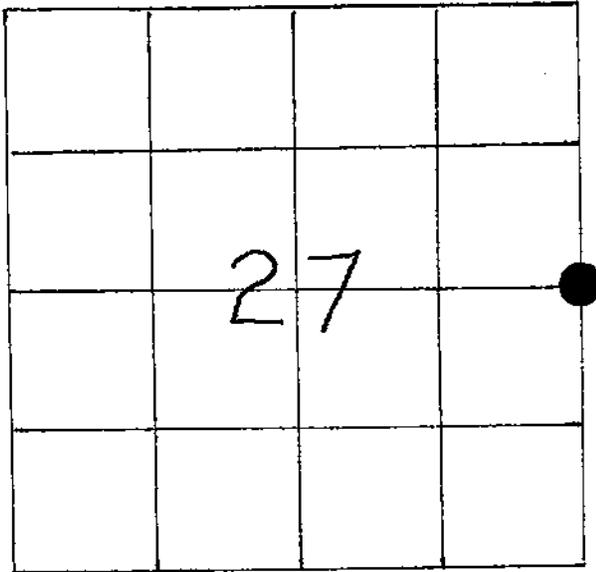

LOCATION OF LANDMARK

CREW: PAUL FAIRCHILD  
RON JASPERSON

DATE: 11/5/93

Describe any record evidence, monument evidence, testimonial evidence or any other material evidence you considered and whether the monument was found or restored through acceptance of an obliterated evidence location.

NONE KNOWN

CORNER SET BY SINGLE PROPORTIONATE MEASURE

Describe or show any material discrepancy between the location of the restored corner and that of the corner previously restored or reestablished.

NONE KNOWN

## WISCONSIN COORDINATE SYSTEM

North

East

Theta Angle

Horiz. Order

Vert. Order


## TYPE OF LANDMARK

R/R SPIKE

BEARINGS ARE REFERENCED TO  
ASSUMED SOUTH SECTION LINE  
R/A N89°-23'-18"W SEC 27-15-7


RECORD OF DURABLE WITNESS MONUMENTS

NO	DESCRIPTION	BEARING	DISTANCE
1	PK IN CORNER FENCE POST	S76°05'23" E	145.38'
2	EDGE OF CONC. @ E OF BRIDGE	S46°11'55" E	641.99'
3	PK IN SINGLE BLAZED 10" CEDAR	S32°15'10" W	108.98'
4	BASE OF POST FOR R/W SIGN	N32°37'27" W	166.58'

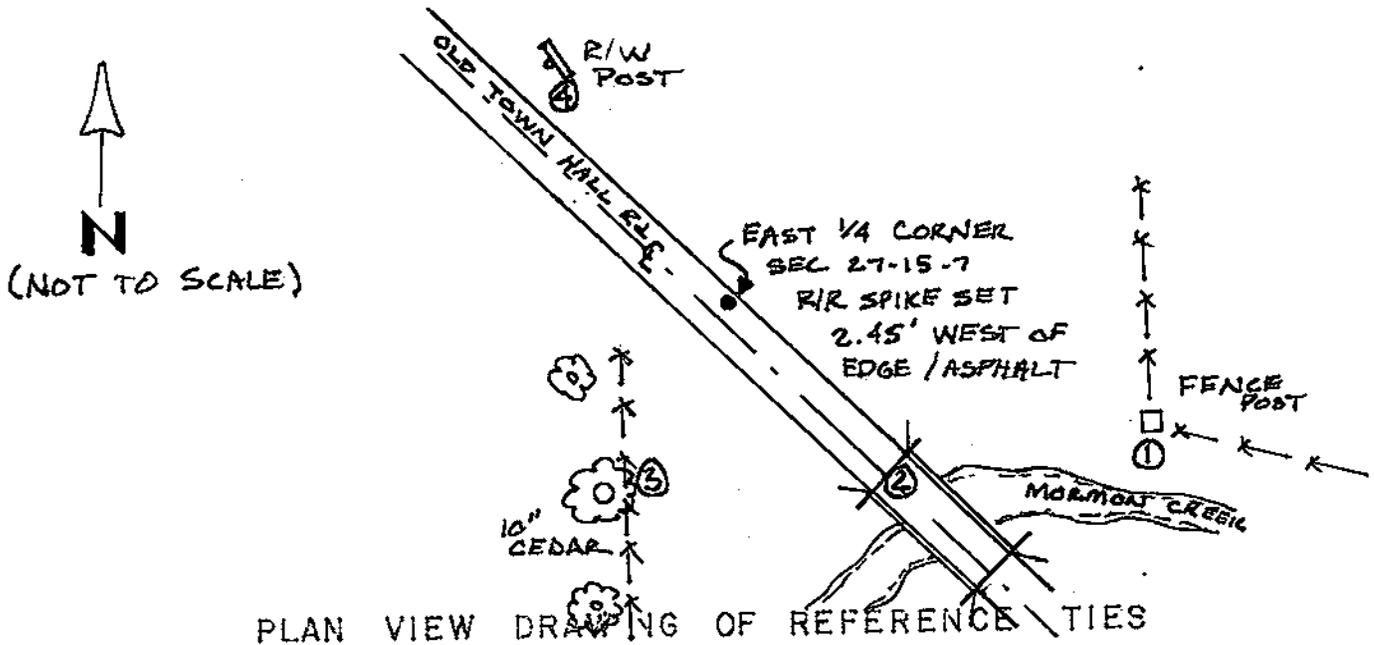

PLAN VIEW DRAWING OF REFERENCE TIES

MAP SHOWING DISTANCE AND DIRECTION TO OTHER PUBLIC LAND SURVEY CORNERS USED FOR REESTABLISHING THE CORNER

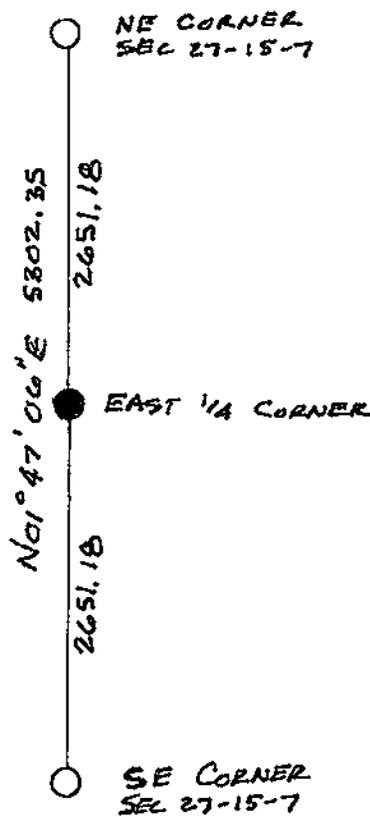

I, PAUL E. FAIRCHILD  
 HEREBY CERTIFY THAT THE CORNER LOCATION SHOWN ON THIS RECORD  
 WAS DETERMINED BY ME OR UNDER MY DIRECTION AND CONTROL AND  
 THAT THIS U. S. PUBLIC LAND SURVEY MONUMENT RECORD IS CORRECT  
 AND COMPLETE TO THE BEST OF MY KNOWLEDGE AND BELIEF.

Paul E. Fairchild 1/19/93  
 Signature Date

