


21507280000

U. S. PUBLIC LAND SURVEY MONUMENT RECORD

SECTION 27 T 15 N, R 7 W, TOWN OF Shelby

LA CROSSE COUNTY

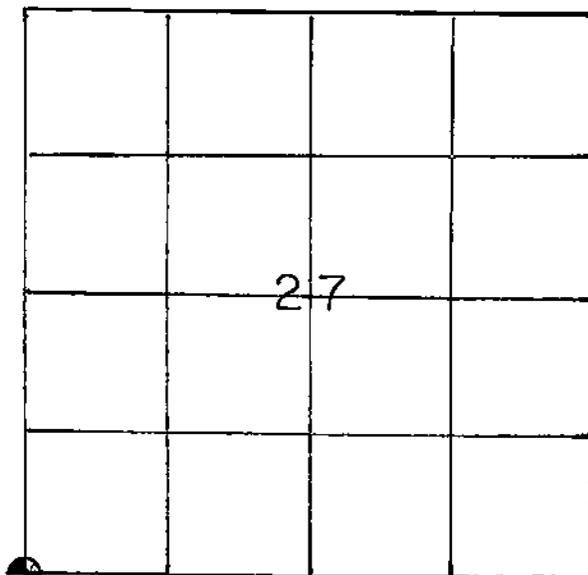

LOCATION OF LANDMARK

Crew: Bill Jung
Perry Dahl

11/26/86

Describe any record evidence, monument evidence, testimonial evidence or any other material evidence you considered and whether the monument was found or restored through acceptance of an obliterated evidence location.

I set the corner at a computed location as per the Corps of Engineers survey notes. They set the corner 2640 feet East of an existing stone at the South 1/4 Corner of Section 28 (the stone was 2 feet North of a fence corner) and proportionately between the section corners to the North and South. This 2640 feet is the same as the original notes. I looked for but could not find the stone at the South 1/4 Corner of Section 28. I do not believe that the Corps surveyors ever adjusted their survey point and set a permanent marker at the Southwest Corner of Section 27.

(continued below)

Describe or show any material discrepancy between the location of the restored corner and that of the corner previously restored or reestablished.

N/A

There was a lot of evidence available to the Corps surveyors as they surveyed in the surrounding sections. I believe their computed location to be correct. Considering the terrain at the time of their survey, I believe that their survey error would have been minimal in the flats. I computed the location of this corner after computing off of Corps markers along the North line of Section 27. I set an iron pipe at this corner because of periodic flooding* I do not believe that the Corps surveyors ever set a final monument. I could not find one.

*The pipe is a witness corner. The actual corner falls in a tree.

South Zone

WISCONSIN COORDINATE SYSTEM

North 636,469.281

East 1,680,165.691

Theta Angle

Horiz. Order

Vert. Order

TYPE OF LANDMARK TREE!! -and-
Set an iron pipe in the bottoms *

BEARINGS ARE REFERENCED TO

Grid North


* The iron pipe is a witness corner and is 7' from the actual corner which is a 22" tree.

RECORD OF DURABLE WITNESS MONUMENTS
MAGNETIC


To the P.K. nail in
22" tree @ the corner

NO	DESCRIPTION	BEARING	DISTANCE
1	P.K. nail in double-blazed 14" bearing tree	N12°W	43.43
2	P.K. nail in double-blazed 14" bearing tree	N45°W	36.27
3	Set a 1½" pipe, up 1', as a witness pipe, and set a steel post West of it.	N35°E	6.85
4	P.K. nail in double-blazed 12" bearing tree	S80°E	56.01

Note: This areas under water during periods of flooding.

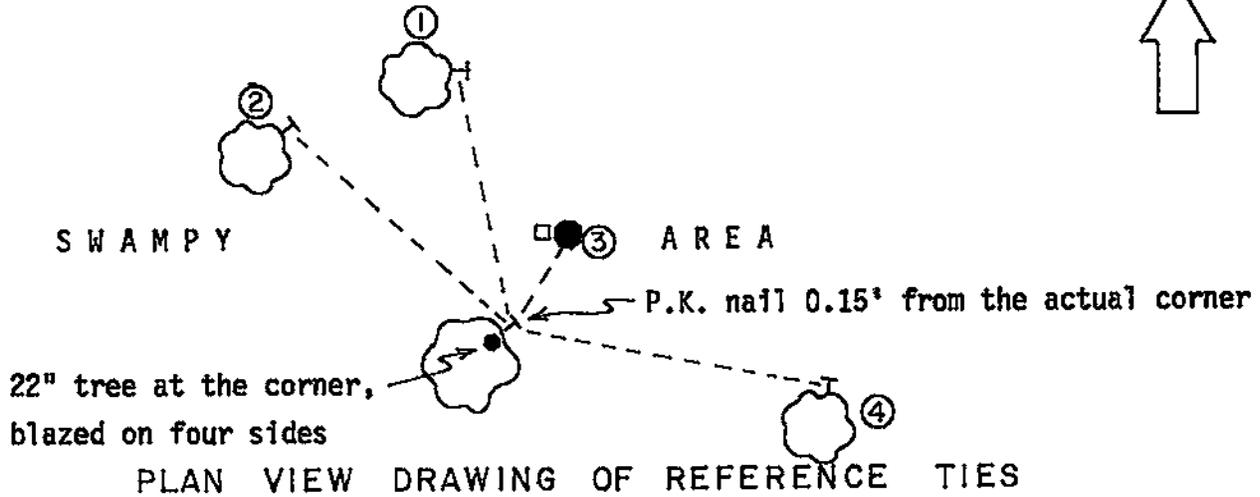

MAP SHOWING DISTANCE AND DIRECTION TO OTHER PUBLIC LAND SURVEY CORNERS USED FOR REESTABLISHING THE CORNER

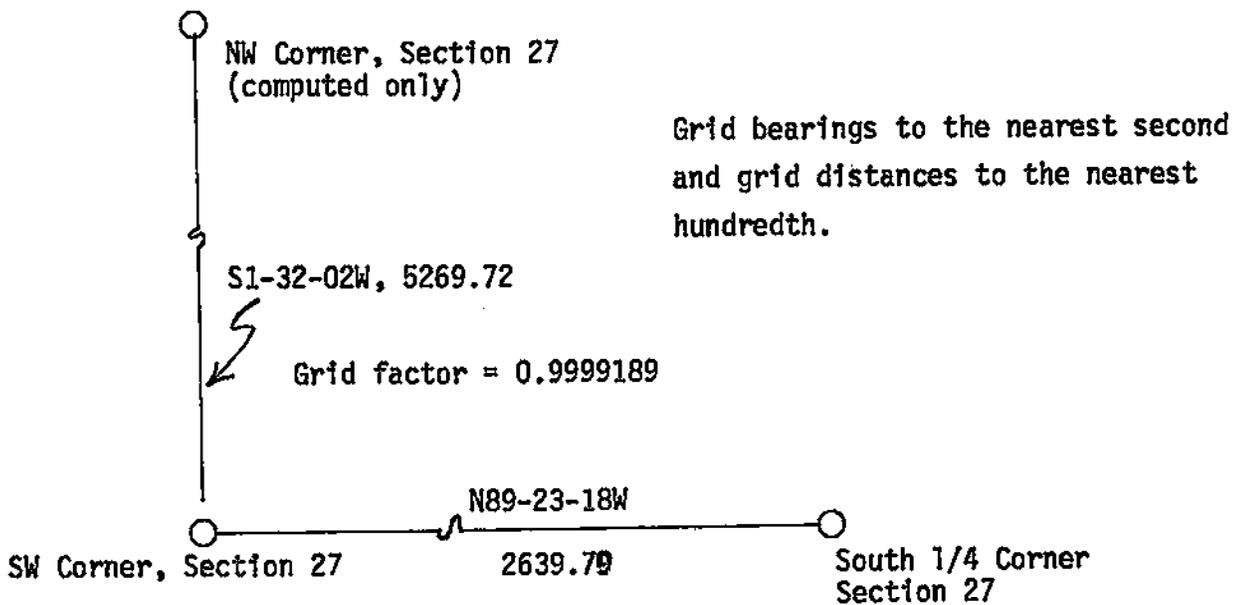


(not to scale)

I, William C. Jung, Deputy County Surveyor,
HEREBY CERTIFY THAT THE CORNER LOCATION SHOWN ON THIS RECORD
WAS DETERMINED BY ME OR UNDER MY DIRECTION AND CONTROL AND
THAT THIS U. S. PUBLIC LAND SURVEY MONUMENT RECORD IS CORRECT
AND COMPLETE TO THE BEST OF MY KNOWLEDGE AND BELIEF.

William C. Jung
Signature

November 26, 1986
Date

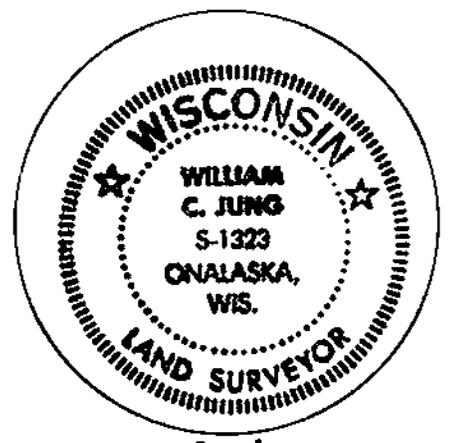

Seal