


U. S. PUBLIC LAND SURVEY MONUMENT RECORD

SECTION 36 T 15 N, R 7 W, TOWN OF SHELBY

LA CROSSE COUNTY

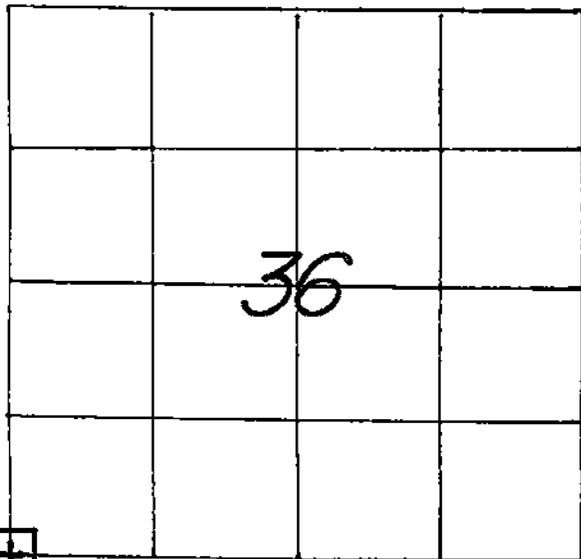

LOCATION OF LANDMARK

CREW: WILLIAM G. JUNG  
 PETER F. FOLLANSBEE  
 DATE: 3/14/2007

WISCONSIN COORDINATE SYSTEM

North

East

Theta Angle

Horiz. Order

Vert. Order

TYPE OF LANDMARK

*EXISTING STONE MONUMENT.*

BEARINGS ARE REFERENCED TO

*ASSUMED NORTH AS PER SECTION DATA.*

Describe any record evidence, monument evidence, testimonial evidence or any other material evidence you considered and whether the monument was found or restored through acceptance of an obliterated evidence location.

I again found the stone that I had found in 1986 and made new ties.


Describe or show any material discrepancy between the location of the restored corner and that of the corner previously restored or reestablished.

**NONE KNOWN.**

RECORD OF DURABLE WITNESS MONUMENTS


MAGNETIC

NO	DESCRIPTION	BEARING	DISTANCE
1	SET A NAIL IN S.E.-SIDE OF A 6" ELM	S 59° W	75.88 FT.
2	EX. NAIL IN N.-SIDE OF A 16" ELM	S 89° W	77.78 FT.
3	SET A P.K. NAIL IN S.E.-COR. OF GARAGE ADD.'N	N 81° W	8.97 FT.
4	EX. NAIL IN S.-SIDE OF AN 11-1/2" ELM	N 73° E	27.24 FT.

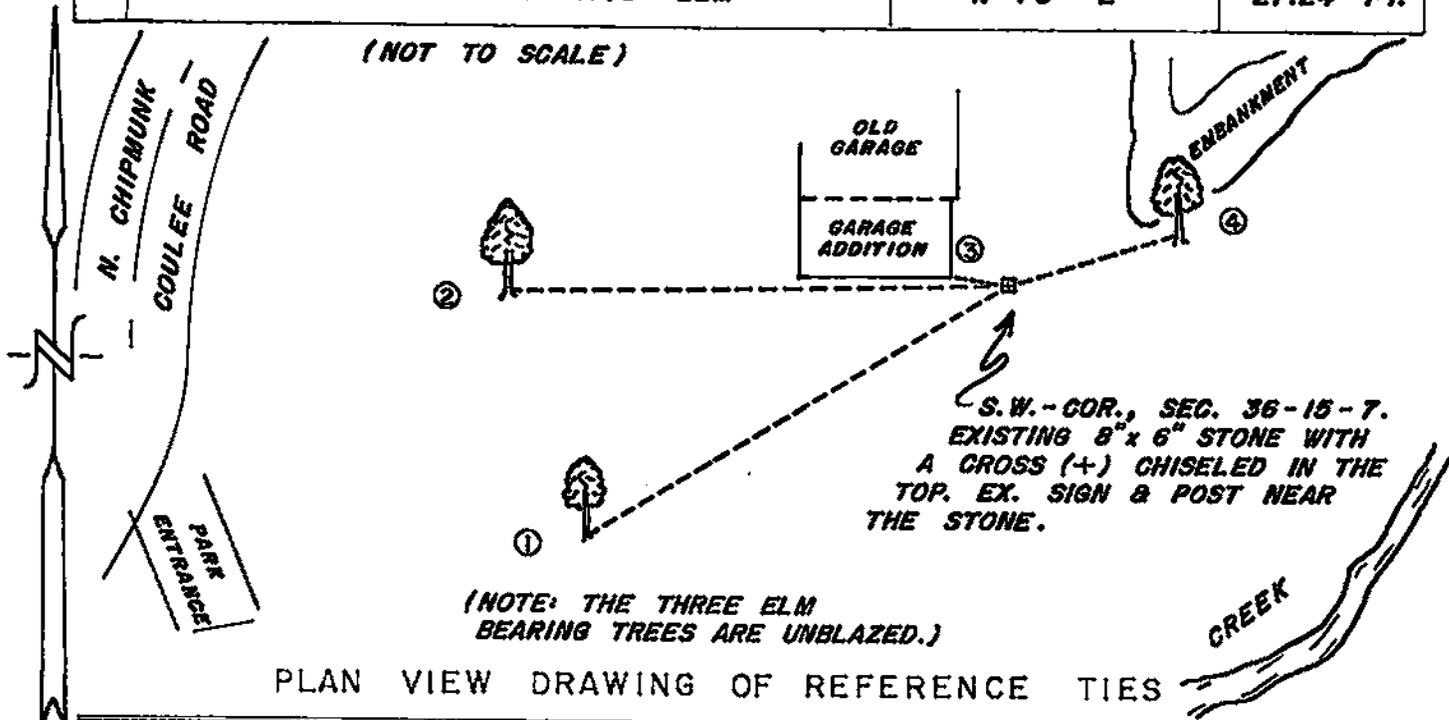

MAP SHOWING DISTANCE AND DIRECTION TO OTHER PUBLIC LAND SURVEY CORNERS USED FOR REESTABLISHING THE CORNER

(ASSUMED BEARINGS)  
(NOT TO SCALE)

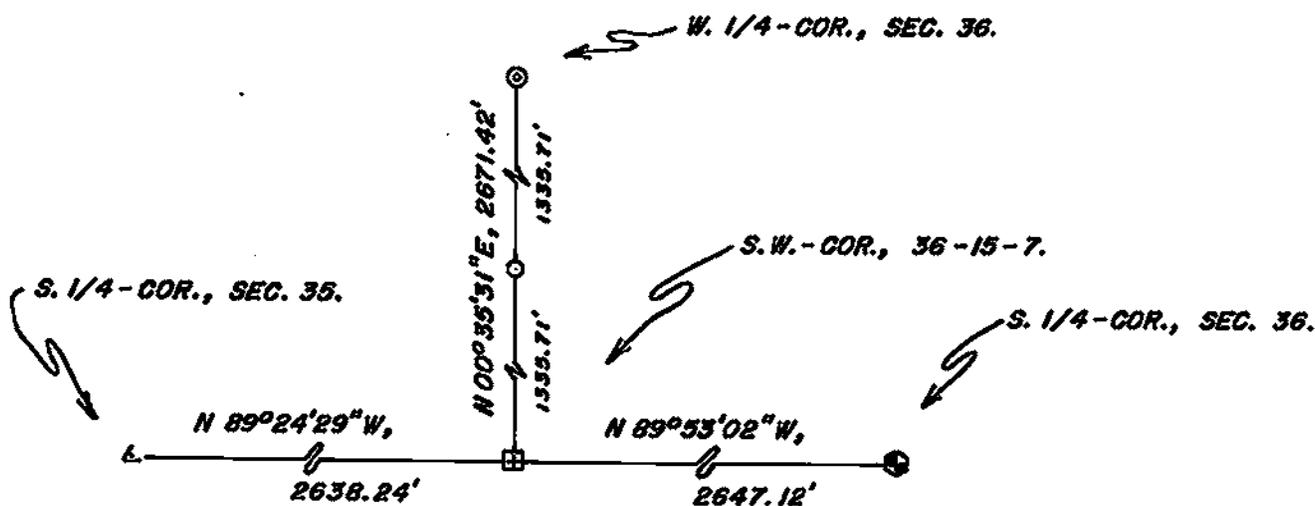

I, WILLIAM C. JUNG, COUNTY SURVEYOR  
HEREBY CERTIFY THAT THE CORNER LOCATION SHOWN ON THIS RECORD  
WAS DETERMINED BY ME OR UNDER MY DIRECTION AND CONTROL AND  
THAT THIS U. S. PUBLIC LAND SURVEY MONUMENT RECORD IS CORRECT  
AND COMPLETE TO THE BEST OF MY KNOWLEDGE AND BELIEF.

*William C. Jung*  
Signature

4/17/07  
Date




Seal

U. S. PUBLIC LAND SURVEY MONUMENT RECORD

SECTION 35 T 15 N, R 7 W, TOWN OF SHELBY

LA CROSSE COUNTY

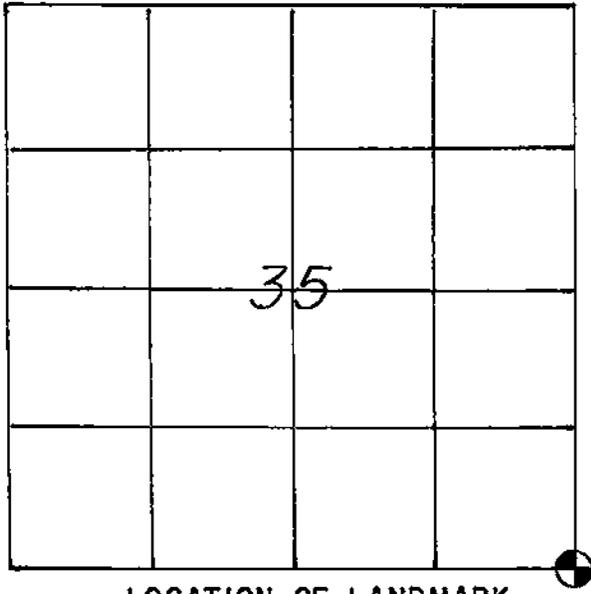

LOCATION OF LANDMARK

CREW: BILL JUNG  
PERRY DAHL

DATE: 6-26-86

Describe any record evidence, monument evidence, testimonial evidence or any other material evidence you considered and whether the monument was found or restored through acceptance of an obliterated evidence location.

I found a stone at the corner and accepted it as the best available evidence of the original government corner position.

Describe or show any material discrepancy between the location of the restored corner and that of the corner previously restored or reestablished.

None known.

WISCONSIN COORDINATE SYSTEM
North
East
Theta Angle
Horiz. Order
Vert. Order
TYPE OF LANDMARK
STONE MONUMENT
BEARINGS ARE REFERENCED TO
Assumed




FOR VERNON COUNTY, WISCONSIN

31

Note: This form is intended and designed to fulfill all requirements of Wisconsin Administrative Code, Chapter AE-7.08, U.S. Public Land Survey Monument Record (3)(a)(b)(c)(d)(e)(f)(g)(h)(i). Use additional sheets if necessary.

(a) The One Quarter corner common to Sections 2, 1, 36, 38

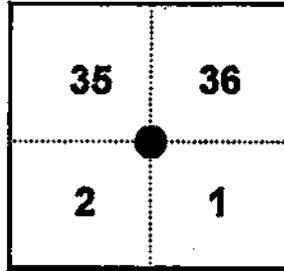

Township(s) 14.15 North, Range(s) 7 West

Vernon County Coordinates: N 205158.642

Datum: \_\_\_\_\_ E 630273.654

(b)(f)(h) Description of monument found at this corner and if it was accepted, state all evidence (material, testimonial, occupational, plats records, other monuments) used as a basis for accepting. If not accepted or nothing was found, state evidence used as basis for establishing location and what was set. If re-established through lost corner proportionate methods, indicate all monuments, distances and directions used.


1846-1847 - Alfred L. Brown established original corner location 88.59 chains North of the Southeast corner of Section 2.

03-02-1997 - William C. Jung Found a stone at the corner and accepted it as the best available evidence of the original corner position.

12-01-1998 - Found limestone monument as per William C. Jung tiesheet

(c)(d)(e) Plan view of corner with ties to at least four (4) witness monuments. If in disagreement with previously established corner, show the distances between the two corners and also indicate ties to disputed corner.

NORTH

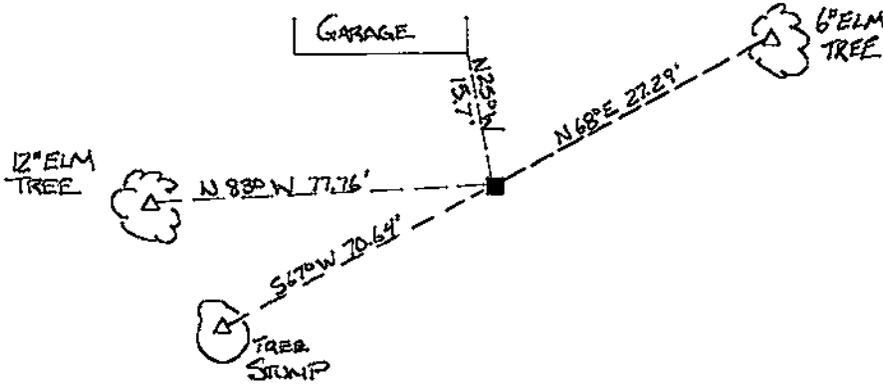

Not To Scale

- = Set Vernon County Monument (Iron Pipe with 3" brass cap)
- △ = Set 60d spike

(f) Certify that the corner location on this record was determined by me or under my direction and control and that this U.S. Public Land survey Monument Record is correct and complete to the best of my knowledge and belief.

[Signature]  
Signature \_\_\_\_\_ Date 12/30/98



Filed for record in Vernon County Surveyor's Office on \_\_\_\_\_ INDEX NO. \_\_\_\_\_

39