


21507352000

U. S. PUBLIC LAND SURVEY MONUMENT RECORD

SECTION 36 T 15 N, R 7 W, TOWN OF SHELBY
 LA CROSSE COUNTY

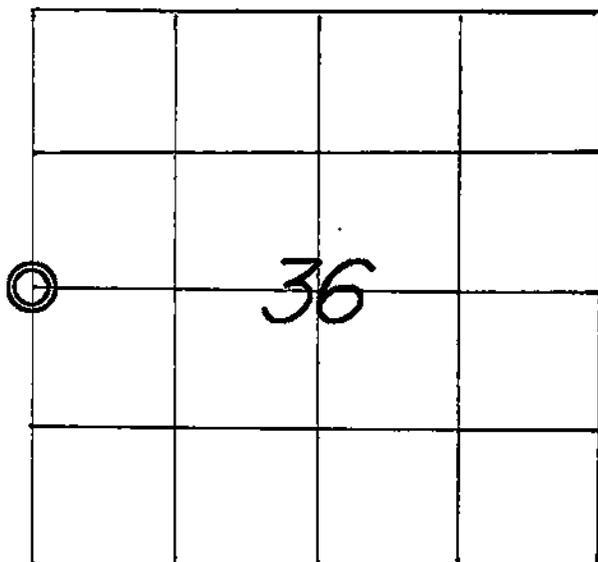

WISCONSIN COORDINATE SYSTEM
North
East
Theta Angle
Horiz. Order
Vert. Order
TYPE OF LANDMARK
<i>IRON BAR WITH RED PLASTIC CAP.</i>
BEARINGS ARE REFERENCED TO

LOCATION OF LANDMARK
 CREW: WILLIAM G. JUNG
 PETER F. FOLLANSBEE
 DATE: 6/10/2002

Describe any record evidence, monument evidence, testimonial evidence or any other material evidence you considered and whether the monument was found or restored through acceptance of an obliterated evidence location.


Rob Lampman set an iron bar at this corner in 1993. We took new ties as all of Lampman's tie points were gone.

Describe or show any material discrepancy between the location of the restored corner and that of the corner previously restored or reestablished.

NONE KNOWN.

RECORD OF DURABLE WITNESS MONUMENTS


NO	DESCRIPTION	MAGNETIC BEARING	COMPUTED DISTANCE
1	SET AN 18" ROUNDHEAD BOLT IN CENTERLINE ±	N. 'EASTERLY ±	COMR'D=111.64'
2	SET AN 18" ROUNDHEAD BOLT IN CENTERLINE ±	S 78° E (MAG.)	49.34 FT.
3	SET AN 18" ROUNDHEAD BOLT IN CENTERLINE ±	S. 'EASTERLY ±	COMR'D= 70.07'
4	SET AN 18" ROUNDHEAD BOLT IN CENTERLINE ±	S. 'EASTERLY ±	COMR'D=111.26'

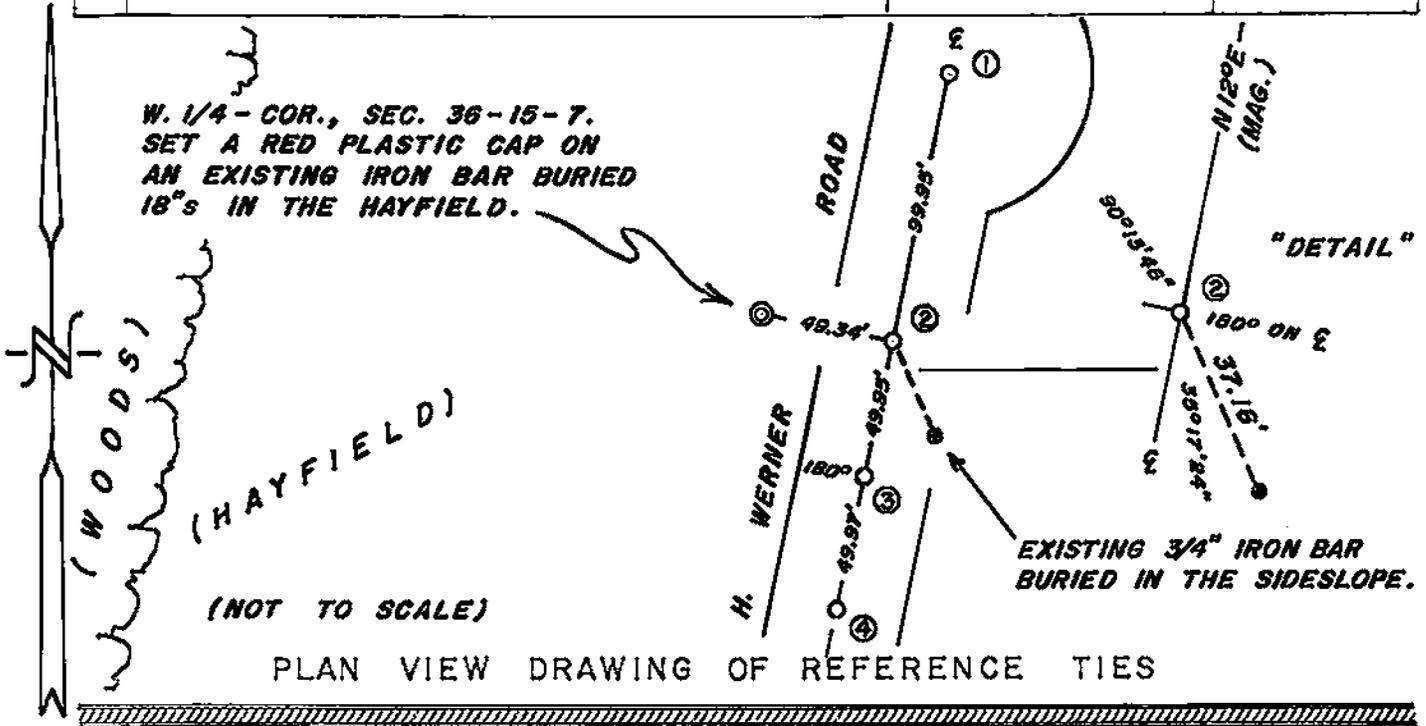

MAP SHOWING DISTANCE AND DIRECTION TO OTHER PUBLIC LAND SURVEY CORNERS USED FOR REESTABLISHING THE CORNER

(LAMPMAN & ASSOCIATES MEASUREMENTS)

(NOT TO SCALE)

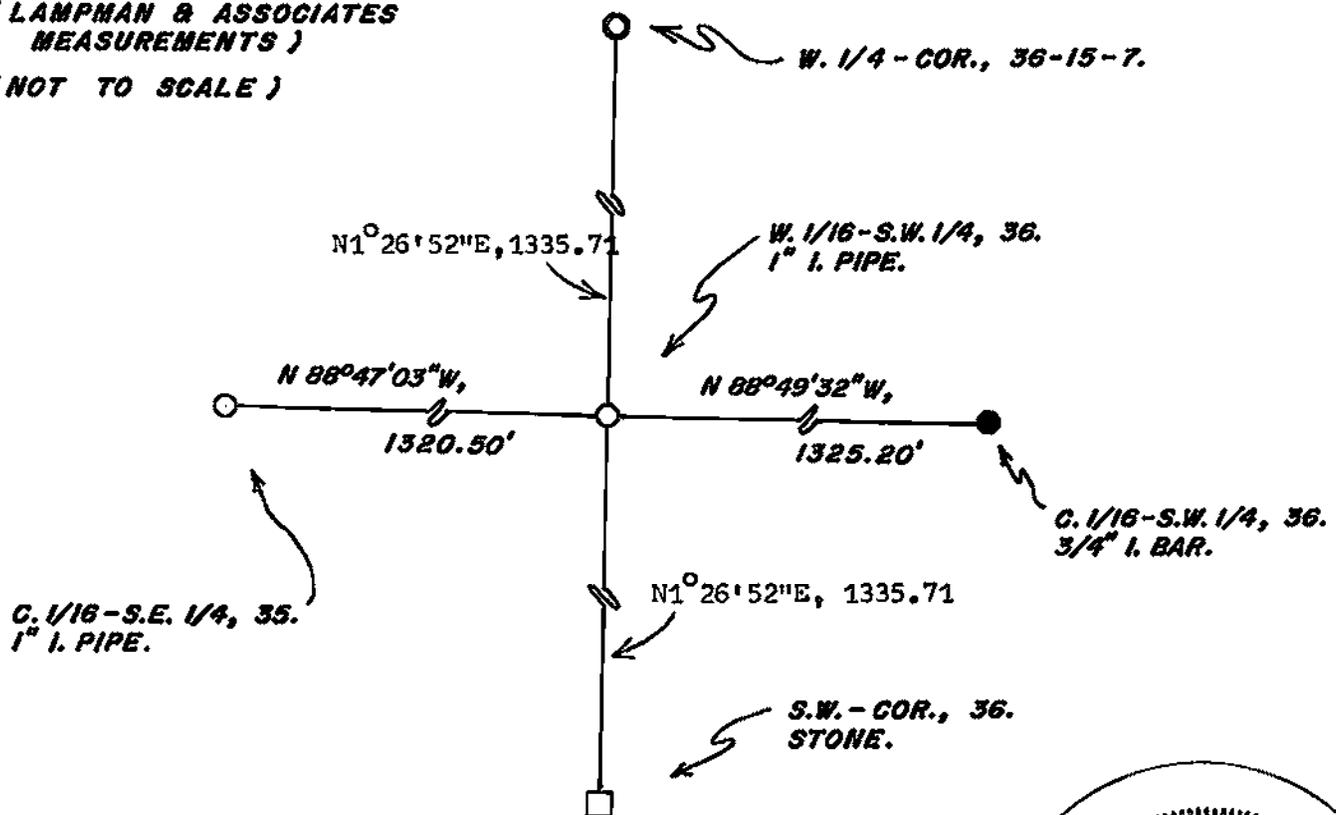

I, WILLIAM C. JUNG, COUNTY SURVEYOR
HEREBY CERTIFY THAT THE CORNER LOCATION SHOWN ON THIS RECORD WAS DETERMINED BY ME OR UNDER MY DIRECTION AND CONTROL AND THAT THIS U. S. PUBLIC LAND SURVEY MONUMENT RECORD IS CORRECT AND COMPLETE TO THE BEST OF MY KNOWLEDGE AND BELIEF.

William C. Jung 6/27/02
Signature Date



Seal



CERTIFIED LAND CORNER

STATE OF WISCONSIN)
 COUNTY OF LA CROSSE) S.S.

CERTIFICATE

I, ROBERT M. LAMPMAN, do hereby certify that on the 13th day of APRIL 1993, I found ~~(evidence)~~ (no evidence) of the N 1/4 corner of SECTION 36, T15 N, R7 W, Fourth Principal Meridian, and I re-established said corner according to the Wisconsin Statutes as shown and described hereon.

Dated this 14th day of APRIL 1993
ROBERT M. LAMPMAN R.L.S. S-1296

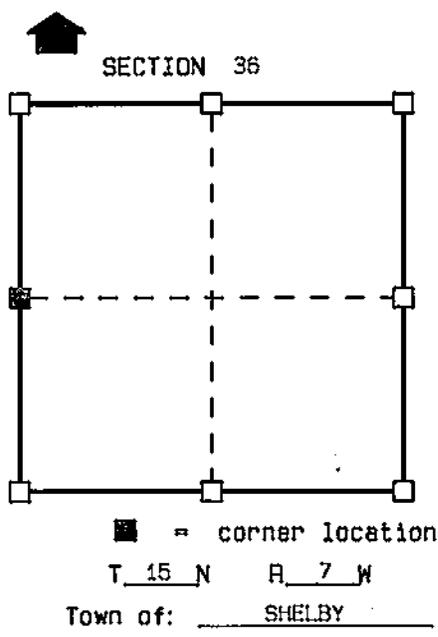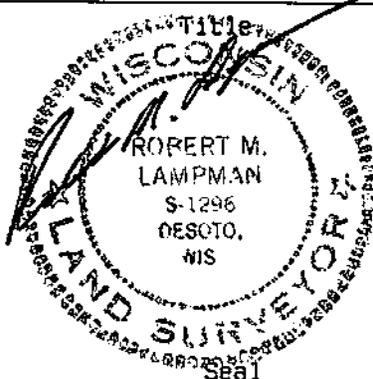

History of original corner establishment:

ORIGINAL CORNER ESTABLISHED BY BROWN IN 1846.

Description of corner evidence found:

ESTABLISHED CORNER ON LINE BETWEEN AND AT EQUAL DISTANCE FROM EXISTING MONUMENTS AT THE NORTHWEST AND SOUTHWEST CORNERS OF SECTION 36.


Description of corner and witness monuments, references and accessories used to perpetuate the original or re-established location of this corner:

Witnesses to corner location:

Sketch:

- ROBERT M. LAMPMAN
- BRADY V. HARDING
- JESSICA A. ZAMOR

NOTE:
 BLAZED AND SET SPIKE AT
 BASE OF ALL BEARING TREES

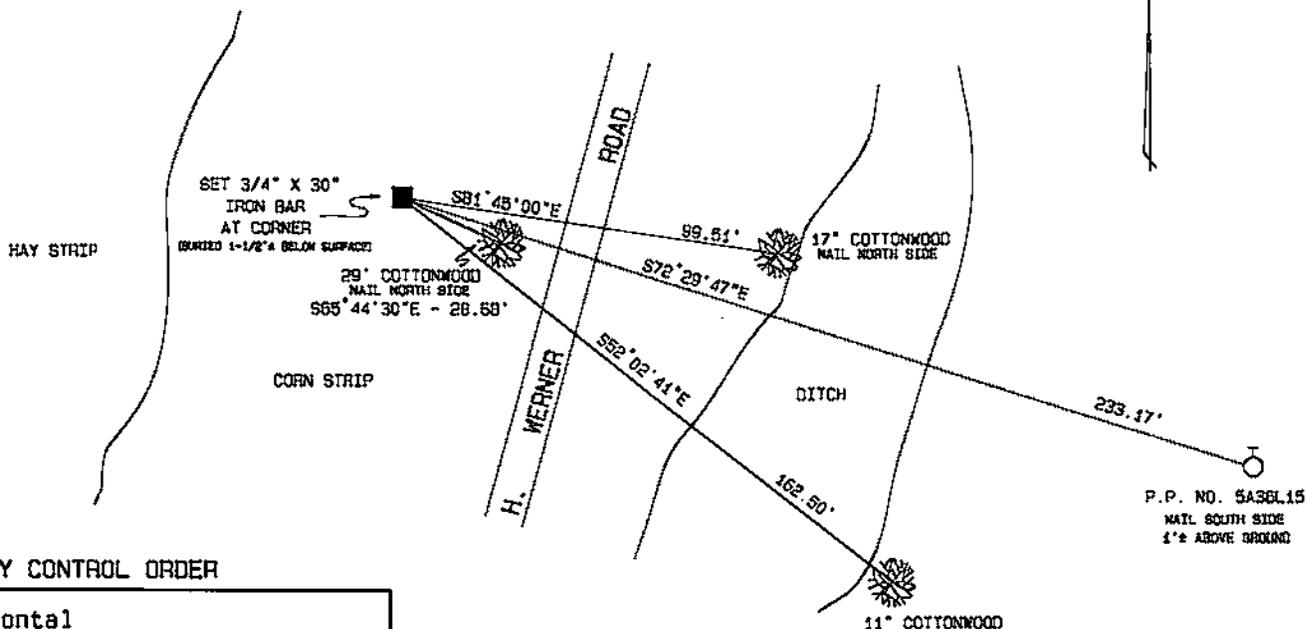

SURVEY CONTROL ORDER

Horizontal
Vertical

WISCONSIN COORDINATE SYSTEM

Corner	East (X)	North (Y)	Elevation (Z)	Zone
Control Sta. Name				

