


U. S. PUBLIC LAND SURVEY MONUMENT RECORD

SECTION 36 T 15 N, R 7 W, TOWN OF SHELBY

LA CROSSE COUNTY

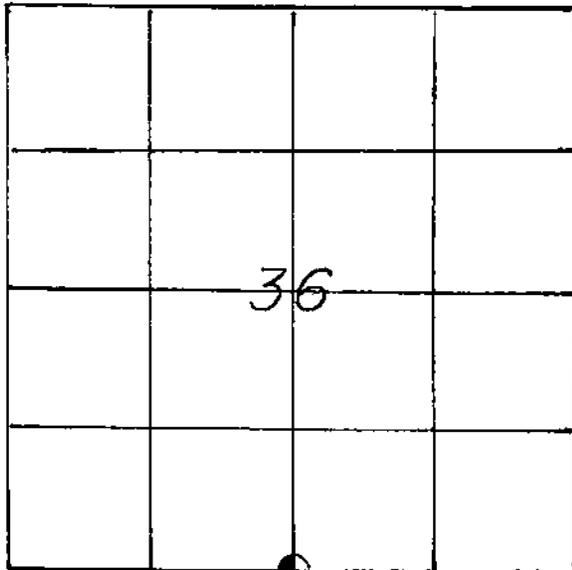

LOCATION OF LANDMARK

CREW:
BILL JUNG
PERRY DAHL

DATE: 8-15-86

Describe any record evidence, monument evidence, testimonial evidence or any other material evidence you considered and whether the monument was found or restored through acceptance of an obliterated evidence location.

I set the corner on line with the SW corner and the S1/16SW corner, and at a distance from said S1/16SW corner equal to the distance between the SW and S1/16SW. I feel that this location fits the old Town Line and other evidence found very well. This corner was lost. I could find no evidence of it. I set a brass capped Lunde marker at the corner.

Describe or show any material discrepancy between the location of the restored corner and that of the corner previously restored or reestablished.

None known.

WISCONSIN COORDINATE SYSTEM

North

East

Theta Angle

Horiz. Order

Vert. Order

TYPE OF LANDMARK

BRASS CAPPED LUNDE MARKER

BEARINGS ARE REFERENCED TO

Assumed

