


21607340020

## U. S. PUBLIC LAND SURVEY MONUMENT RECORD

SECTION 3 T 15 N, R 7 W, TOWN OF SHELBY

LA CROSSE COUNTY

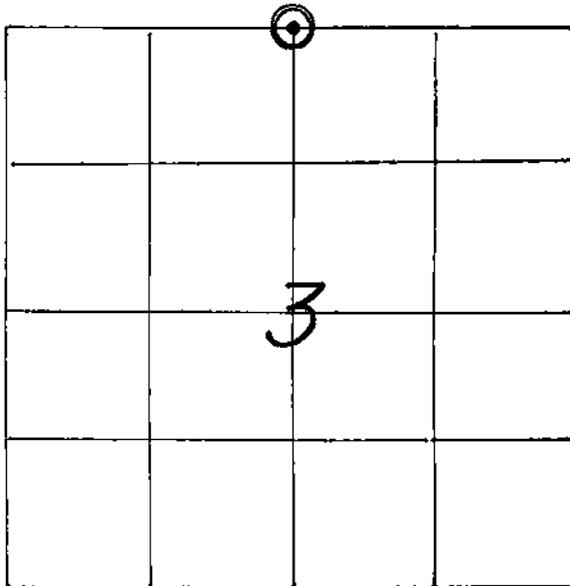

LOCATION OF LANDMARK

CREW: *WILLIAM C. JUNG*  
*PETER F. FOLLANSBEE*  
 DATE: *4/21/1998*

WISCONSIN COORDINATE SYSTEM

North

East

Theta Angle

Horiz. Order

Vert. Order

TYPE OF LANDMARK

*IRON ROD IN CENTER OF A CLAY TILE PIPE.*

BEARINGS ARE REFERENCED TO

Describe any record evidence, monument evidence, testimonial evidence or any other material evidence you considered and whether the monument was found or restored through acceptance of an obliterated evidence location.

The old records indicate that a sewer pipe was set at this corner by measuring from the stumps of the old bearing trees. Other surveys call for a tile or 6" ceramic pipe at this corner. I found a 6" old clay tile pipe at the corner and plumbed it up. I then set a 1/2"x6.5'+ rod in the center of the pipe.

Describe or show any material discrepancy between the location of the restored corner and that of the corner previously restored or reestablished.

*NONE KNOWN.*

