


U. S. PUBLIC LAND SURVEY MONUMENT RECORD

SECTION 2 T 15 N, R 7 W, TOWN OF Shelby

LA CROSSE COUNTY

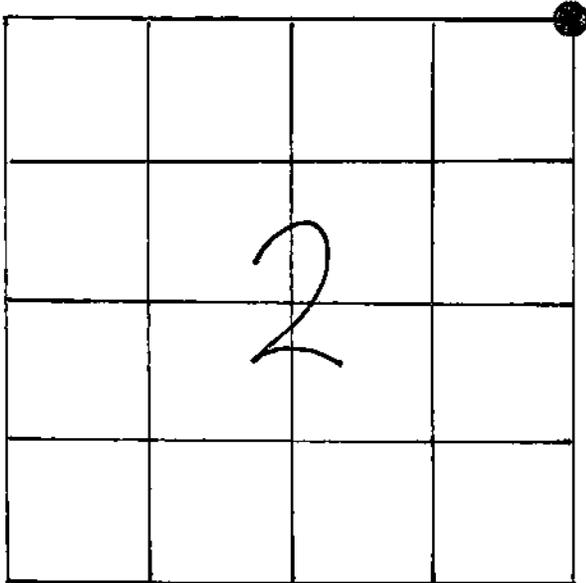

LOCATION OF LANDMARK

Crew: William C. Jung

Date: May 4, 1992

Describe any record evidence, monument evidence, testimonial evidence or any other material evidence you considered and whether the monument was found or restored through acceptance of an obliterated evidence location.

Greg Hofmeister set a Berntsen marker at this corner. I accepted his corner as the best available evidence of the original government corner position.

Describe or show any material discrepancy between the location of the restored corner and that of the corner previously restored or reestablished.

21.12 feet to the South of the Berntsen is a 1 $\frac{1}{4}$ " iron pipe. Watts calls this the corner. However, I believe that this pipe was merely a Hofmeister survey point, not his final corner.

WISCONSIN COORDINATE SYSTEM

North

East

Theta Angle

Horiz. Order

Vert. Order


TYPE OF LANDMARK

Existing Berntsen marker

BEARINGS ARE REFERENCED TO

RECORD OF DURABLE WITNESS MONUMENTS
Magnetic

NO	DESCRIPTION	BEARING	DISTANCE
1	Ex. 1 1/4" iron pipe in concrete, up 7"	S1°E	21.12
2	P.K. nail in double blazed 5" elm	S50°E	13.19
3	" 6" Norway	S52°E	slope=55.27
4	" 11" double box elder	N52°E	slope=11.83

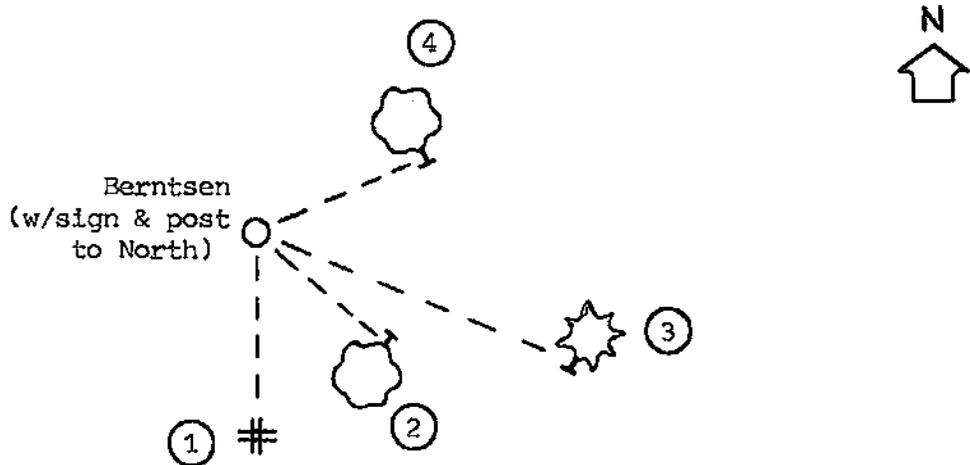

(not to scale)

PLAN VIEW DRAWING OF REFERENCE TIES




MAP SHOWING DISTANCE AND DIRECTION TO OTHER PUBLIC LAND SURVEY CORNERS USED FOR REESTABLISHING THE CORNER

No section measurements made by me at this time.

I, William C. Jung, Deputy County Surveyor,
HEREBY CERTIFY THAT THE CORNER LOCATION SHOWN ON THIS RECORD WAS DETERMINED BY ME OR UNDER MY DIRECTION AND CONTROL AND THAT THIS U. S. PUBLIC LAND SURVEY MONUMENT RECORD IS CORRECT AND COMPLETE TO THE BEST OF MY KNOWLEDGE AND BELIEF.

William C. Jung
Signature

June 9, 1992
Date

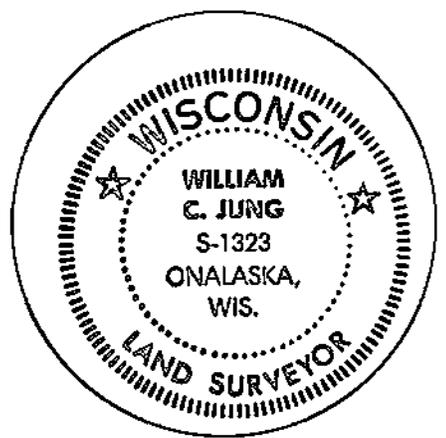


Seal

U. S. PUBLIC LAND SURVEY MONUMENT RECORD

SECTION 2 T 15 N, R 7 W, TOWN OF SHELBY

LA CROSSE COUNTY

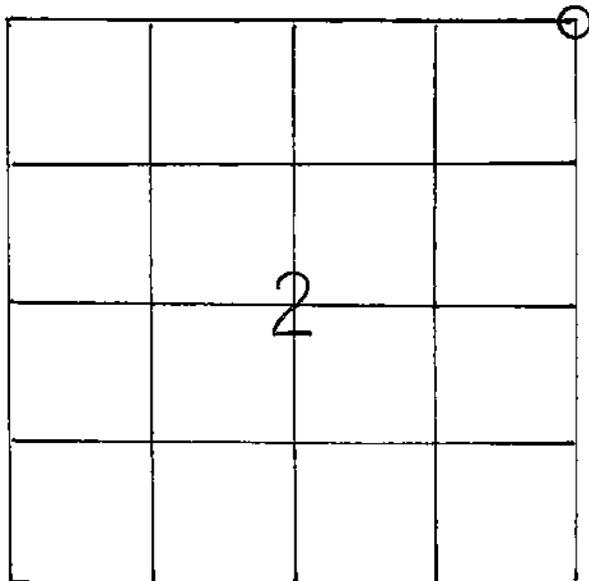

LOCATION OF LANDMARK

WISCONSIN COORDINATE SYSTEM
North
East
Theta Angle
Horiz. Order
Vert. Order
TYPE OF LANDMARK
BEARINGS ARE REFERENCED TO


Describe any record evidence, monument evidence, testimonial evidence or any other material evidence you considered and whether the monument was found or restored through acceptance of an obliterated evidence location.

Found 1 Inch Iron Pipe set by Gregory J. Hofmeister.

Describe or show any material discrepancy between the location of the restored corner and that of the corner previously restored or reestablished.

RECORD OF DURABLE WITNESS MONUMENTS

NO	DESCRIPTION	BEARING	DISTANCE
1	P.K. Nail in 10" Elm.		15.00'
2	P.K. Nail in Stump.		0.77'
3			
4			

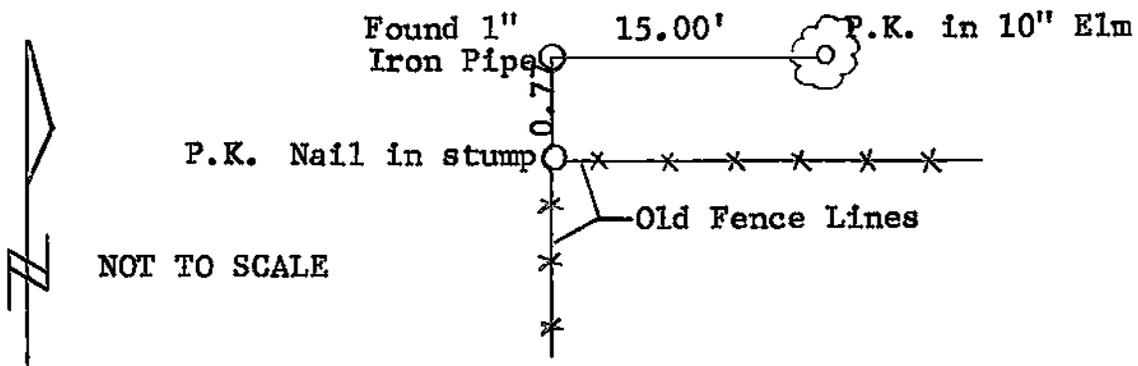

PLAN VIEW DRAWING OF REFERENCE TIES

MAP SHOWING DISTANCE AND DIRECTION TO OTHER PUBLIC LAND SURVEY CORNERS USED FOR REESTABLISHING THE CORNER

I, Gary A. Watts
 HEREBY CERTIFY THAT THE CORNER LOCATION SHOWN ON THIS RECORD
 WAS DETERMINED BY ME OR UNDER MY DIRECTION AND CONTROL AND
 THAT THIS U. S. PUBLIC LAND SURVEY MONUMENT RECORD IS CORRECT
 AND COMPLETE TO THE BEST OF MY KNOWLEDGE AND BELIEF.

Gary A. Watts Signature 6/04/85 Date



Seal