


21607360000

U. S. PUBLIC LAND SURVEY MONUMENT RECORD

SECTION 1 T 15 N, R 7 W, TOWN OF SHELBY

LA CROSSE COUNTY

LAT: 43°48'43.78644" N
 LON: 91°08'58.18316" W
 ELLIP. HT.: 333.992 METERS

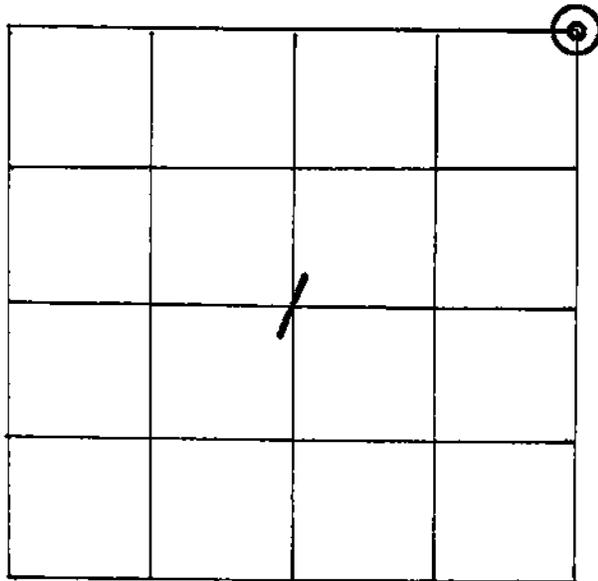

LOCATION OF LANDMARK

CREW: WILLIAM C. JUNG
 PETER F. FOLLANSBEE
 DATE: 4/15/2008

WISCONSIN COORDINATE SYSTEM

North 662,578.882

East 1,665,087.802

Theta Angle

Horiz. Order

Vert. Order

DATUM: 1983('91)

TYPE OF LANDMARK

3/4" x 30" IRON BAR WITH A RED PLASTIC CAP.

BEARINGS ARE REFERENCED TO
 GRID NORTH AS PER SECTION DATA.

Describe any record evidence, monument evidence, testimonial evidence or any other material evidence you considered and whether the monument was found or restored through acceptance of an obliterated evidence location.

The iron pipe that I tied off back in 1996 was buried under two feet of rock, rubble, and clay. It was very hard digging! Set an iron bar with a red plastic cap in and over the iron pipe, flush with the ground.

Describe or show any material discrepancy between the location of the restored corner and that of the corner previously restored or reestablished.


NONE KNOWN.

RECORD OF DURABLE WITNESS MONUMENTS

MAGNETIC ±


NO	DESCRIPTION	BEARING	DISTANCE
1	SET A 3/4" x 30" IRON BAR WITH ALUM. CAP 7' N. OF TREE	N 38° E	39.67 FT.
2	SET A 3/4" x 30" IRON BAR WITH ALUM. CAP 2' W. OF ASPHALT	N 71° E	103.06 FT.
3	EX. RAILROAD SPIKE IN CENTERLINE OF ROAD	EAST ±	108.32 FT.
4	SET A 3/4" x 30" IRON BAR WITH ALUM. CAP 2' W. OF ASPHALT	S 46° E	124.31 FT.

(NOT TO SCALE)

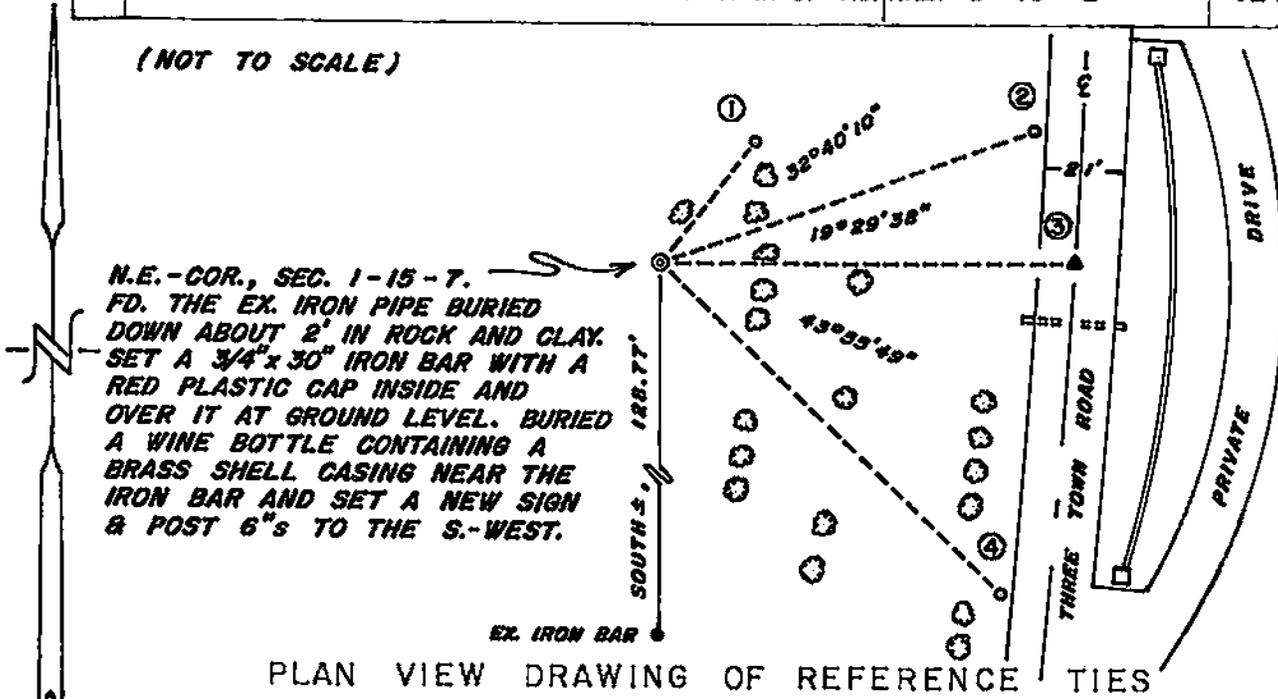


MAP SHOWING DISTANCE AND DIRECTION TO OTHER PUBLIC LAND SURVEY CORNERS USED FOR REESTABLISHING THE CORNER

(GRID BEARINGS AND DISTANCES)
 (GRID FACTOR: 0.99994)
 (NOT TO SCALE)

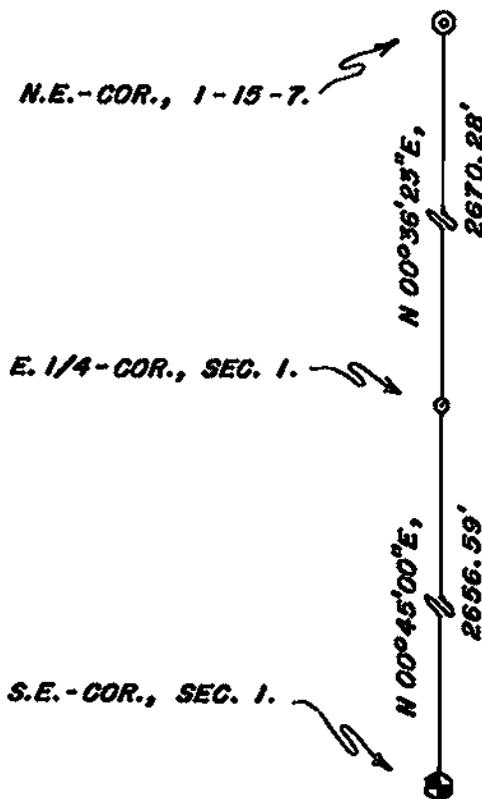

I, WILLIAM C. JUNG, COUNTY SURVEYOR
 HEREBY CERTIFY THAT THE CORNER LOCATION SHOWN ON THIS RECORD
 WAS DETERMINED BY ME OR UNDER MY DIRECTION AND CONTROL AND
 THAT THIS U. S. PUBLIC LAND SURVEY MONUMENT RECORD IS CORRECT
 AND COMPLETE TO THE BEST OF MY KNOWLEDGE AND BELIEF.


William C. Jung 9/29/08
 Signature Date

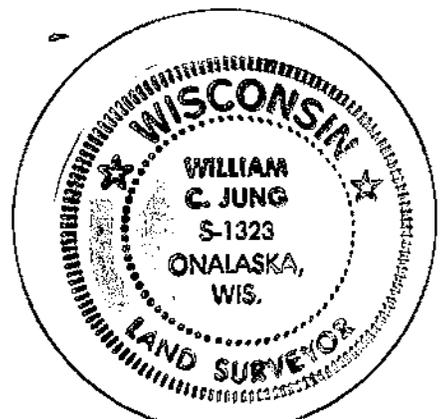

Seal

U. S. PUBLIC LAND SURVEY MONUMENT RECORD

SECTION 1 T 15 N, R 7 W, TOWN OF SHELBY
 LA CROSSE COUNTY

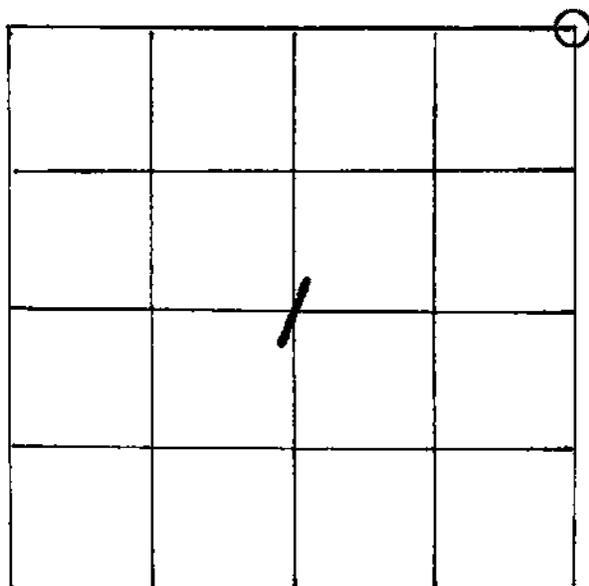

LOCATION OF LANDMARK

WISCONSIN COORDINATE SYSTEM
North
East
Theta Angle
Horiz. Order
Vert. Order
TYPE OF LANDMARK
Existing 1" Iron Pipe.
BEARINGS ARE REFERENCED TO

Crew: WILLIAM C. JUNG
 PETER F. FOLLANSBEE
 Date: 4/23/1996

Describe any record evidence, monument evidence, testimonial evidence or any other material evidence you considered and whether the monument was found or restored through acceptance of an obliterated evidence location.

I found an iron pipe at the corner. This corner location has been used in many recent surveys. I had searched for a stone here back on 9/18/87 but found nothing. There appears to have been erosion here in the past. The old ditch is full of rock, stone, etc. Bob Skemp told me on 9/14/87 that the fence was moved North in 1951 by verbal agreement between the neighbors. He agreed that it should be South of the fence corner. Steve Solberg and I agreed on its present and final location years ago. Describe or show any material discrepancy between the location of the restored corner and that of the corner previously restored or reestablished.

None Known.

VOID
weg

