


U. S. PUBLIC LAND SURVEY MONUMENT RECORD

SECTION 1 T 15 N, R 7 W, TOWN OF SHELBY

LA CROSSE COUNTY

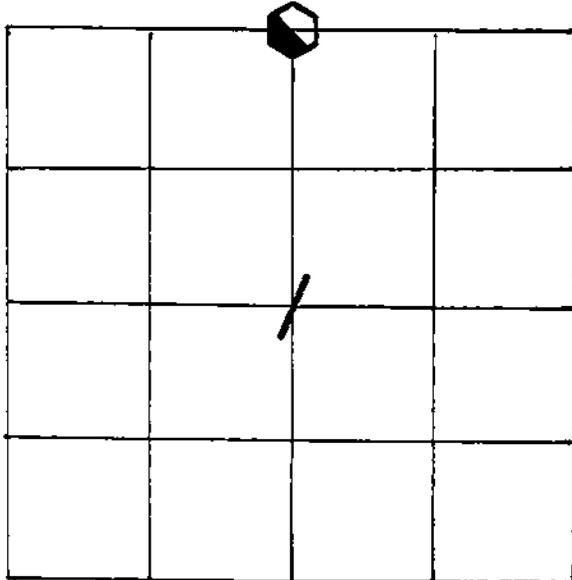

LOCATION OF LANDMARK

CREW: **WILLIAM C. JUNG**
PETER F. FOLLANSBEE
 DATE: **4/14/2008**

WISCONSIN COORDINATE SYSTEM

North

East

Theta Angle

Horiz. Order

Vert. Order

TYPE OF LANDMARK

30" ALUMINUM BERNTSEN MARKER.

BEARINGS ARE REFERENCED TO

AS'ND NORTH AS PER SECTION DATA.

Describe any record evidence, monument evidence, testimonial evidence or any other material evidence you considered and whether the monument was found or restored through acceptance of an obliterated evidence location.


Fairchild set an iron bar at this corner. It appears to agree with Harding and Maxwell's locations and falls at what looks like the occupied corner. I removed the iron bar and replaced it with a Berntsen marker.

Describe or show any material discrepancy between the location of the restored corner and that of the corner previously restored or reestablished.

This does not appear to agree with Selberg's computed location.


RECORD OF DURABLE WITNESS MONUMENTS

| NO | DESCRIPTION | MAGNETIC BEARING | DISTANCE |
|----|---|------------------|----------------|
| 1 | SET A NAIL IN N.W.-SIDE OF A 7" HICKORY | S 30° W | SLOPE = 54.81' |
| 2 | SET A NAIL IN S.-SIDE OF A 27" OAK | S 86° W | 49.30 FT. |
| 3 | SET A 3/4" x 19" REBAR ON HIGH GROUND | N 14° W | 52.53 FT. |
| 4 | SET A NAIL IN S.E.-SIDE OF A 9-1/2" HICKORY | N 20° E | 37.28 FT. |

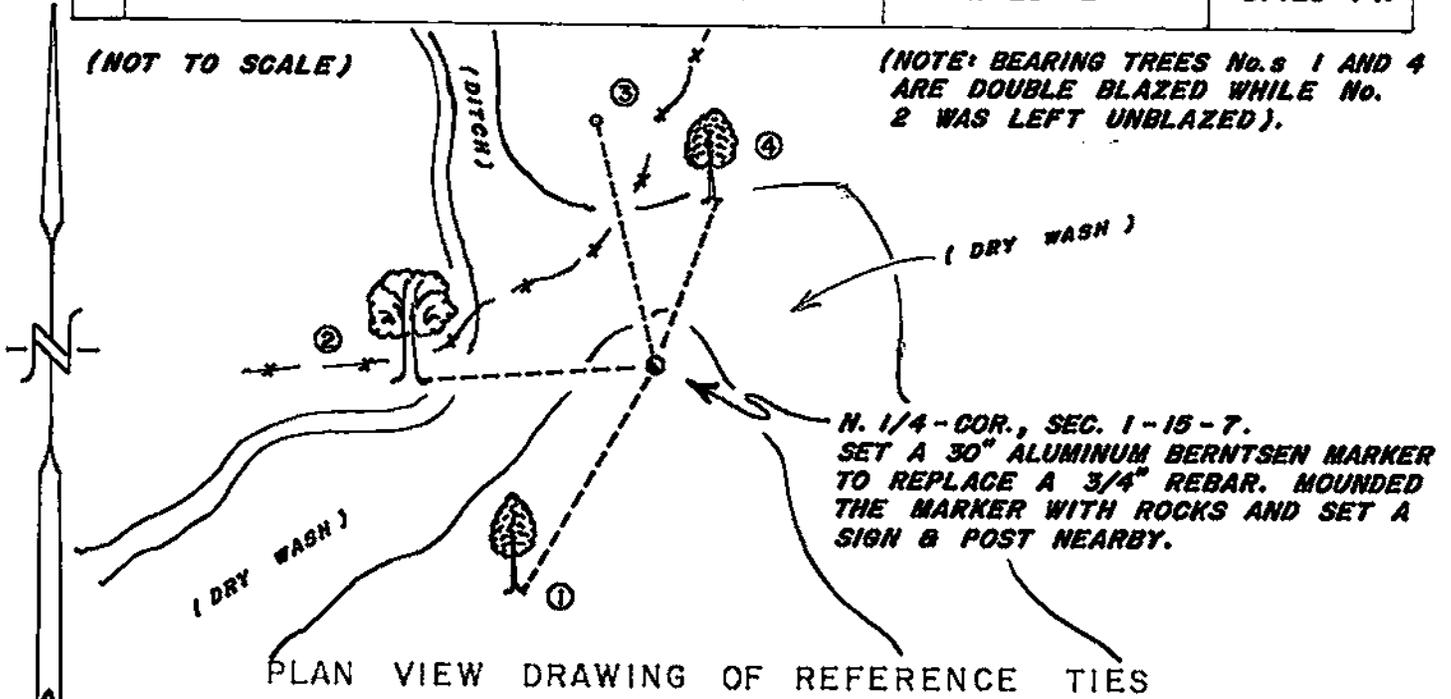


MAP SHOWING DISTANCE AND DIRECTION TO OTHER PUBLIC LAND SURVEY CORNERS USED FOR REESTABLISHING THE CORNER

(ASSUMED BEARINGS AND GROUND DISTANCES)
(P.E. FAIRCHILD MEASUREMENTS)
(NOT TO SCALE)

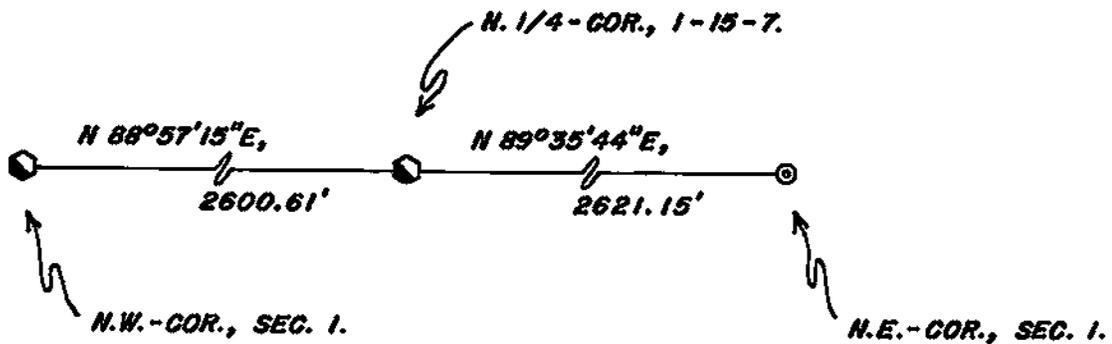

I, WILLIAM C. JUNG, COUNTY SURVEYOR
HEREBY CERTIFY THAT THE CORNER LOCATION SHOWN ON THIS RECORD WAS DETERMINED BY ME OR UNDER MY DIRECTION AND CONTROL AND THAT THIS U. S. PUBLIC LAND SURVEY MONUMENT RECORD IS CORRECT AND COMPLETE TO THE BEST OF MY KNOWLEDGE AND BELIEF.

William C. Jung 9/29/08
Signature Date

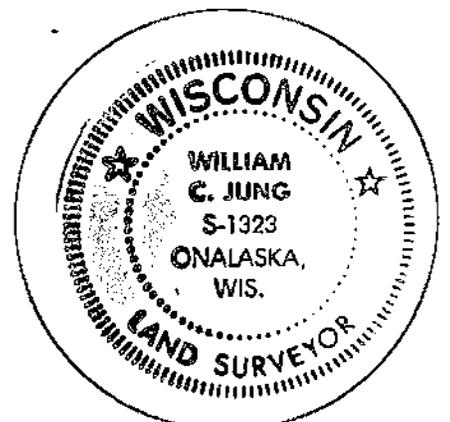

Seal