


U. S. PUBLIC LAND SURVEY MONUMENT RECORD

SECTION 1 T 16 N, R 5 W, TOWN OF BANGOR

LA CROSSE COUNTY

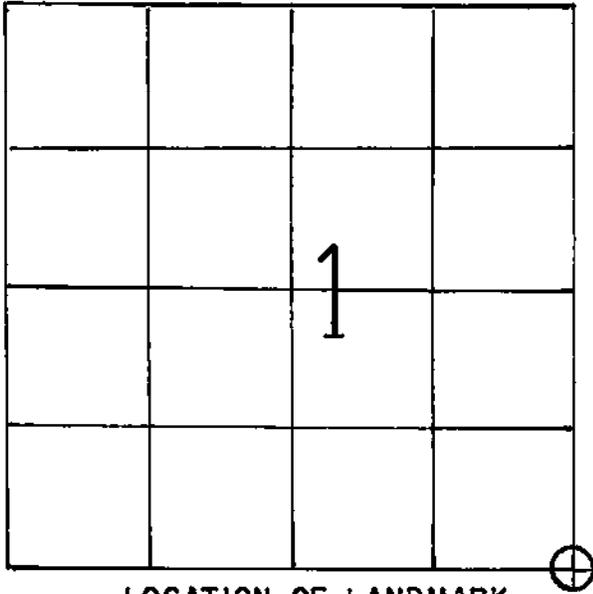

LOCATION OF LANDMARK

WISCONSIN COORDINATE SYSTEM
North
East
Theta Angle
Horiz. Order
Vert. Order
TYPE OF LANDMARK
Exist. Harrison marker.
BEARINGS ARE REFERENCED TO

Crew: William C. Jung
Peter F. Follansbee

Date: 10/12/93

Describe any record evidence, monument evidence, testimonial evidence or any other material evidence you considered and whether the monument was found or restored through acceptance of an obliterated evidence location.

I found a Harrison marker set by me in previous survey work and took new ties.

Describe or show any material discrepancy between the location of the restored corner and that of the corner previously restored or reestablished.

None Known.

I, William C. Jung do hereby certify that on the 17th day of November 1981, I found (evidence) ~~Section 6~~ of the Southwest corner of Section 6, T. 16 N., R. 4 W. Fourth Principal Meridian, and I re-established said corner according to the Wisconsin Statutes as shown and described hereon.

Dated this 19th day of NOV. 1981.

William C. Jung


R. L. S. 1323
Title

William C. Jung

Description of corner and witness monuments, references and accessories used to perpetuate the original or re-established location of this corner:

Witnesses to corner location:




Jung
Dechant
Pietz

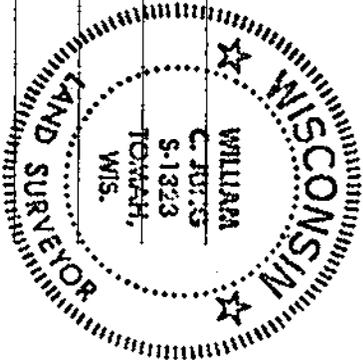

History of corner establishment since Original Government Survey
I used this point as the section corner in a survey done by myself in August of 1980.

Description of corner evidence found:

Found a railroad spike set by me at the occupied corner in August of 1980. Measurements to the North, West, and East indicate that this point fits the existing conditions very well. I accepted this occupied corner as the best available evidence of the original government corner.

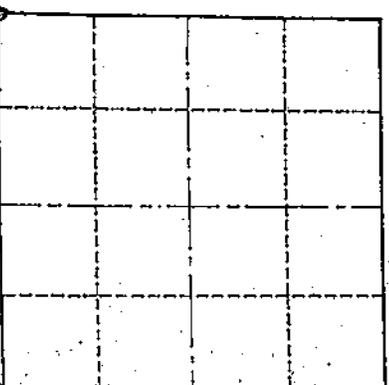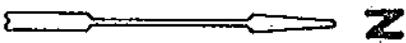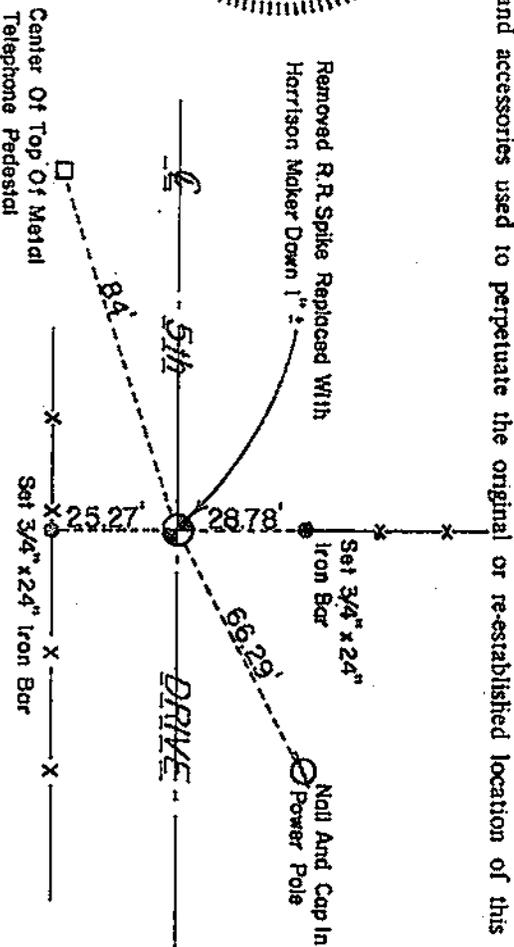

T 16 N R 4 W

WISCONSIN

Approved: **HARLEY A. SIMP**
MONROE CO. SURVEYOR

SURVEY CONTROL ORDER

Horizontal

Vertical

East (X)

North (Y)

Elevation (Z)

Zone

WISCONSIN COORDINATE SYSTEM

Corner

Control Sta. Name

Town Leon

County of Monroe

Wisconsin

VOID