


U. S. PUBLIC LAND SURVEY MONUMENT RECORD

SECTION 2 T 16 N, R 5 W, TOWN OF BANGOR
 LA CROSSE COUNTY

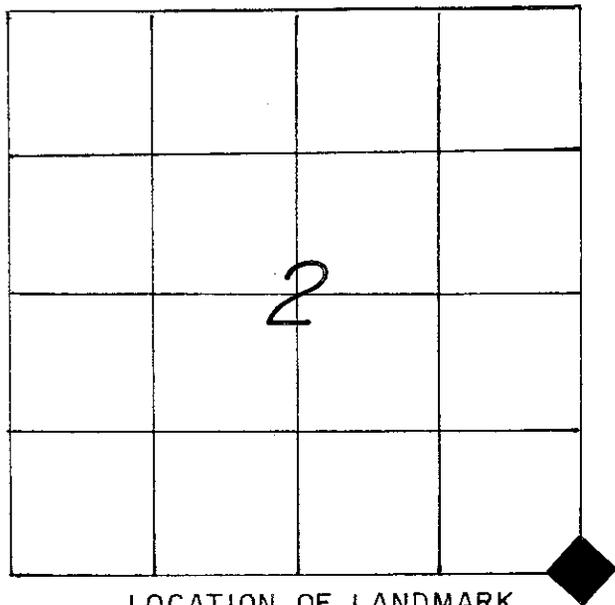

LOCATION OF LANDMARK

CREW: **BRYAN H. MEYER**
PETER F. FOLLANSBEE
 DATE: **11/09/2009**

WISCONSIN COORDINATE SYSTEM	
North	688,355.050
East	1,723,171.159
Theta Angle	
Horiz. Order	
Vert. Order	
DATUM:	NAD 1983 ('91)
TYPE OF LANDMARK	
6" x 6" SQUARE STONE MONUMENT.	
BEARINGS ARE REFERENCED TO	
GRID NORTH AS PER SECTION DATA.	


Describe any record evidence, monument evidence, testimonial evidence or any other material evidence you considered and whether the monument was found or restored through acceptance of an obliterated evidence location.

Describe or show any material discrepancy between the location of the restored corner and that of the corner previously restored or reestablished.

RECORD OF DURABLE WITNESS MONUMENTS


MAGNETIC

NO	DESCRIPTION	BEARING	DISTANCE
1	SET A NAIL IN N.W.-SIDE OF A 13" BASSWOOD	N 70° E	6.91 FT.
2	SET A NAIL IN N.W.-SIDE OF AN 18-1/2" RED OAK	N 78° E	20.26 FT.
3	SET A NAIL IN W.-SIDE OF A 16" RED OAK	S 08° W	29.68 FT.
4	SET A NAIL IN W.-SIDE OF A 6" ASH	S 30° W	SLOPE= 31.26'

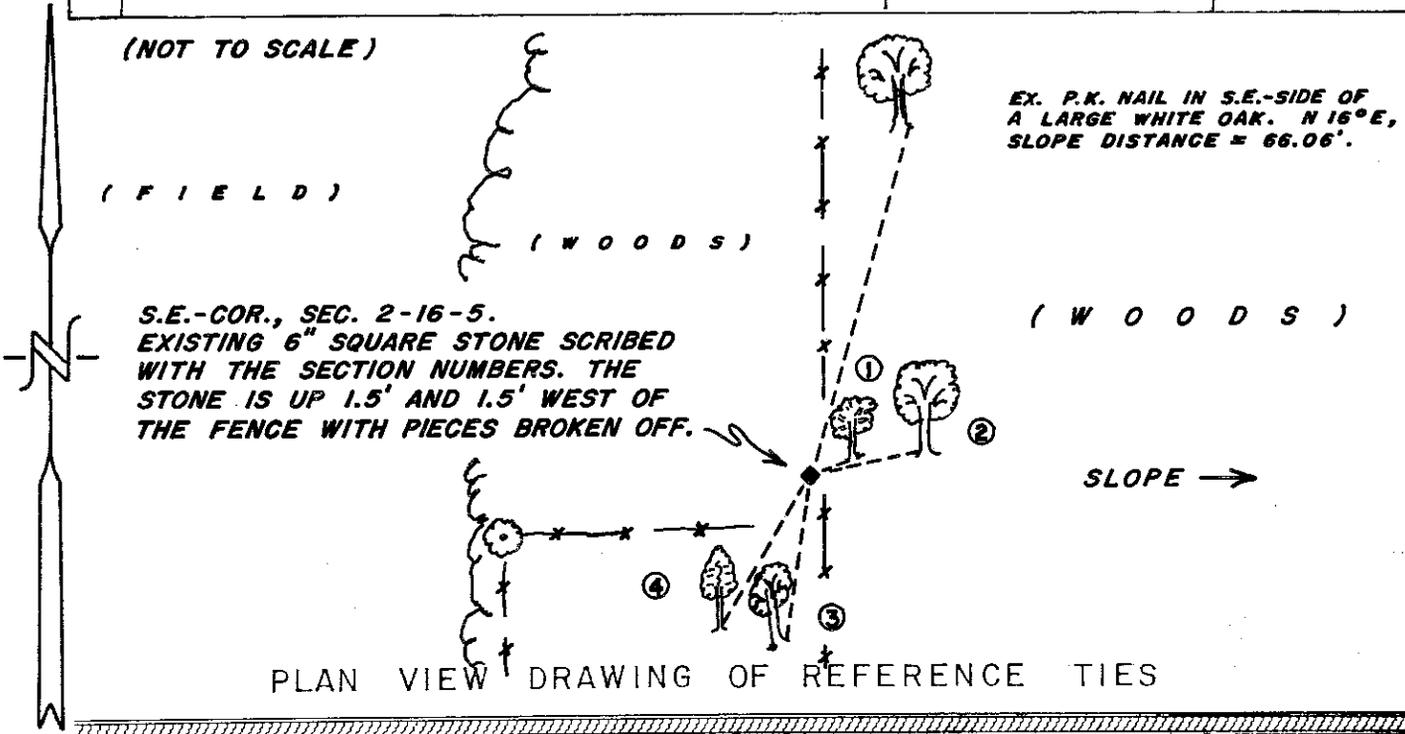


MAP SHOWING DISTANCE AND DIRECTION TO OTHER PUBLIC LAND SURVEY CORNERS USED FOR REESTABLISHING THE CORNER

(GRID BEARINGS AND DISTANCES)
(GRID FACTOR: 0.999938)
(NOT TO SCALE)

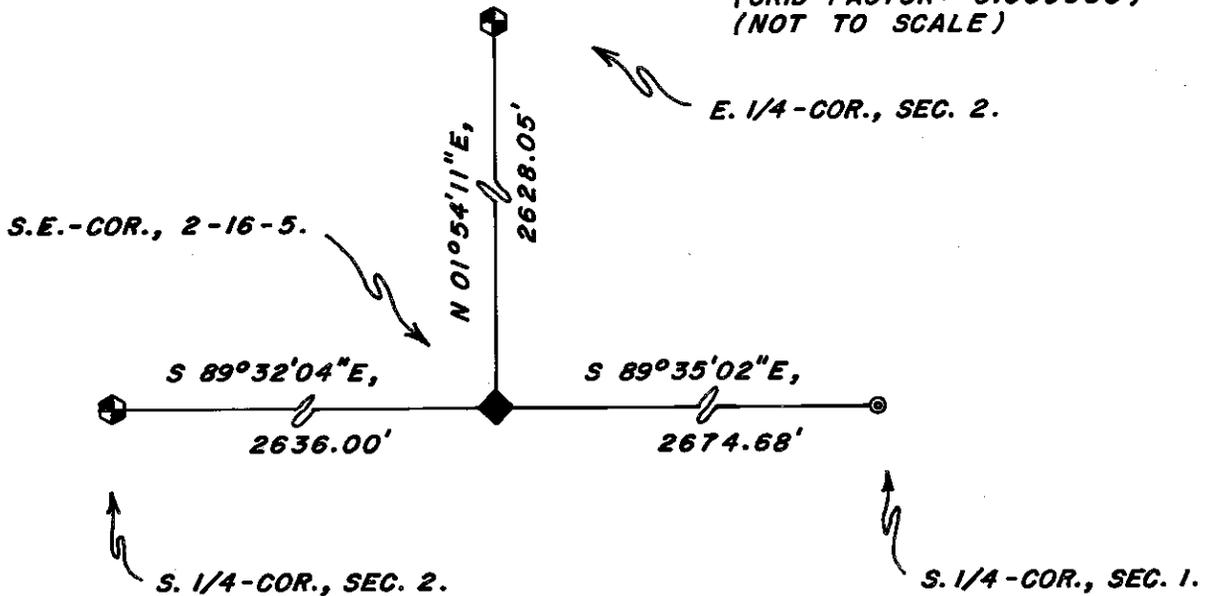

I, BRYAN H. MEYER, COUNTY SURVEYOR
HEREBY CERTIFY THAT THE CORNER LOCATION SHOWN ON THIS RECORD WAS DETERMINED BY ME OR UNDER MY DIRECTION AND CONTROL AND THAT THIS U. S. PUBLIC LAND SURVEY MONUMENT RECORD IS CORRECT AND COMPLETE TO THE BEST OF MY KNOWLEDGE AND BELIEF.

Bryan H. Meyer Signature July 9, 2010 Date

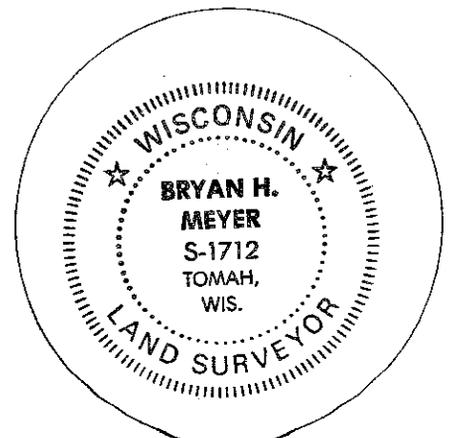


Seal

21605020000

U. S. PUBLIC LAND SURVEY MONUMENT RECORD

SECTION 2 T 16 N, R 5 W, TOWN OF BANGOR

LA CROSSE COUNTY

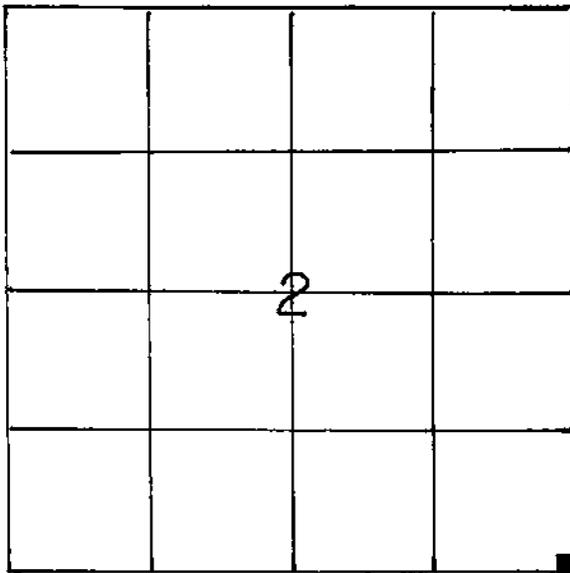

LOCATION OF LANDMARK
 DATE: 11-17-86
 CREW: BILL JUNG, PERRY DAHL

WISCONSIN COORDINATE SYSTEM

North

East

Theta Angle

Horiz. Order

Vert. Order

TYPE OF LANDMARK

STONE MONUMENT

BEARINGS ARE REFERENCED TO

True

Date: 9-7-89
 Crew: William C. Jung
 Peter Follansbee
 Dennis Melichar

Describe any record evidence, monument evidence, testimonial evidence or any other material evidence you considered and whether the monument was found or restored through acceptance of an obliterated evidence location.

I found a stone at the corner and accepted it as the best available evidence of the original government corner position.


December 21, 1989: Dennis Meichar, while traversing for Norm Hurlburt, plumbed the stone back up, moving the top 0.58' to the West. The stone must have gone off plumb downhill. I had to plumb it back up in '86.

Describe or show any material discrepancy between the location of the restored corner and that of the corner previously restored or reestablished.

None known.

RECORD OF DURABLE WITNESS MONUMENTS
MAGNETIC


NO	DESCRIPTION	BEARING	DISTANCE
1	P.K. NAIL IN DOUBLE-BLAZED 17" W. OAK	N16°E	slope=66.06'
2	P.K. NAIL IN DOUBLE-BLAZED 31" OAK	N53°E	slope=31.60'
3	P.K. NAIL IN DOUBLE-BLAZED 10" OAK	N73°E	20.46'
4	P.K. NAIL IN DOUBLE-BLAZED 9" ASPEN	N53°E	5.72'

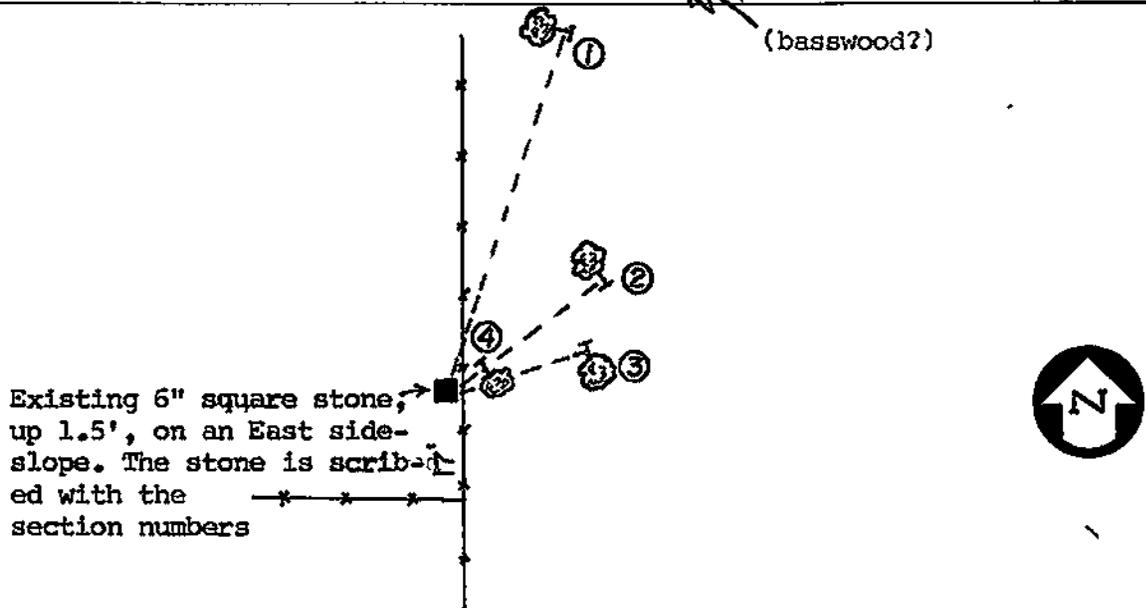

PLAN VIEW DRAWING OF REFERENCE TIES

MAP SHOWING DISTANCE AND DIRECTION TO OTHER PUBLIC LAND SURVEY CORNERS USED FOR REESTABLISHING THE CORNER

(not to scale)

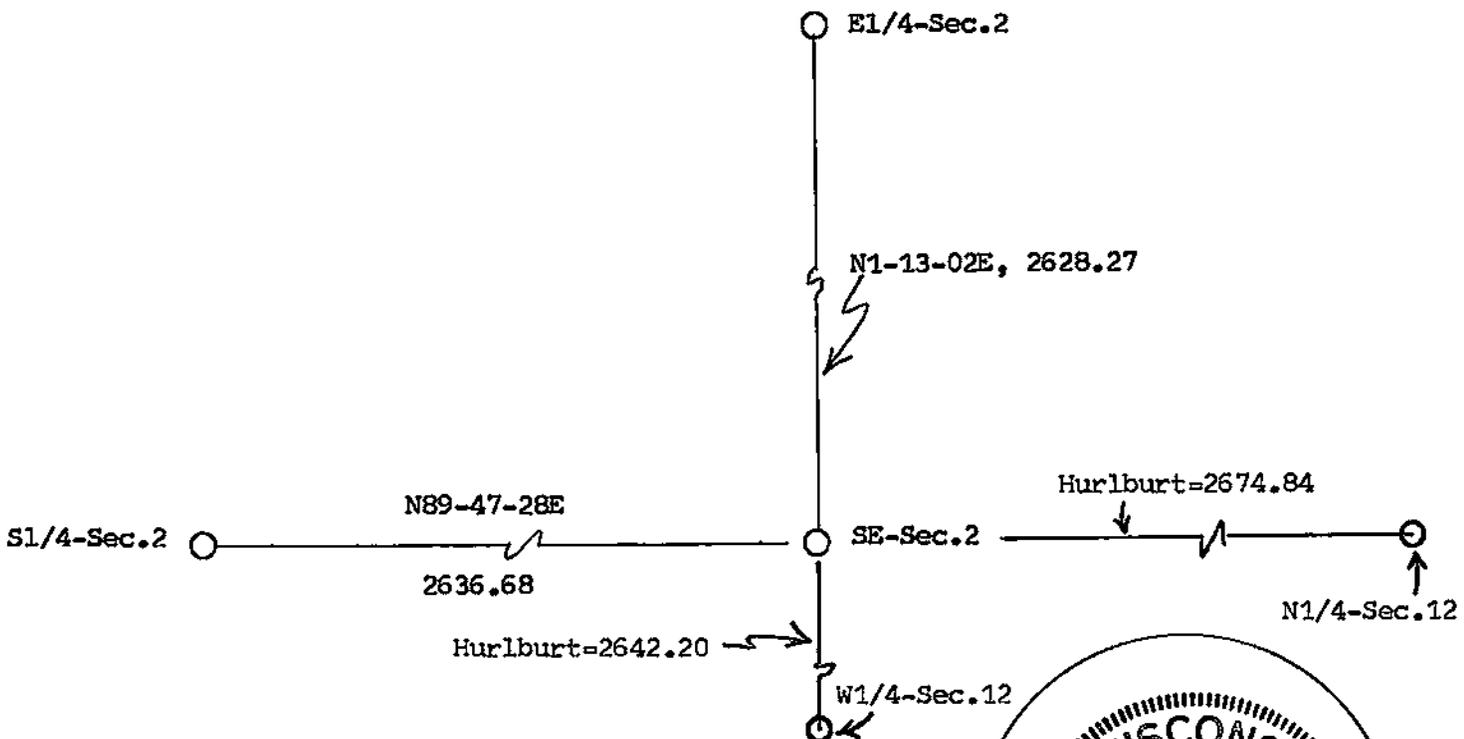

I, William C. Jung, Deputy County Surveyor,
HEREBY CERTIFY THAT THE CORNER LOCATION SHOWN ON THIS RECORD
WAS DETERMINED BY ME OR UNDER MY DIRECTION AND CONTROL AND
THAT THIS U. S. PUBLIC LAND SURVEY MONUMENT RECORD IS CORRECT
AND COMPLETE TO THE BEST OF MY KNOWLEDGE AND BELIEF.

William C. Jung
Signature

March 10, 1987
Date

Revised: December 21, 1989
wey

