


21605020020

U. S. PUBLIC LAND SURVEY MONUMENT RECORD

SECTION 2 T 16 N, R 5 W, TOWN OF BANGOR
 LA CROSSE COUNTY

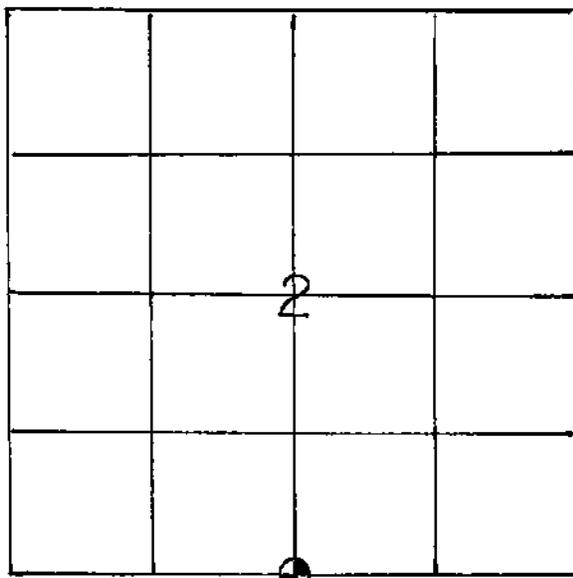

LOCATION OF LANDMARK

DATE: 11-20-86
 CREW: BILL JUNG, PERRY DAHL

WISCONSIN COORDINATE SYSTEM
North
East
Theta Angle
Horiz. Order
Vert. Order
TYPE OF LANDMARK Lunde marker BERNTSEN TOP IN IRON PIPE
BEARINGS ARE REFERENCED TO True

Crew: William C. Jung
 Peter F. Follansbee
 Date: 7-24-93

Describe any record evidence, monument evidence, testimonial evidence or any other material evidence you considered and whether the monument was found or restored through acceptance of an obliterated evidence location.

I set the corner by single proportionate measurement, on line and equidistant between the section corners.

7/24/93


I found the pipe with the Berntsen top broken off. I removed the pipe and replaced it with a Lunde marker, flush. Buried a wine bottle with a shell casing on the South side of the Lunde.

Give or show any material discrepancy between the location of the restored and that of the corner previously restored or reestablished.

This corner does not agree with the line fence to the South. However, in looking at an old 1954 aerial photo, this line fence is not in. It would not appear then that the fence is on an old line.

RECORD OF DURABLE WITNESS MONUMENTS

NO	DESCRIPTION	BEARING	DISTANCE
1	IRON PIPE (set)	----	32.12'
2	IRON PIPE (existing)	----	42.53'
3	TELEPHONE BOX (to center of)	----	34.7'
4			

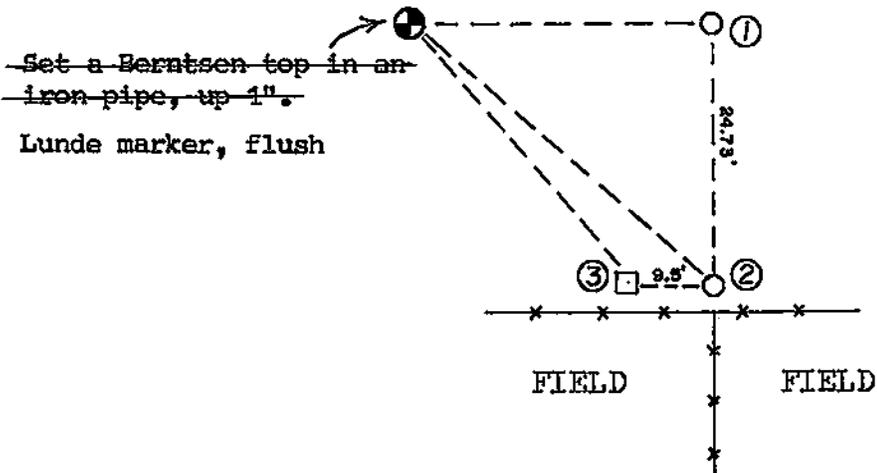


PLAN VIEW DRAWING OF REFERENCE TIES



MAP SHOWING DISTANCE AND DIRECTION TO OTHER PUBLIC LAND SURVEY CORNERS USED FOR REESTABLISHING THE CORNER

(not to scale)

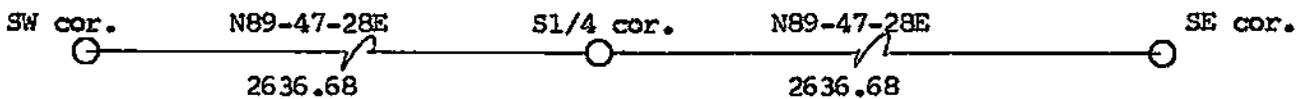


I, William C. Jung, Deputy County Surveyor,
HEREBY CERTIFY THAT THE CORNER LOCATION SHOWN ON THIS RECORD
WAS DETERMINED BY ME OR UNDER MY DIRECTION AND CONTROL AND
THAT THIS U. S. PUBLIC LAND SURVEY MONUMENT RECORD IS CORRECT
AND COMPLETE TO THE BEST OF MY KNOWLEDGE AND BELIEF.

William C. Jung
Signature

March 17, 1987
Date

Revised: January 18, 1994

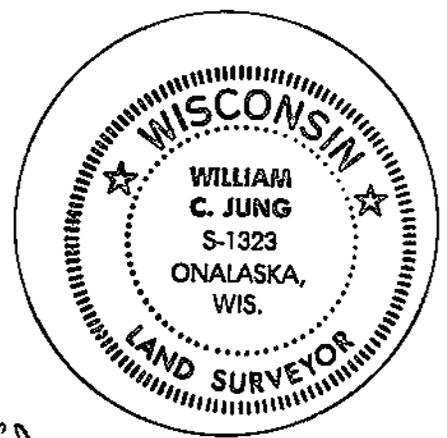

Seal