


21605030000

U. S. PUBLIC LAND SURVEY MONUMENT RECORD

SECTION 3 T 16 N, R 5 W, TOWN OF BANGOR

LA CROSSE COUNTY

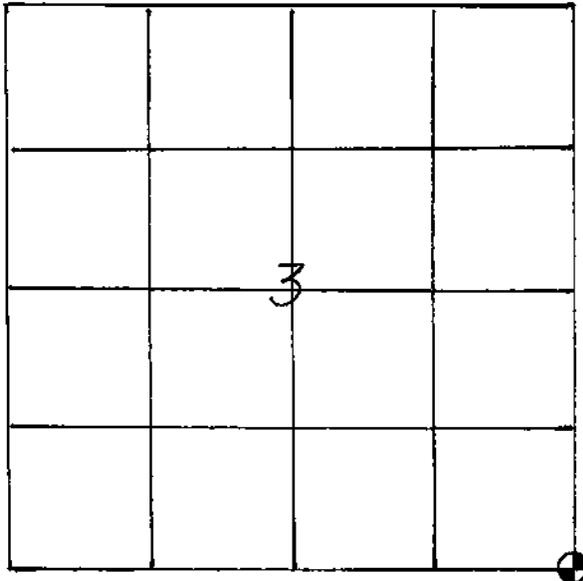

LOCATION OF LANDMARK

DATE: 11-19-86
CREW: BILL JUNG, PERRY DAHL

WISCONSIN COORDINATE SYSTEM

North

East

Theta Angle

Horiz. Order

Vert. Order

TYPE OF LANDMARK RR spike in pavt. over
1 1/4" IRON PIPE, down 6"+

BEARINGS ARE REFERENCED TO

True

Date: 5-26-92
Crew: Bill Jung, Peter Follansbee
Date: 7-24-93
Crew: Bill Jung, Peter Follansbee

Describe any record evidence, monument evidence, testimonial evidence or any other material evidence you considered and whether the monument was found or restored through acceptance of an obliterated evidence location.

I found an iron bar at the section corner and accepted it as the best available evidence of the original government corner position. This iron bar had been used in previous survey work. I set an iron pipe over and around the iron bar.


The iron pipe and bar were driven down because of paving. I set a railroad spike in the new pavement over the pipe and bar.

Describe or show any material discrepancy between the location of the restored corner and that of the corner previously restored or reestablished.

None known.

RECORD OF DURABLE WITNESS MONUMENTS

NO	DESCRIPTION	BEARING	DISTANCE
1	CENTER OF TELEPHONE BOX	-----	101.05'
2	CORNER OF GARAGE BASE	-----	140.08'
3	CHISLED "X" ON CULVERT	-----	84.32'
4	HEXAGONAL IRON BAR	-----	27.75'

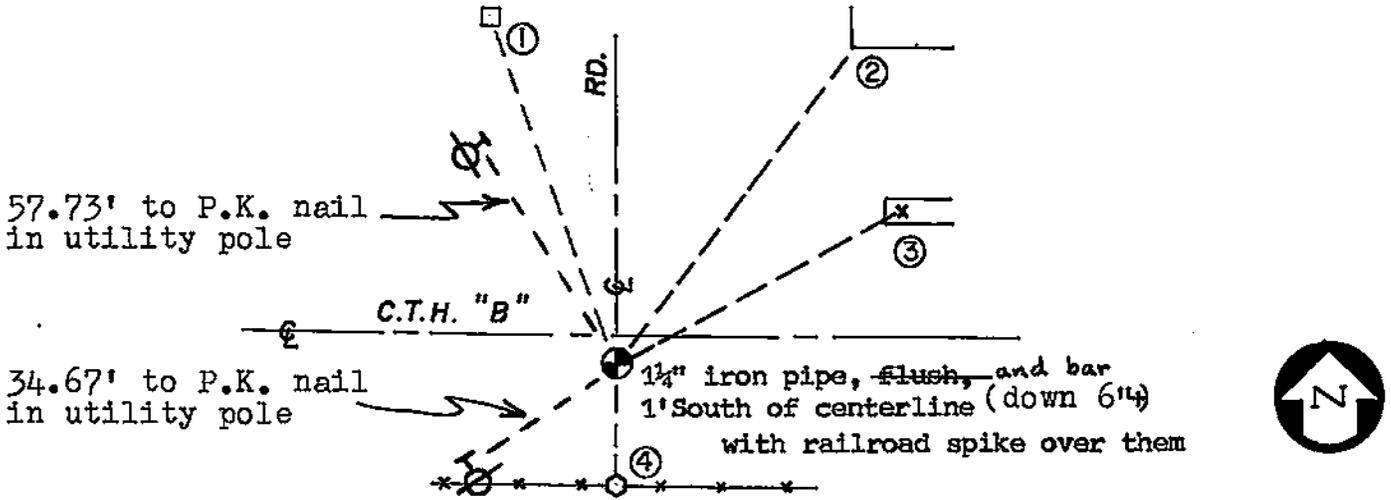


(not to scale)

PLAN VIEW DRAWING OF REFERENCE TIES

MAP SHOWING DISTANCE AND DIRECTION TO OTHER PUBLIC LAND SURVEY CORNERS USED FOR REESTABLISHING THE CORNER

(not to scale)

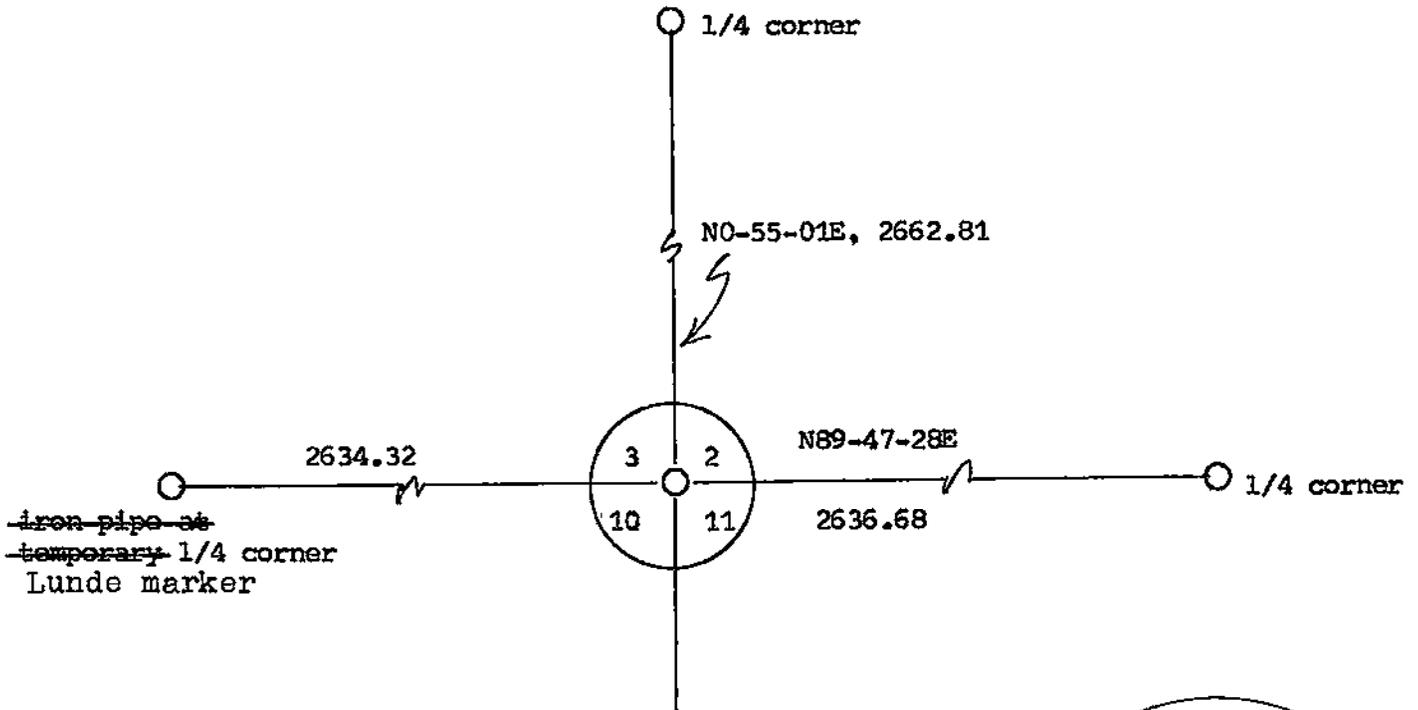


I, William C. Jung, Deputy County Surveyor,
 HEREBY CERTIFY THAT THE CORNER LOCATION SHOWN ON THIS RECORD
 WAS DETERMINED BY ME OR UNDER MY DIRECTION AND CONTROL AND
 THAT THIS U. S. PUBLIC LAND SURVEY MONUMENT RECORD IS CORRECT
 AND COMPLETE TO THE BEST OF MY KNOWLEDGE AND BELIEF.

William C. Jung
 Signature

March 17, 1987
 Date

Revised: December 30, 1992

Revised: 1/18/94 *asey*

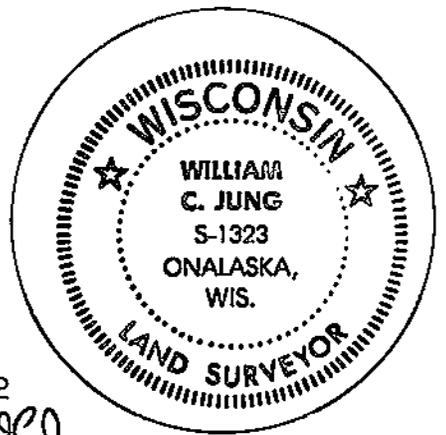

Seal