


21605030020

U. S. PUBLIC LAND SURVEY MONUMENT RECORD

SECTION 3 T 16 N, R 5 W, TOWN OF Bangor

LA CROSSE COUNTY

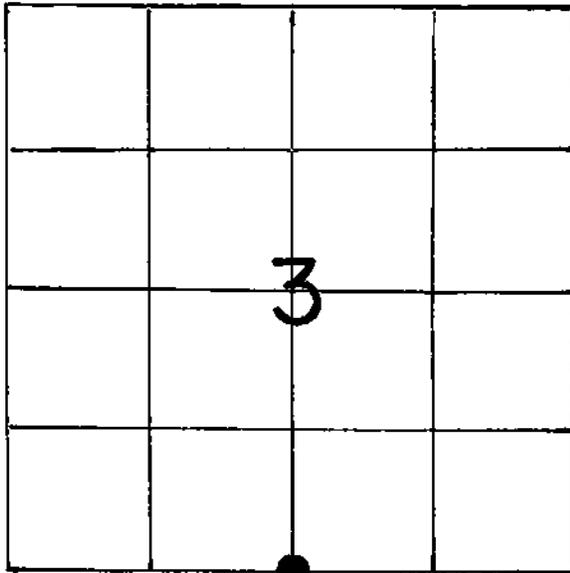

LOCATION OF LANDMARK

Crew: William C. Jung
Peter Follansbee

Date: 10/27/88

Crew: William C. Jung
Peter F. Follansbee

Date: May 26, 1992 and 7/24/93

Describe any record evidence, monument evidence, testimonial evidence or any other material evidence you considered and whether the monument was found or restored through acceptance of an obliterated evidence location.

I set the corner on line with the section corners and on line with the line fence to the North. This best fits the field evidence. I set a brass capped Lunde marker on the South edge of the asphalt. A whiskey bottle with an empty M-16 cartridge was placed and buried as a memorial on the South side of the marker. We found no evidence of a stone as we dug.

After paving a P.K. nail was set over the Lunde marker.

Describe or show any material discrepancy between the location of the restored corner and that of the corner previously restored or reestablished.

None known.

WISCONSIN COORDINATE SYSTEM

North

East

Theta Angle

Horiz. Order

Vert. Order


TYPE OF LANDMARK P.K. nail over
Brass capped Lunde marker

BEARINGS ARE REFERENCED TO


True

RECORD OF DURABLE WITNESS MONUMENTS

NO	DESCRIPTION	BEARING	DISTANCE
1	Last bolt on top @SE cor. before holes	-----	133.9
2	Set 1"hexagon x 20" drill bit	North ±	42.37
3	Southwest corner of shed	-----	127.9
4	P.K. nail in utility pole	South +	31.5 31.46

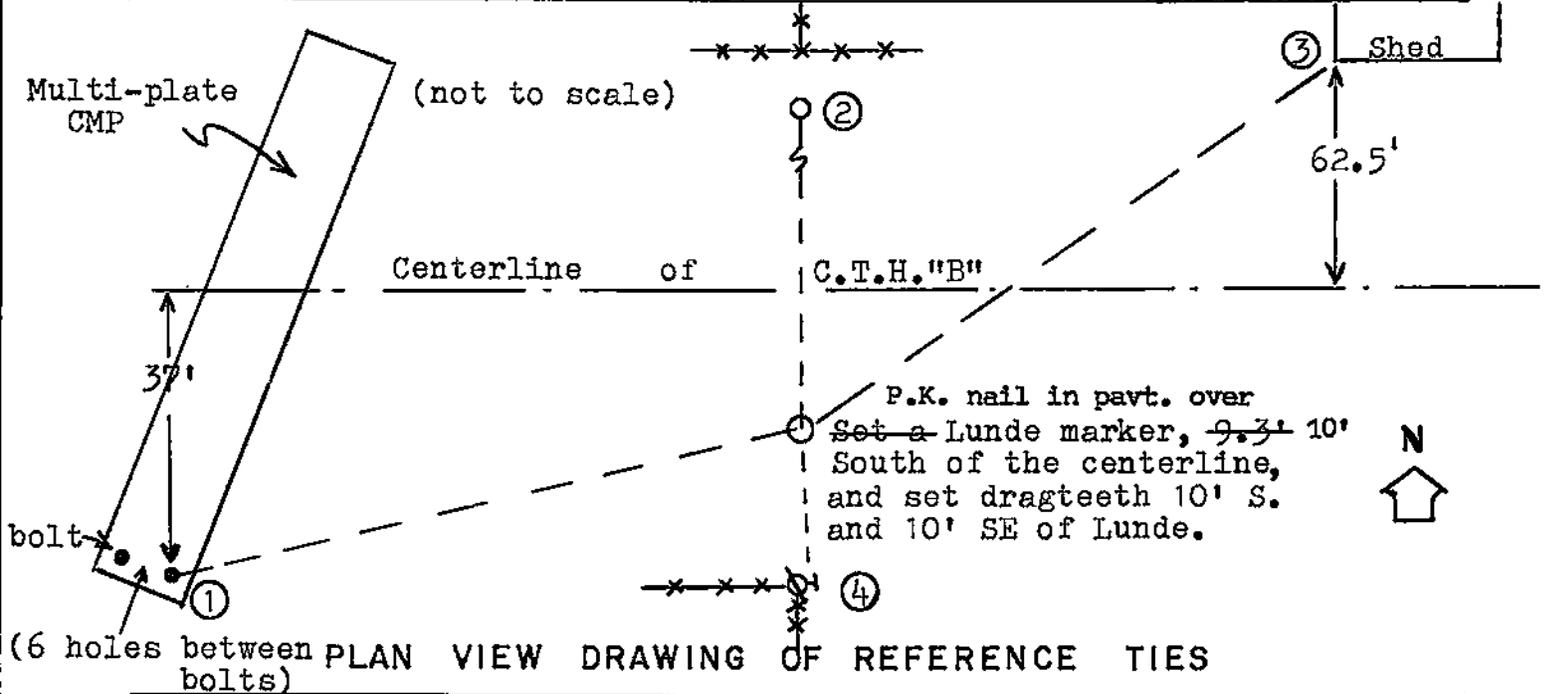

MAP SHOWING DISTANCE AND DIRECTION TO OTHER PUBLIC LAND SURVEY CORNERS USED FOR REESTABLISHING THE CORNER (not to scale)

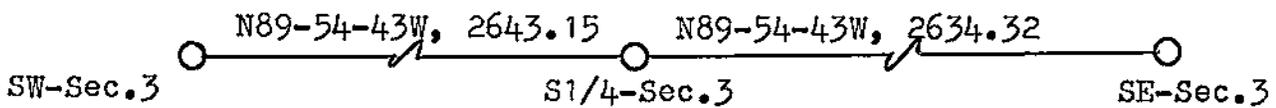

I, William C. Jung, Deputy County Surveyor,
HEREBY CERTIFY THAT THE CORNER LOCATION SHOWN ON THIS RECORD
WAS DETERMINED BY ME OR UNDER MY DIRECTION AND CONTROL AND
THAT THIS U. S. PUBLIC LAND SURVEY MONUMENT RECORD IS CORRECT
AND COMPLETE TO THE BEST OF MY KNOWLEDGE AND BELIEF.

William C. Jung
Signature

1/12/89
Date

Revised: 12/30/92 *asej*
Revised: 1/18/94 *asej*

