


21605042000

U. S. PUBLIC LAND SURVEY MONUMENT RECORD

SECTION 4 T 16 N, R 5 W, TOWN OF BANGOR

LA CROSSE COUNTY

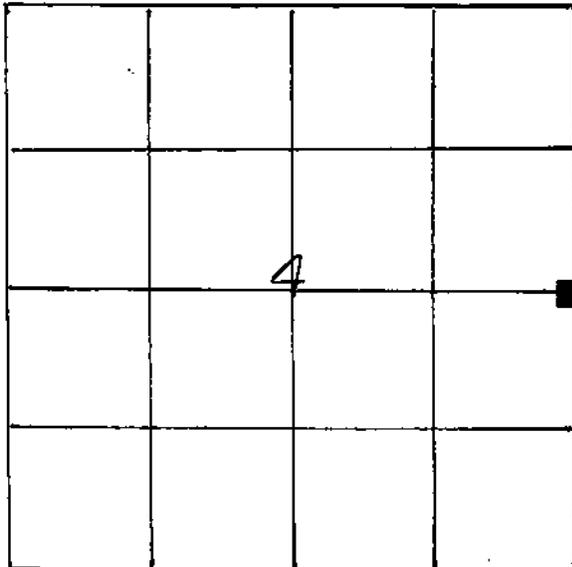

LOCATION OF LANDMARK

DATE: 10-9-86

CREW: PERRY DAHL

William C. Jung

WISCONSIN COORDINATE SYSTEM

North

East

Theta Angle

Horiz. Order

Vert. Order

TYPE OF LANDMARK

STONE MONUMENT

BEARINGS ARE REFERENCED TO

True

Describe any record evidence, monument evidence, testimonial evidence or any other material evidence you considered and whether the monument was found or restored through acceptance of an obliterated evidence location.


I found a stone at the corner and accepted it as the best available evidence of the original government corner. This position also agrees with the old railroad maps.

Describe or show any material discrepancy between the location of the restored corner and that of the corner previously restored or reestablished.

This location does not agree with the corner as shown by Marcou in a survey done in August of 1950.

RECORD OF DURABLE WITNESS MONUMENTS


NO	DESCRIPTION	BEARING	DISTANCE
1	CENTERLINE OF NORTH R.R. TRACK	NORTH ±	72.85'
2	In old railroad R/W fence 1 1/4" IRON PIPE (set)	NORTH ± (magnetic)	25.06'
3	P.K. NAIL IN DOUBLE-BLAZED 8" OAK burr	N5°E	16.51'
4	8" long TIMBER SPIKE	SOUTH ±	215.4'

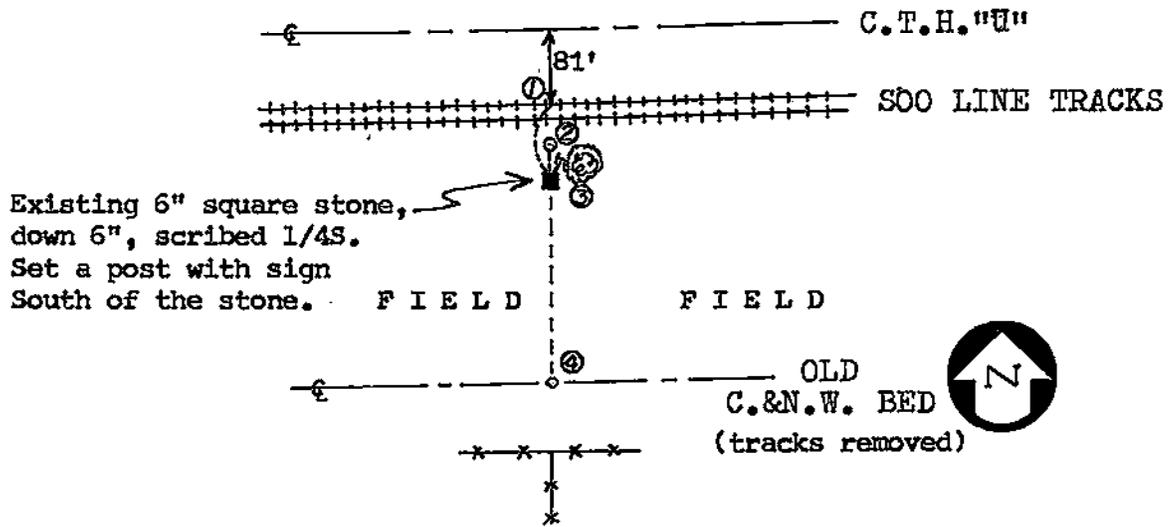

PLAN VIEW DRAWING OF REFERENCE TIES

MAP SHOWING DISTANCE AND DIRECTION TO OTHER PUBLIC LAND SURVEY CORNERS USED FOR REESTABLISHING THE CORNER


(not to scale)

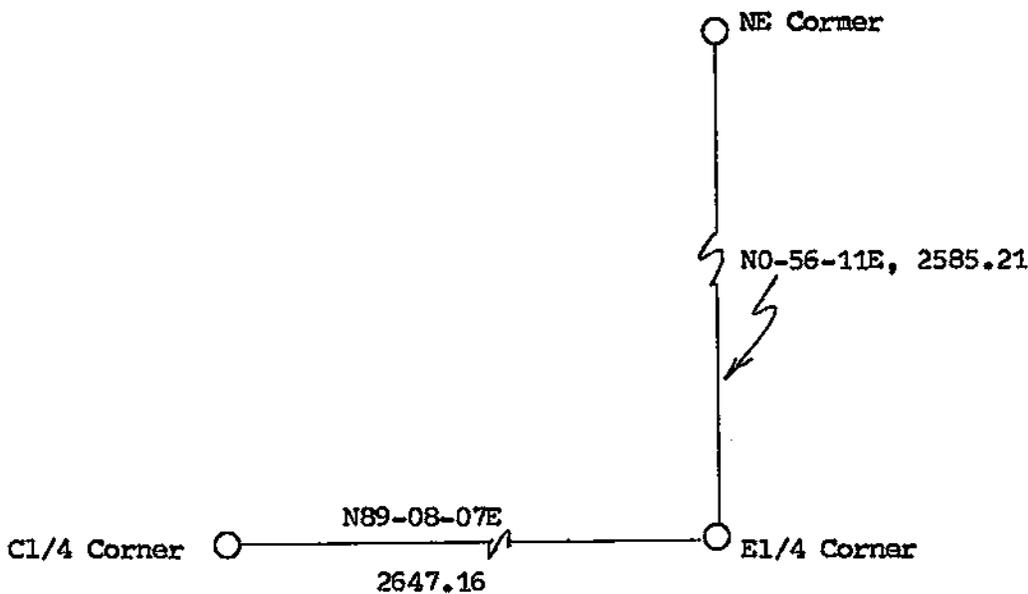

I, William C. Jung, Deputy County Surveyor,
HEREBY CERTIFY THAT THE CORNER LOCATION SHOWN ON THIS RECORD
WAS DETERMINED BY ME OR UNDER MY DIRECTION AND CONTROL AND
THAT THIS U. S. PUBLIC LAND SURVEY MONUMENT RECORD IS CORRECT
AND COMPLETE TO THE BEST OF MY KNOWLEDGE AND BELIEF.

William C. Jung
Signature

March 10, 1987
Date

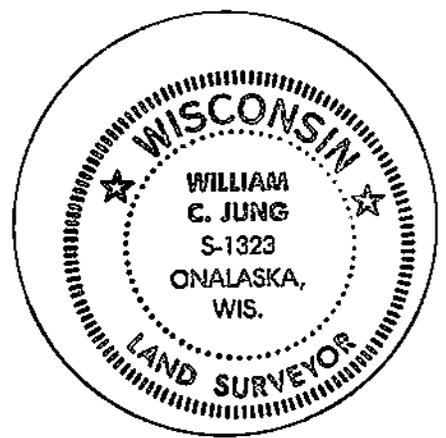

Seal