


U. S. PUBLIC LAND SURVEY MONUMENT RECORD

SECTION 4 T 16 N, R 5 W, TOWN OF BANGOR

LA CROSSE COUNTY

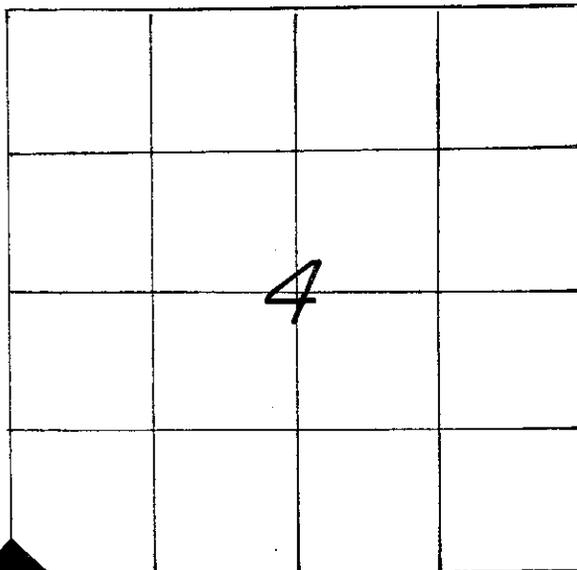

LOCATION OF LANDMARK

CREW: **BRYAN H. MEYER**  
**PETER F. FOLLANSBEE**  
 DATE: **11/02/2009**

WISCONSIN COORDINATE SYSTEM	
North	<b>688,481.721</b>
East	<b>1,707,340.120</b>
Theta Angle	
Horiz. Order	
Vert. Order	
DATUM:	<b>NAD 1983('91)</b>
TYPE OF LANDMARK	
<b>STONE MONUMENT.</b>	
BEARINGS ARE REFERENCED TO	
<b>GRID NORTH AS PER SECTION DATA.</b>	

Describe any record evidence, monument evidence, testimonial evidence or any other material evidence you considered and whether the monument was found or restored through acceptance of an obliterated evidence location.

Describe or show any material discrepancy between the location of the restored corner and that of the corner previously restored or reestablished.

RECORD OF DURABLE WITNESS MONUMENTS

NO	DESCRIPTION	MAGNETIC BEARING	DISTANCE
1	SET A NEW NAIL IN W.-SIDE OF A 21" BURR OAK	N 02° E	62.47 FT.
2	SET A NAIL IN N.W.-SIDE OF AN 11" CHERRY	N 39° E	24.57 FT.
3	EX. P.K. NAIL IN S.W.-SIDE OF A 7-1/2" CEDAR	S 79° E	7.38 FT.
4	SET A NAIL IN S.W.-SIDE OF A 6-1/2" CEDAR	S 46° E	21.48 FT.

(NOT TO SCALE)

(WOODS)

S.W.-COR., SEC. 4-16-5.  
 EXISTING 6" SQUARE STONE WITH  
 THE TOP BROKEN OFF. IT'S ALMOST  
 FLUSH WITH THE GROUND, 1.5' NORTH  
 AND 3.5' EAST OF A DOWNED FENCE  
 CORNER. EX. SIGN & POST NEAR  
 THE CORNER.


(WOODS)

PLAN VIEW DRAWING OF REFERENCE TIES

MAP SHOWING DISTANCE AND DIRECTION TO OTHER PUBLIC LAND SURVEY CORNERS USED FOR REESTABLISHING THE CORNER

(GRID BEARINGS AND DISTANCES)  
 (GRID FACTOR: 0.99993145)  
 (NOT TO SCALE)

E. 1/4-COR., SEC. 5.

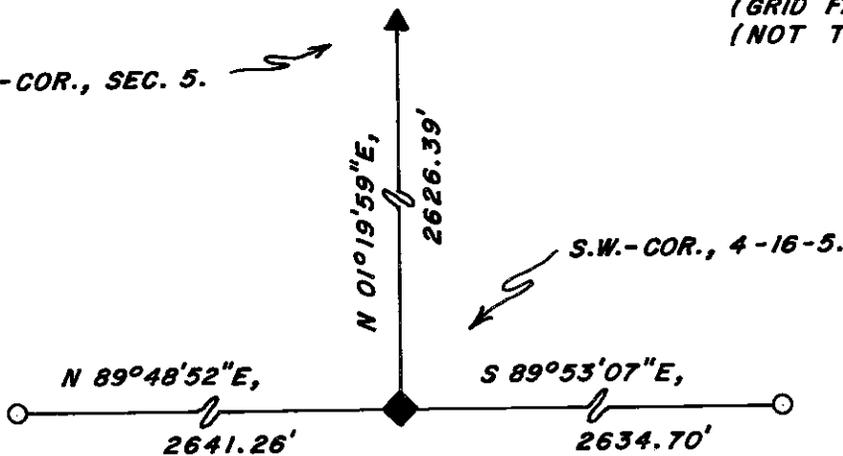


S. 1/4-COR., SEC. 5.

S. 1/4-COR., SEC. 4.

I, BRYAN H. MEYER, COUNTY SURVEYOR  
 HEREBY CERTIFY THAT THE CORNER LOCATION SHOWN ON THIS RECORD  
 WAS DETERMINED BY ME OR UNDER MY DIRECTION AND CONTROL AND  
 THAT THIS U. S. PUBLIC LAND SURVEY MONUMENT RECORD IS CORRECT  
 AND COMPLETE TO THE BEST OF MY KNOWLEDGE AND BELIEF.

Signature

Date

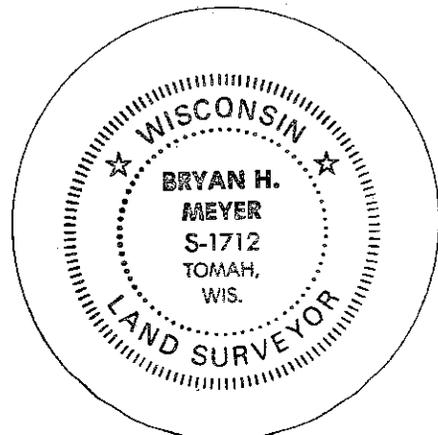

Seal


July 9, 2010

21605050000

U. S. PUBLIC LAND SURVEY MONUMENT RECORD

SECTION 4 T 16 N, R 5 W, TOWN OF BANGOR

LA CROSSE COUNTY

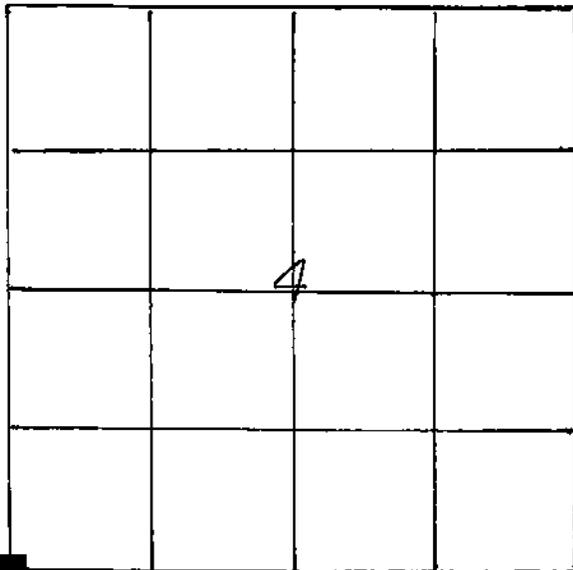

LOCATION OF LANDMARK

DATE: 10-17-86

CREW: BILL JUNG, PERRY DAHL  
JEFF BLUSKE

WISCONSIN COORDINATE SYSTEM

North

East

Theta Angle

Horiz. Order

Vert. Order

TYPE OF LANDMARK

STONE MONUMENT

BEARINGS ARE REFERENCED TO

True

Describe any record evidence, monument evidence, testimonial evidence or any other material evidence you considered and whether the monument was found or restored through acceptance of an obliterated evidence location.


I found a stone at the corner and accepted it as the best available evidence of the original government corner position.

Describe or show any material discrepancy between the location of the restored corner and that of the corner previously restored or reestablished.

None known.

RECORD OF DURABLE WITNESS MONUMENTS  
MAGNETIC

NO	DESCRIPTION	BEARING	DISTANCE
1	P.K. NAIL IN DOUBLE-BLAZED 18" OAK	N2°E	62.5'
2	P.K. NAIL IN DOUBLE-BLAZED 5" CEDAR	S79°E	7.38'
3	P.K. NAIL IN DOUBLE-BLAZED 15" BASSWD.	S39°W	19.6'
4	P.K. NAIL IN DOUBLE-BLAZED 17" BASSWD.	S24°W	28.29'

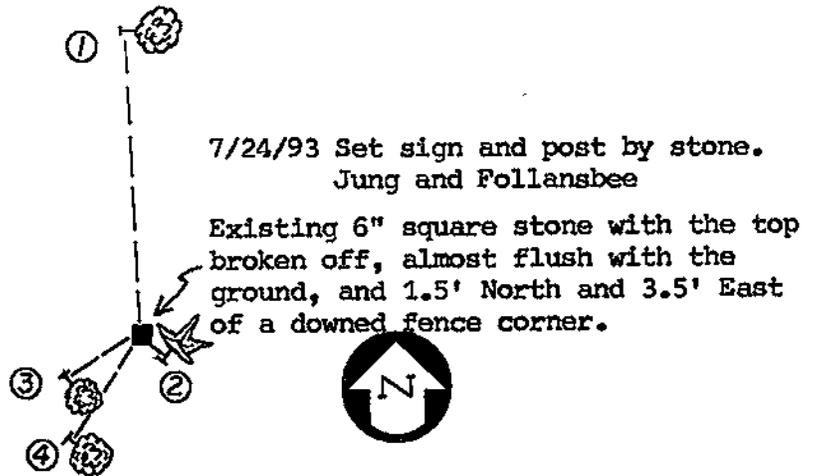


(not to scale)

PLAN VIEW DRAWING OF REFERENCE TIES



MAP SHOWING DISTANCE AND DIRECTION TO OTHER PUBLIC LAND SURVEY CORNERS USED FOR REESTABLISHING THE CORNER

(not to scale)

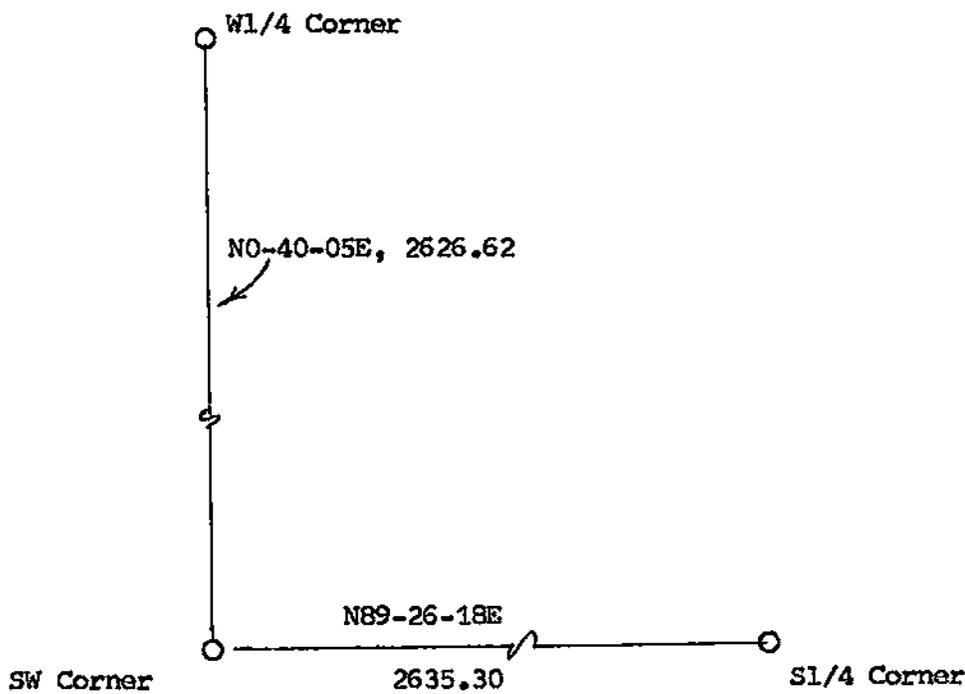


I, William C. Jung, Deputy County Surveyor,  
HEREBY CERTIFY THAT THE CORNER LOCATION SHOWN ON THIS RECORD  
WAS DETERMINED BY ME OR UNDER MY DIRECTION AND CONTROL AND  
THAT THIS U. S. PUBLIC LAND SURVEY MONUMENT RECORD IS CORRECT  
AND COMPLETE TO THE BEST OF MY KNOWLEDGE AND BELIEF.

William C. Jung  
Signature

March 10, 1987  
Date

Revised: 1/18/94  
wcy

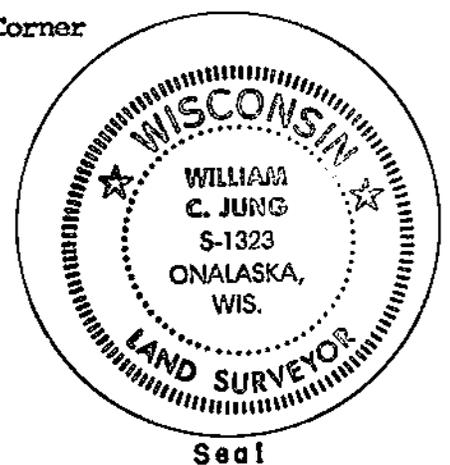

Seal