


21605050020

## U. S. PUBLIC LAND SURVEY MONUMENT RECORD

SECTION 5 T 16 N, R 5 W, TOWN OF BANGOR  
 LA CROSSE COUNTY

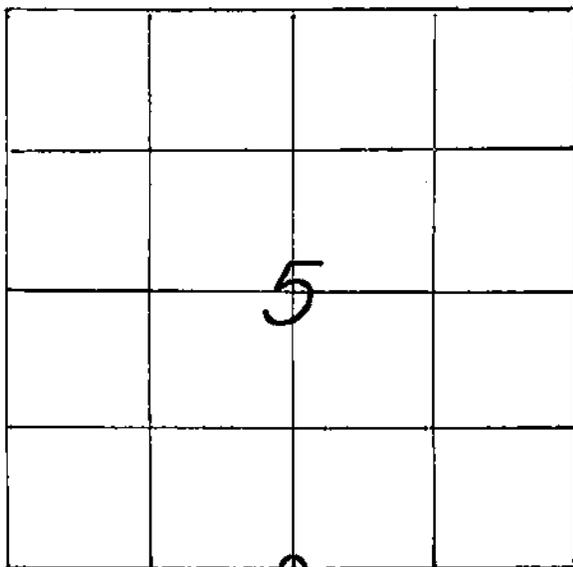

LOCATION OF LANDMARK

CREW: WILLIAM C. JUNG  
 PETER F. FOLLANSBEE  
 DATE: 9/22/1997

## WISCONSIN COORDINATE SYSTEM

North

East

Theta Angle

Horiz. Order

Vert. Order

## TYPE OF LANDMARK

1-1/4" IRON PIPE (I.D.)

BEARINGS ARE REFERENCED TO

TRUE NORTH ( $\pm 02'$ )

Describe any record evidence, monument evidence, testimonial evidence or any other material evidence you considered and whether the monument was found or restored through acceptance of an obliterated evidence location.


I set this corner by single proportionate measurement and monumented it with an iron pipe.

Describe or show any material discrepancy between the location of the restored corner and that of the corner previously restored or reestablished.

Harley Sime surveyed the site to the Southwest in June of 1966. I do not match his 1/4 corner location.


RECORD OF DURABLE WITNESS MONUMENTS  
MAGNETIC

NO	DESCRIPTION	BEARING	DISTANCE
1	S.E.-COR. OF 18" SQUARE CONCRETE PEDESTAL FOR LIGHT POLE	S 43° W	96.65 FT.
2	N.E.-COR. OF 36" x 32" STEEL STORM DRAIN	S 78° W	48.19 FT.
3	SET A CAPPED 1" x 6" I.P. NEAR WEST END OF MEDIAN ISLAND	N 70° W	34.27 FT.
4	SET A DRILL HOLE IN A CONCRETE MEDIAN ISLAND	N 69° E	33.72 FT.

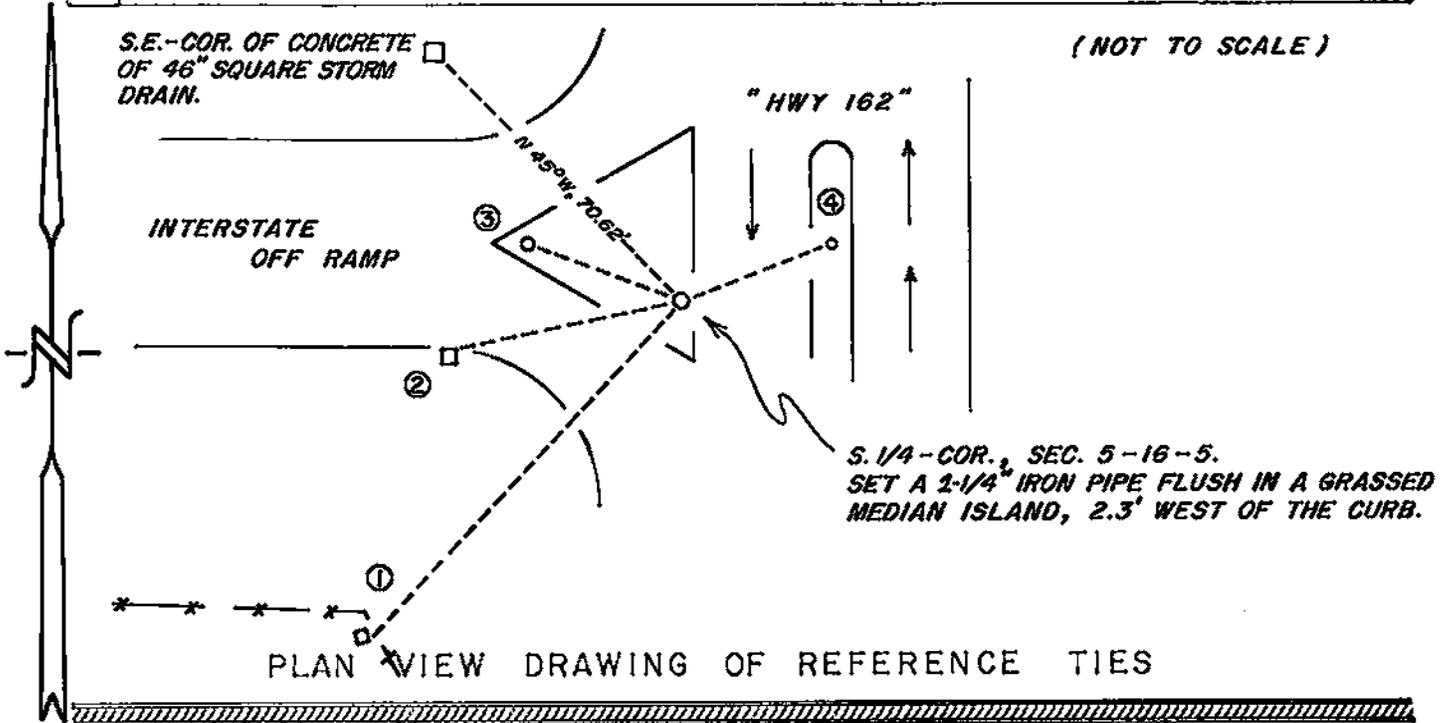

MAP SHOWING DISTANCE AND DIRECTION TO OTHER PUBLIC LAND SURVEY CORNERS USED FOR REESTABLISHING THE CORNER

(not to scale)

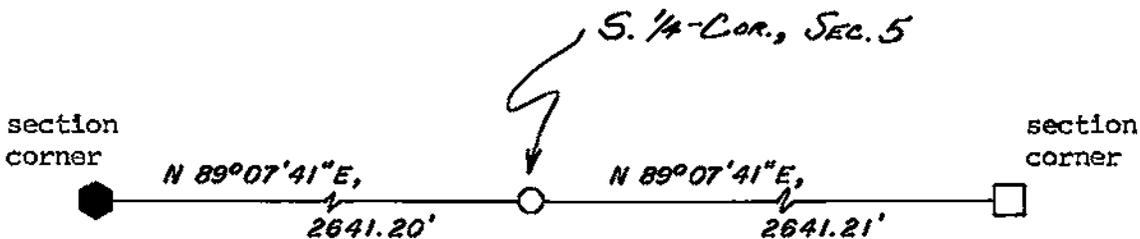

I, WILLIAM C. JUNG, COUNTY SURVEYOR  
HEREBY CERTIFY THAT THE CORNER LOCATION SHOWN ON THIS RECORD WAS DETERMINED BY ME OR UNDER MY DIRECTION AND CONTROL AND THAT THIS U. S. PUBLIC LAND SURVEY MONUMENT RECORD IS CORRECT AND COMPLETE TO THE BEST OF MY KNOWLEDGE AND BELIEF.

William C. Jung March 5, 1998  
Signature Date



Seal