


U. S. PUBLIC LAND SURVEY MONUMENT RECORD

SECTION 4 T 16 N, R 5 W, ^{VILLAGE}~~TOWN~~ OF BANGOR

LA CROSSE COUNTY

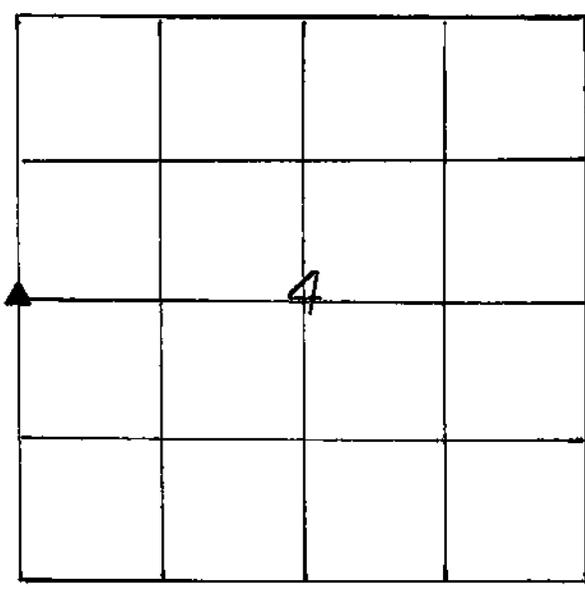

WISCONSIN COORDINATE SYSTEM
North
East
Theta Angle
Horiz. Order
Vert. Order
TYPE OF LANDMARK
RAILROAD SPIKE
BEARINGS ARE REFERENCED TO
True

LOCATION OF LANDMARK
 DATE: 11-20-86
 CREW: BILL JUNG, PERRY DAHL

Date: 5-28-98
 Crew: Bill Jung, Pete Follansbee

9/17/03
 JEF

Describe any record evidence, monument evidence, testimonial evidence or any other material evidence you considered and whether the monument was found or restored through acceptance of an obliterated evidence location.

Using existing monuments to the South, I set the corner so as to fit the Assessor's Plat. This location also fits the evidence found along the West line of the section and the old railroad station map. I set a railroad spike at the corner. Based on my computations and the field evidence, I feel that this is the best location for this corner.


5-28-98 As the railroad spike at the corner had been knocked out, we set another railroad spike and took new ties.

Describe or show any material discrepancy between the location of the restored corner and that of the corner previously restored or reestablished.

This location is not exactly the same as the computed location that I show on my 1983 Plat of Survey for Dr. Larson.


RECORD OF DURABLE WITNESS MONUMENTS

NO	DESCRIPTION	BEARING	DISTANCE
1	CENTER OF MANHOLE	---	18.72'
2	N.E. CORNER OF COULEE FORD BUILDING	---	28.81'
3	IRON PIPE IN SIDEWALK	S0-29-12W	173.1'
4	IRON PIPE BEHIND SIDEWALK	S0-29-12W	270.6'
5	IRON PIPE	S0-29-12W	370.4'

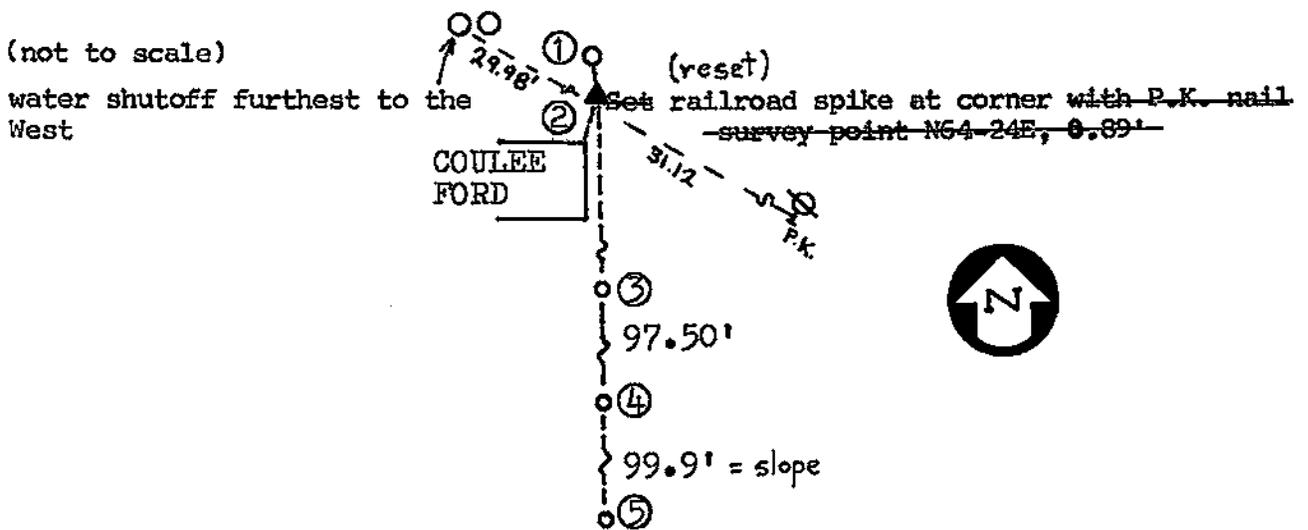

PLAN VIEW DRAWING OF REFERENCE TIES

MAP SHOWING DISTANCE AND DIRECTION TO OTHER PUBLIC LAND SURVEY CORNERS USED FOR REESTABLISHING THE CORNER

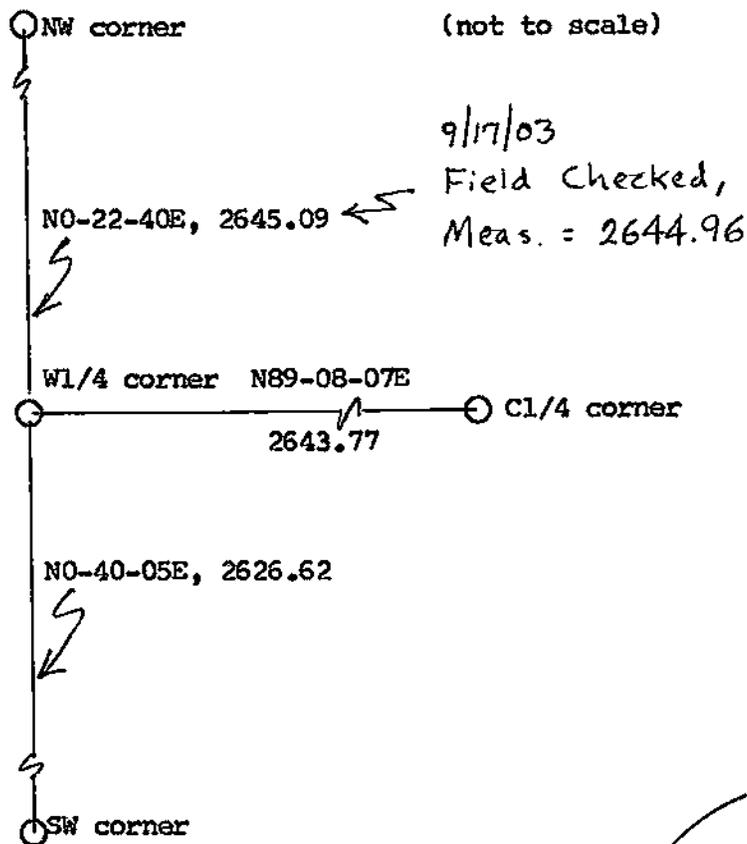


I, William C. Jung, Deputy County Surveyor,
HEREBY CERTIFY THAT THE CORNER LOCATION SHOWN ON THIS RECORD
WAS DETERMINED BY ME OR UNDER MY DIRECTION AND CONTROL AND
THAT THIS U. S. PUBLIC LAND SURVEY MONUMENT RECORD IS CORRECT
AND COMPLETE TO THE BEST OF MY KNOWLEDGE AND BELIEF.

William C. Jung
Signature

March 18, 1987
Date

Revised: 3/25/99 *W.C.J.*
" 1/27/04 *W.C.J.*

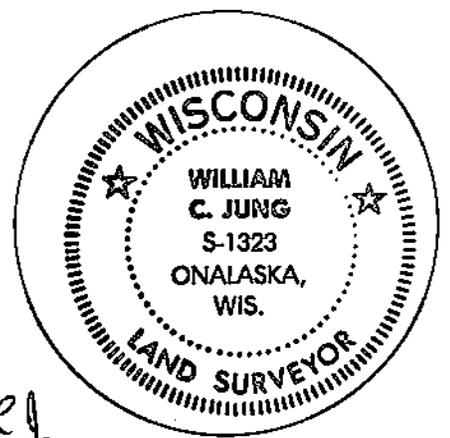

Seal