


U. S. PUBLIC LAND SURVEY MONUMENT RECORD

SECTION 6 T 16 N, R 5 W, TOWN OF BANGOR

LA CROSSE COUNTY

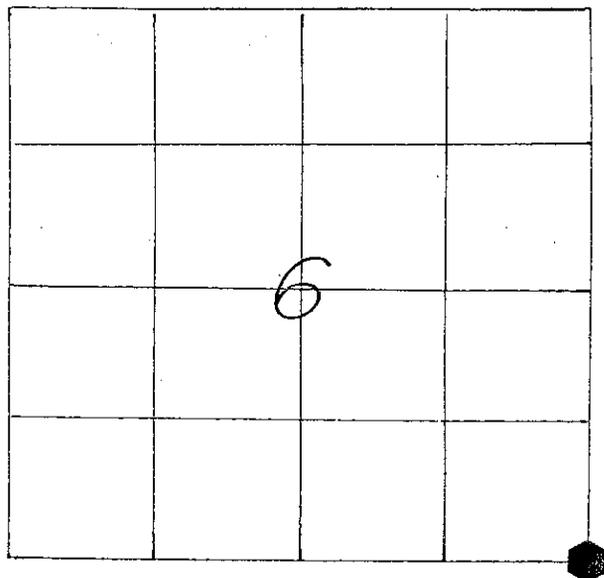

LOCATION OF LANDMARK

CREW: WILLIAM C. JUNG
 PETER F. FOLLANSBEE
 DATE: 9/09/1997

WISCONSIN COORDINATE SYSTEM	
North	688,464.757
East	1,702,057.854
Theta Angle	
Horiz. Order	
Vert. Order	
Datum:	NAD 1983 ('91)
TYPE OF LANDMARK	
3/4" X 30" ROUND IRON BAR.	
BEARINGS ARE REFERENCED TO	
Grid North as per Section Data.	

Revised: 10/22/2009
 Bryan H. Meyer
 Peter F. Follansbee

Describe any record evidence, monument evidence, testimonial evidence or any other material evidence you considered and whether the monument was found or restored through acceptance of an obliterated evidence location.


After thoroughly analyzing all of the section data in the four surrounding sections, I set this corner at a computed location that best fits the existing field evidence and section measurements. I set an iron bar at the corner.

Describe or show any material discrepancy between the location of the restored corner and that of the corner previously restored or reestablished.


NONE KNOWN.

RECORD OF DURABLE WITNESS MONUMENTS

NO	DESCRIPTION	BEARING	DISTANCE
1	3/4" X 15" ROUND IRON BAR, DOWN 3", 2' OFF PAVT.	N' WESTERLY ±	30.05 Ft.
2	3/4" X 15" ROUND IRON BAR, DOWN 3", 2' OFF PAVT.	N' EASTERLY ±	30.02 Ft.
3	3/4" X 15" ROUND IRON BAR, DOWN 3", 2' OFF PAVT.	S' EASTERLY ±	30.05 Ft.
4	3/4" X 15" ROUND IRON BAR, DOWN 3", 2' OFF PAVT.	S' WESTERLY ±	30.07 Ft.

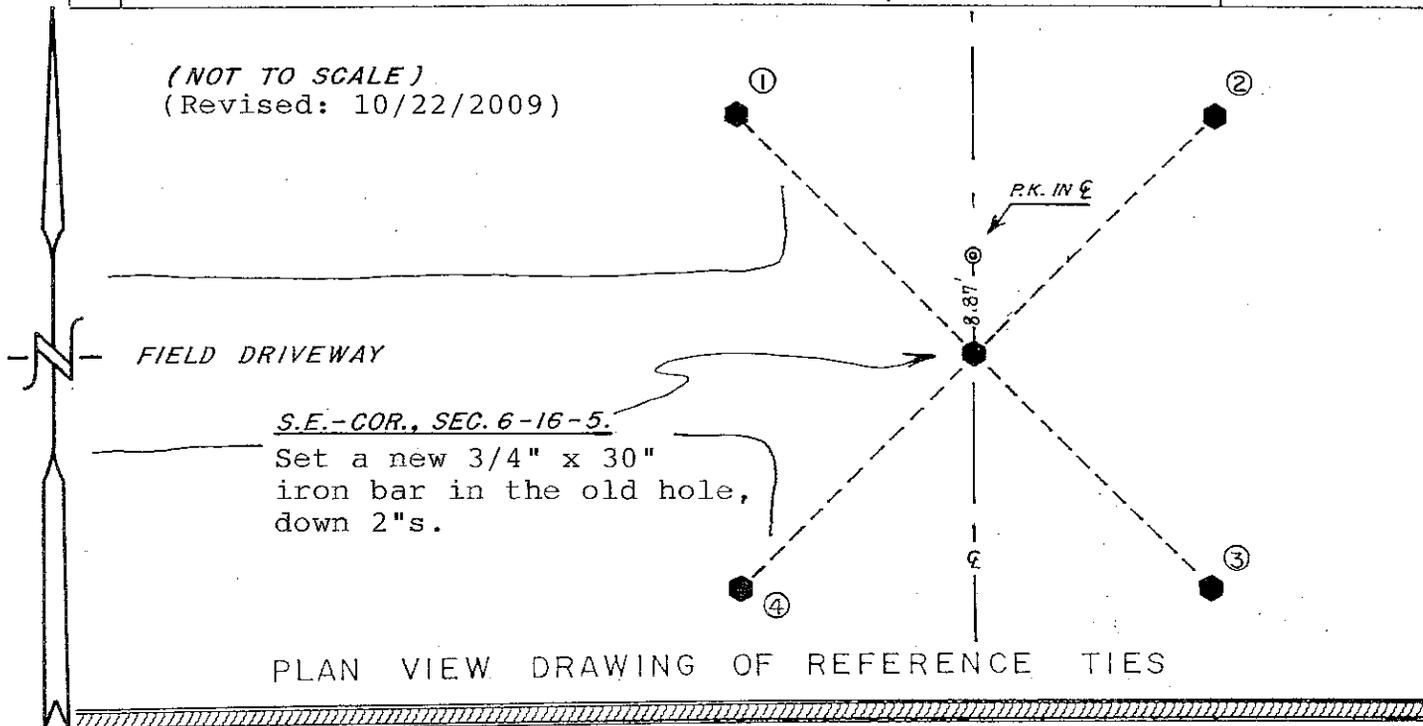

MAP SHOWING DISTANCE AND DIRECTION TO OTHER PUBLIC LAND SURVEY CORNERS USED FOR REESTABLISHING THE CORNER

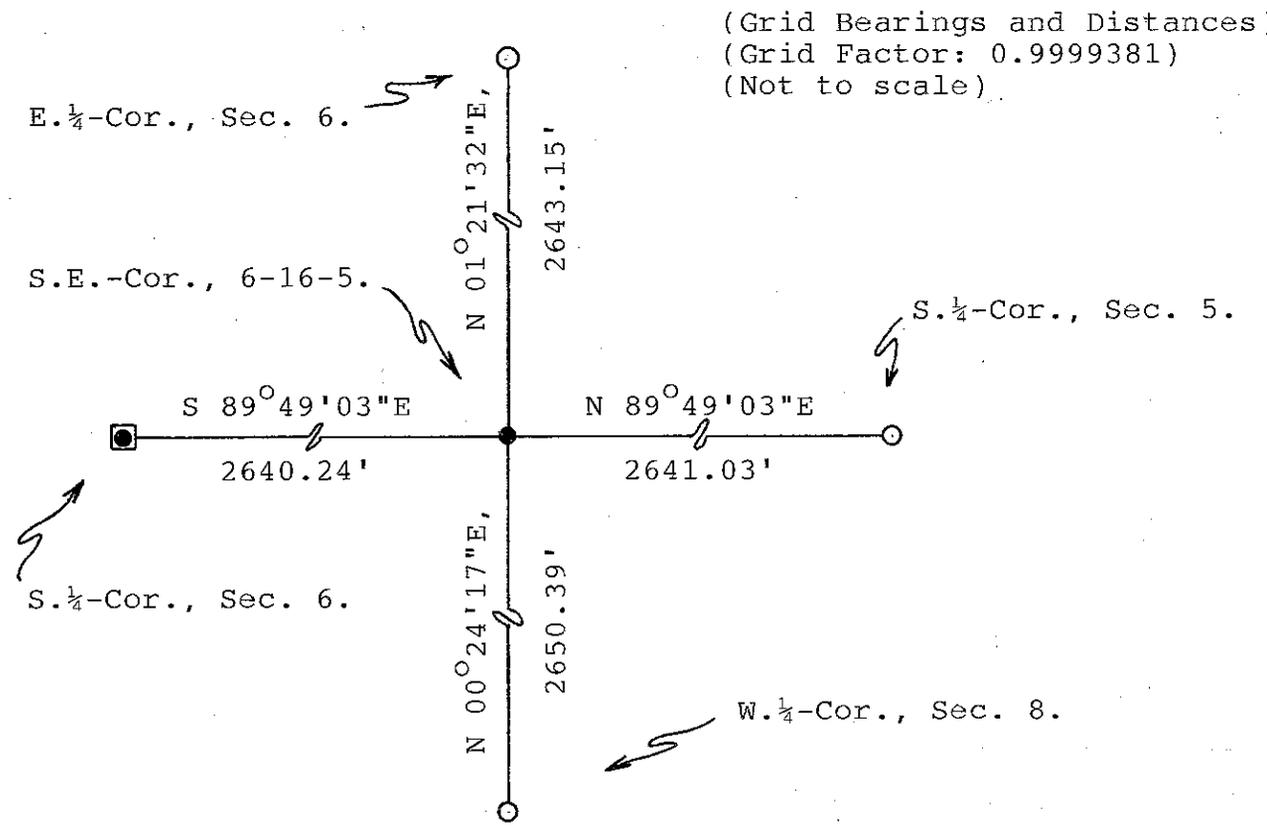


I, _____
HEREBY CERTIFY THAT THE CORNER LOCATION SHOWN ON THIS RECORD
WAS DETERMINED BY ME OR UNDER MY DIRECTION AND CONTROL AND
THAT THIS U. S. PUBLIC LAND SURVEY MONUMENT RECORD IS CORRECT
AND COMPLETE TO THE BEST OF MY KNOWLEDGE AND BELIEF.

Signature _____ Date _____

21605060000

U. S. PUBLIC LAND SURVEY MONUMENT RECORD

SECTION 6 T 16 N, R 5 W, TOWN OF BANGOR
 LA CROSSE COUNTY

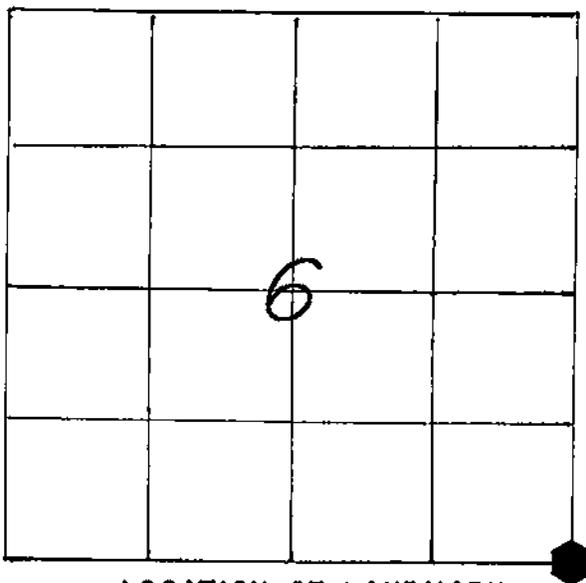

LOCATION OF LANDMARK

CREW: WILLIAM C. JUNG
 PETER F. FOLLANSBEE
 DATE: 9/09/1997

WISCONSIN COORDINATE SYSTEM
North
East
Theta Angle
Horiz. Order
Vert. Order
TYPE OF LANDMARK
3/4" X 30" ROUND IRON BAR.
BEARINGS ARE REFERENCED TO
TRUE NORTH ($\pm 02'$)

Describe any record evidence, monument evidence, testimonial evidence or any other material evidence you considered and whether the monument was found or restored through acceptance of an obliterated evidence location.


After thoroughly analyzing all of the section data in the four surrounding sections, I set this corner at a computed location that best fits the existing field evidence and section measurements. I set an iron bar at the corner.

Describe or show any material discrepancy between the location of the restored corner and that of the corner previously restored or reestablished.

NONE KNOWN.


RECORD OF DURABLE WITNESS MONUMENTS

NO	DESCRIPTION	BEARING	DISTANCE
1	SET 3/4" X 15" ROUND IRON BAR, DOWN 3", 2' OFF PAVT.	N' WESTERLY ±	30.02 FT.
2	SET 3/4" X 15" ROUND IRON BAR, DOWN 3", 2' OFF PAVT.	N' EASTERLY ±	29.99 FT.
3	SET 3/4" X 15" ROUND IRON BAR, DOWN 3", 2' OFF PAVT.	S' EASTERLY ±	30.01 FT.
4	SET 3/4" X 15" ROUND IRON BAR, DOWN 3", 2' OFF PAVT.	S' WESTERLY ±	30.00 FT.

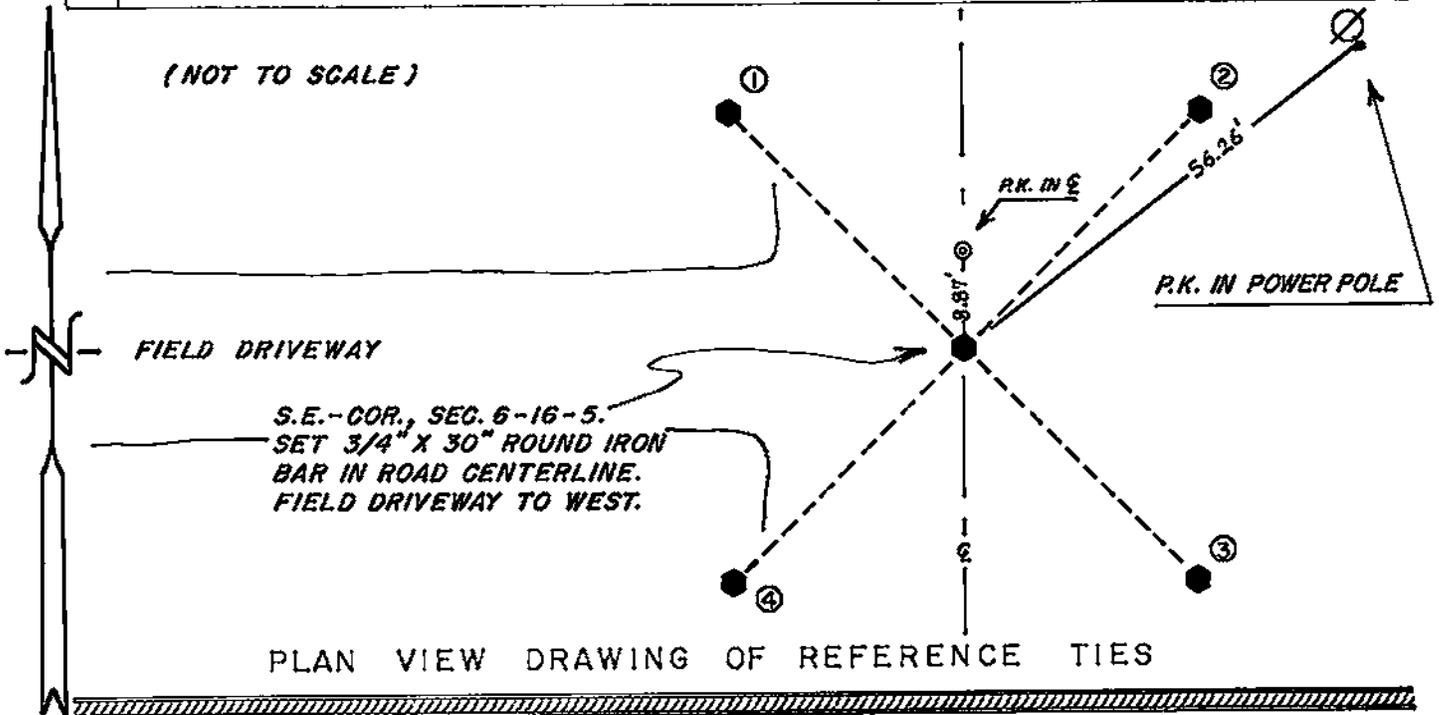

MAP SHOWING DISTANCE AND DIRECTION TO OTHER PUBLIC LAND SURVEY CORNERS USED FOR REESTABLISHING THE CORNER

(not to scale)

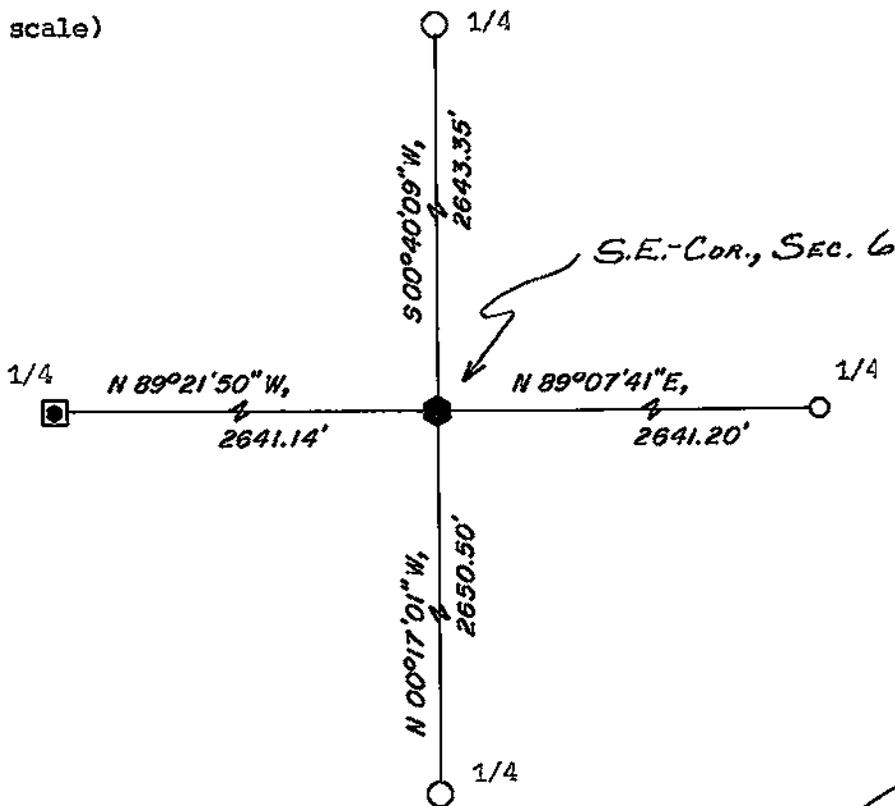

I, WILLIAM G. JUNG, COUNTY SURVEYOR
HEREBY CERTIFY THAT THE CORNER LOCATION SHOWN ON THIS RECORD WAS DETERMINED BY ME OR UNDER MY DIRECTION AND CONTROL AND THAT THIS U. S. PUBLIC LAND SURVEY MONUMENT RECORD IS CORRECT AND COMPLETE TO THE BEST OF MY KNOWLEDGE AND BELIEF.

William G. Jung March 5, 1998
Signature Date



Seal