


21605060020

## U. S. PUBLIC LAND SURVEY MONUMENT RECORD

SECTION 6 T 16 N, R 5 W, TOWN OF BANGOR

LA CROSSE COUNTY

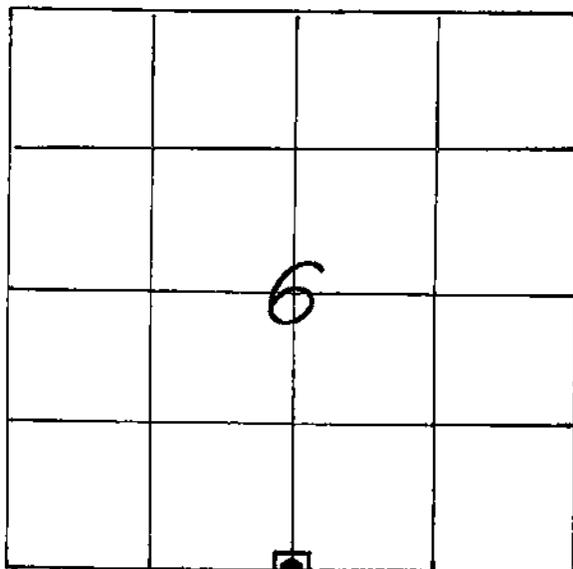

LOCATION OF LANDMARK

CREW: WILLIAM C. JUNG  
 PETER F. FOLLANSBEE  
 DATE: 8/05/1997

WISCONSIN COORDINATE SYSTEM

North

East

Theta Angle

Horiz. Order

Vert. Order

TYPE OF LANDMARK

5/16" ROUND IRON BAR IN STONE.

BEARINGS ARE REFERENCED TO

TRUE NORTH. ( $\pm 02'$ )

Describe any record evidence, monument evidence, testimonial evidence or any other material evidence you considered and whether the monument was found or restored through acceptance of an obliterated evidence location.


I found Bliss' old 1867 stone of record, set an iron bar in it, and tied it off.

Describe or show any material discrepancy between the location of the restored corner and that of the corner previously restored or reestablished.

NONE KNOWN.


RECORD OF DURABLE WITNESS MONUMENTS

NO	DESCRIPTION	BEARING	DISTANCE
1	SET A 1" X 30" IRON PIPE IN THE FENCELINE	NORTH ±	10.00 FT.
2	SET A 1" X 30" IRON PIPE IN THE FENCELINE	EAST ±	10.00 FT.
3	SET A 1-1/4" X 30" IRON PIPE	S. EAST ±	10.00 FT.
4	SET A 1" X 30" IRON PIPE ON LINE WITH FENCE TO NORTH	SOUTH ±	10.00 FT.

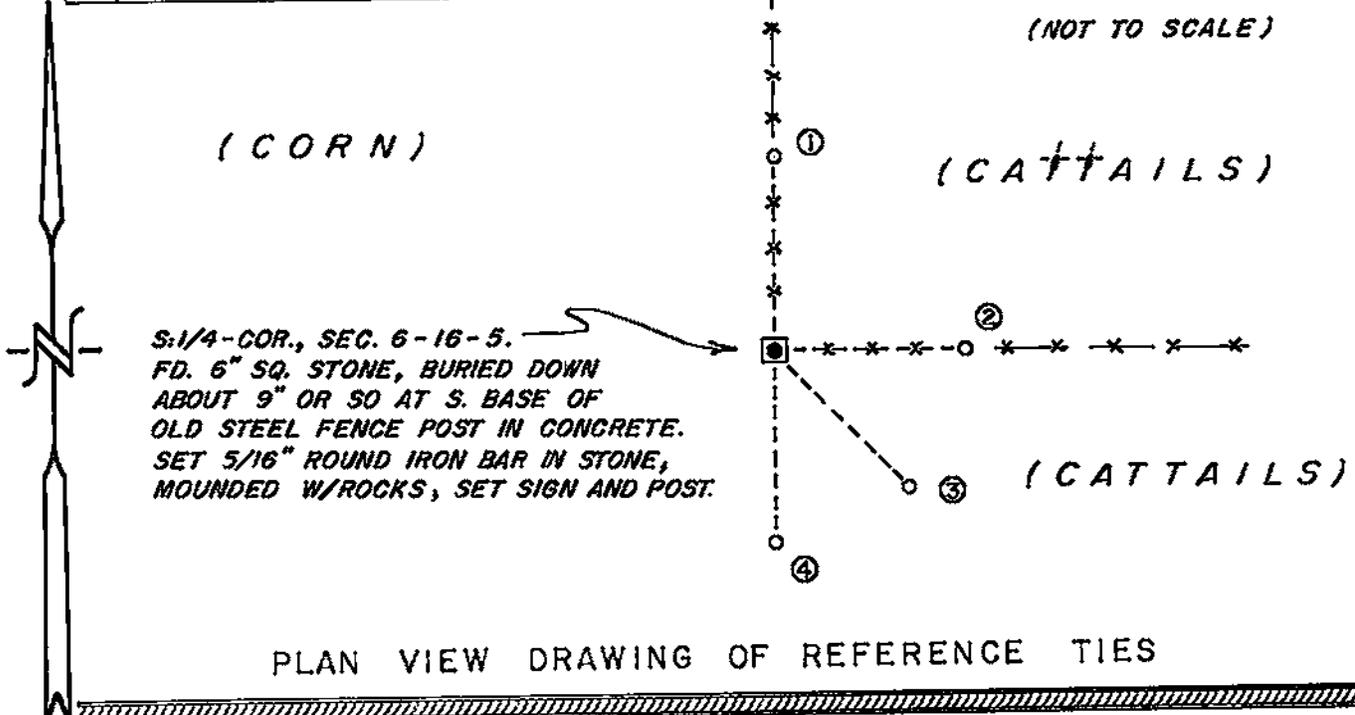

MAP SHOWING DISTANCE AND DIRECTION TO OTHER PUBLIC LAND SURVEY CORNERS USED FOR REESTABLISHING THE CORNER

(not to scale)

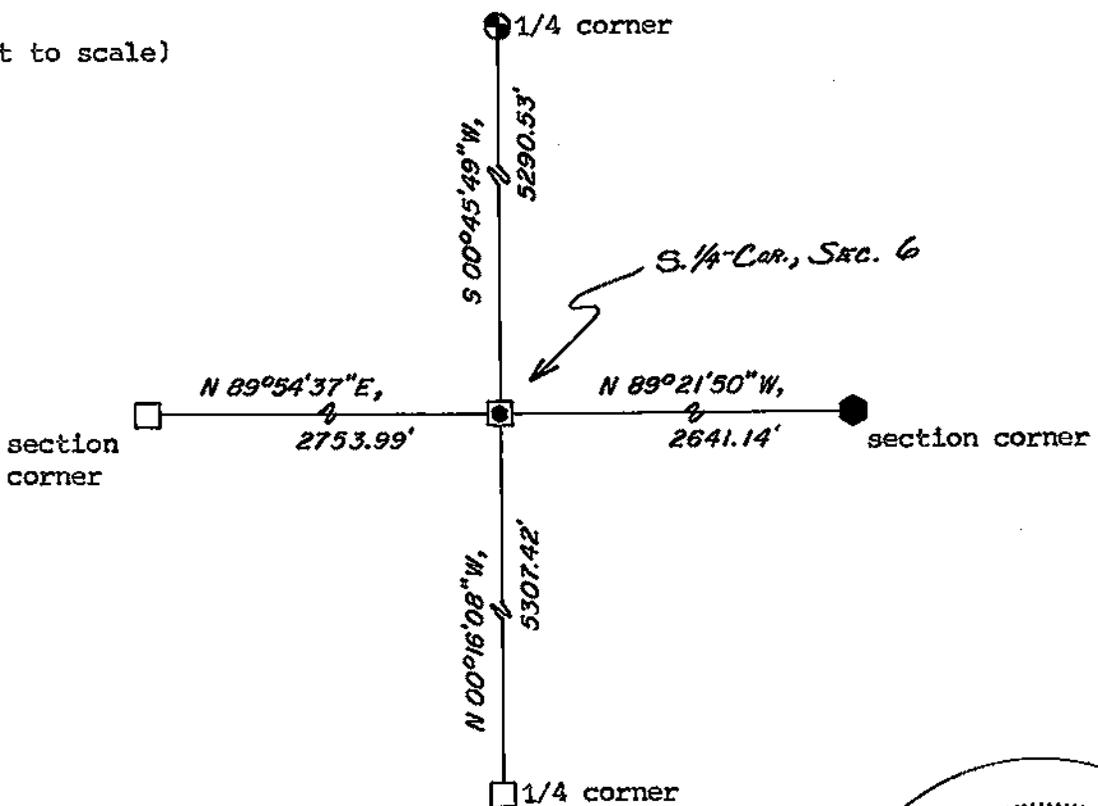

I, WILLIAM C. JUNG, COUNTY SURVEYOR  
 HEREBY CERTIFY THAT THE CORNER LOCATION SHOWN ON THIS RECORD WAS DETERMINED BY ME OR UNDER MY DIRECTION AND CONTROL AND THAT THIS U. S. PUBLIC LAND SURVEY MONUMENT RECORD IS CORRECT AND COMPLETE TO THE BEST OF MY KNOWLEDGE AND BELIEF.

William C. Jung  
 Signature

March 5, 1998  
 Date



Seal