


21605062000

## U. S. PUBLIC LAND SURVEY MONUMENT RECORD

SECTION 6 T 16 N, R 5 W, TOWN OF BANGOR

LA CROSSE COUNTY

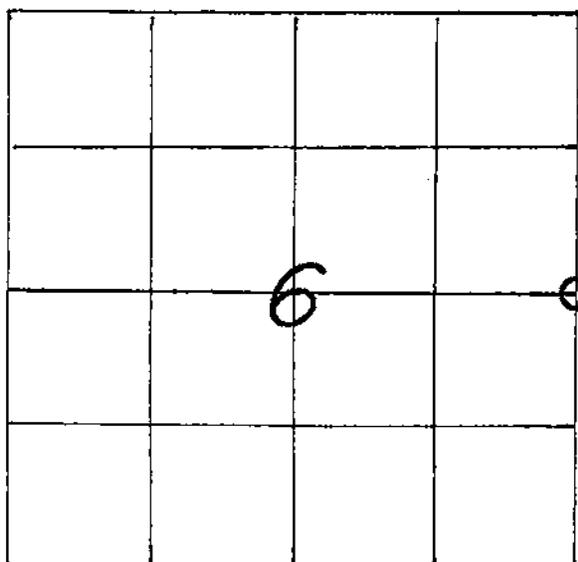

WISCONSIN COORDINATE SYSTEM

North

East

Theta Angle

Horiz. Order

Vert. Order

TYPE OF LANDMARK

2-1/2" x 36" IRON PIPE (Ø.D.)

BEARINGS ARE REFERENCED TO

TRUE NORTH ( $\pm 02'$ )

## LOCATION OF LANDMARK

CREW: WILLIAM C. JUNG  
 PETER F. FOLLANSBEE  
 DATE: 9/18/1997

Describe any record evidence, monument evidence, testimonial evidence or any other material evidence you considered and whether the monument was found or restored through acceptance of an obliterated evidence location.


I set this corner on line with the old line fence to the North and proportionately between the section corners. This fits the old records and occupation very well. We dug and searched at great length for the old stone, but had no luck. We set an iron pipe at the corner.

Describe or show any material discrepancy between the location of the restored corner and that of the corner previously restored or reestablished.

*NONE KNOWN.*


RECORD OF DURABLE WITNESS MONUMENTS

NO	DESCRIPTION	BEARING	DISTANCE
1	DISTANCE TO THE CENTER OF TRACK BETWEEN RAILS	NORTH ±	25.1 FT.
2	SET A NAIL IN S.W.-SIDE MULTI-TRUNK ELM(DBL. BLAZED)	S 55° E (MAG.)	41.61 FT.
3	SET A 1" x 26-1/2" IRON PIPE (ON LINE)	SOUTH ±	29.16 FT.
4	SET A NAIL IN S.E.-SIDE 13" MAPLE (DBL. BLAZED)	S 50° W (MAG.)	33.12 FT.

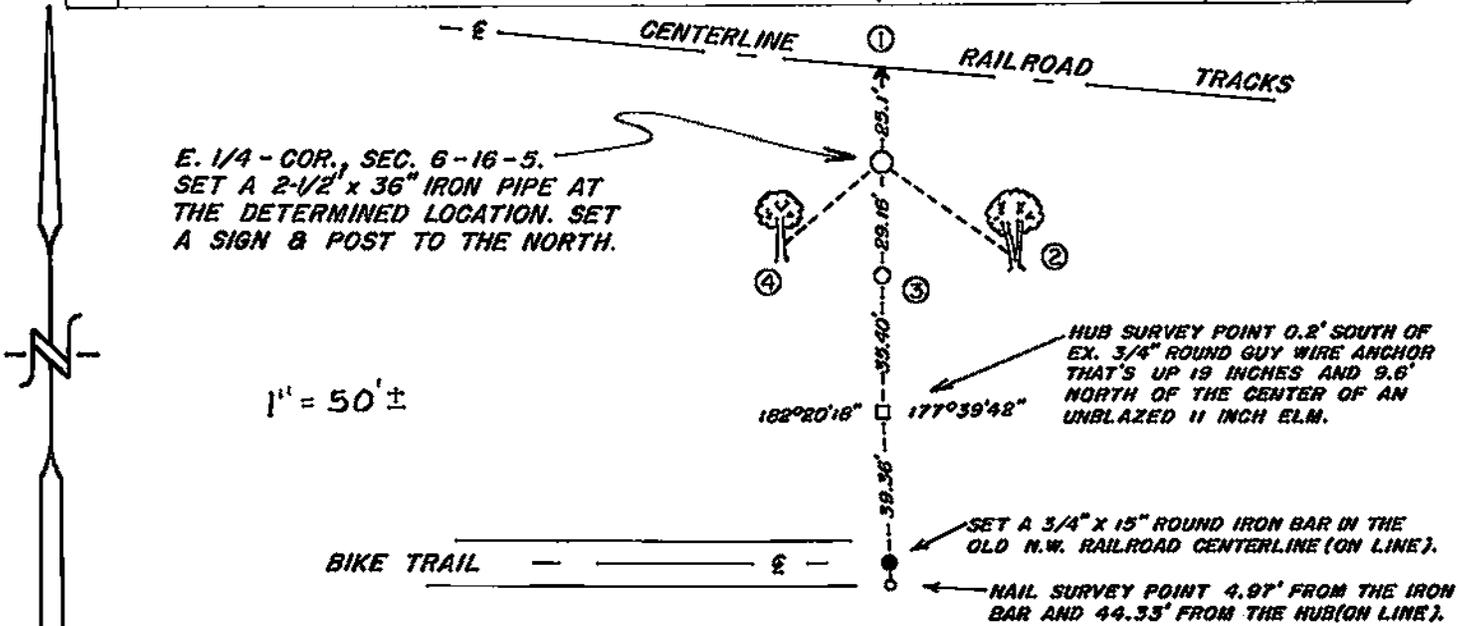


PLAN VIEW DRAWING OF REFERENCE TIES

MAP SHOWING DISTANCE AND DIRECTION TO OTHER PUBLIC LAND SURVEY CORNERS USED FOR REESTABLISHING THE CORNER

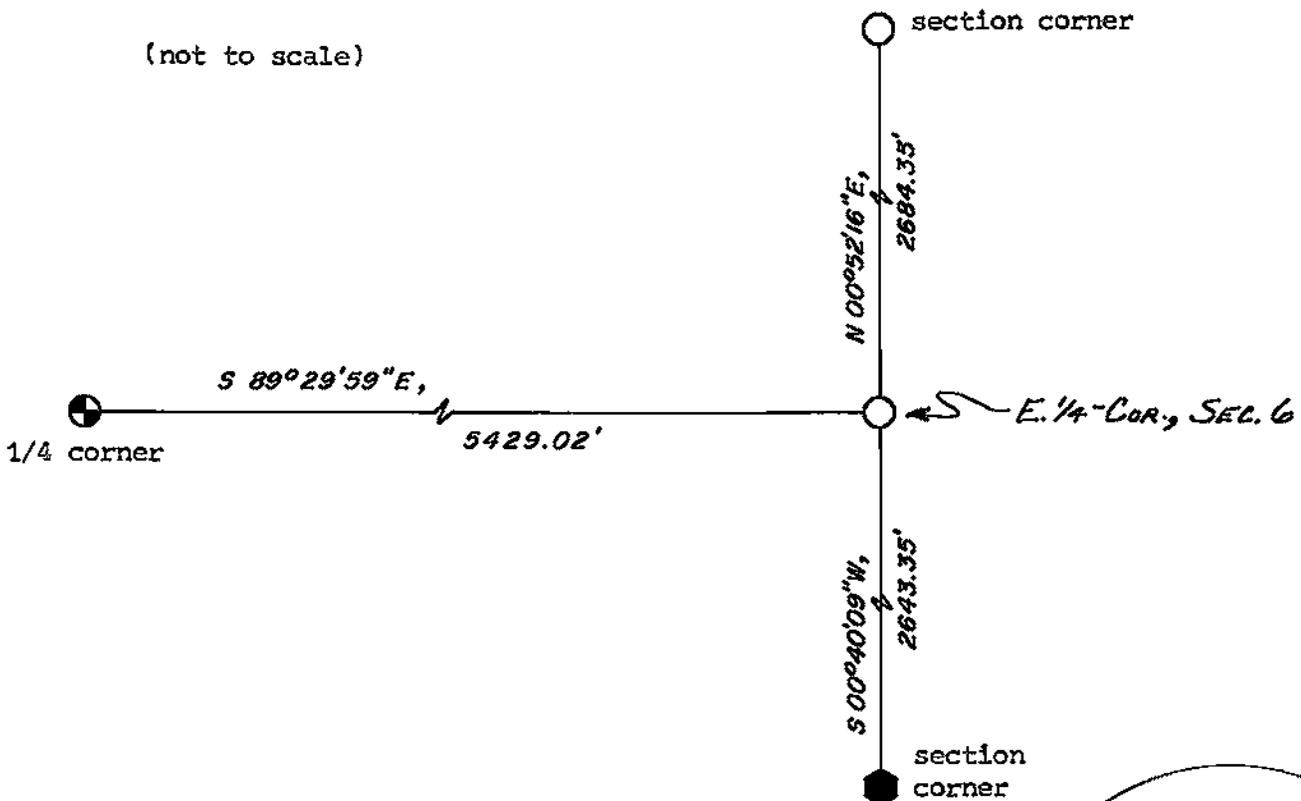

I, WILLIAM C. JUNG, COUNTY SURVEYOR  
 HEREBY CERTIFY THAT THE CORNER LOCATION SHOWN ON THIS RECORD WAS DETERMINED BY ME OR UNDER MY DIRECTION AND CONTROL AND THAT THIS U. S. PUBLIC LAND SURVEY MONUMENT RECORD IS CORRECT AND COMPLETE TO THE BEST OF MY KNOWLEDGE AND BELIEF.

William C. Jung March 5, 1998  
 Signature Date

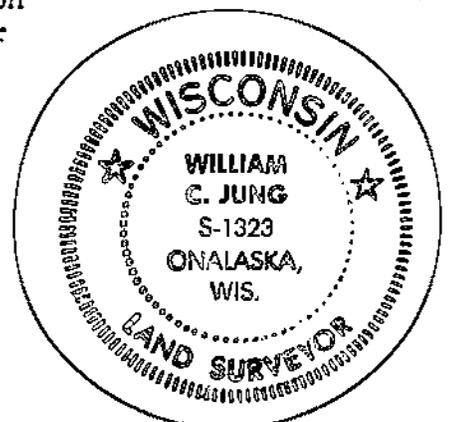

Seal