


21605070000

## U. S. PUBLIC LAND SURVEY MONUMENT RECORD

SECTION 17 T 16 N, R 5 W, TOWN OF BANGOR

LA CROSSE COUNTY

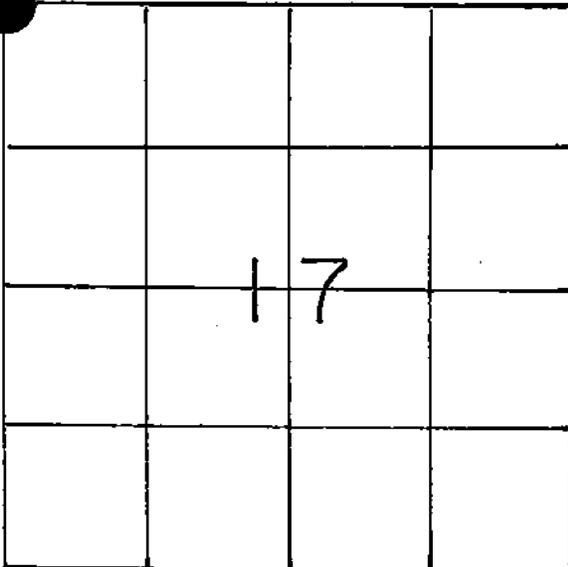

LOCATION OF LANDMARK

Crew: WILLIAM C. JUNG  
PETER F. FOLLANSBEE

Date: 5/16/1989

Describe any record evidence, monument evidence, testimonial evidence or any other material evidence you considered and whether the monument was found or restored through acceptance of an obliterated evidence location.

I found a stone at the corner which I accepted as the best available evidence of the original government corner. The corner was a scribed 6" square stone, up 8", and broken in three pieces. I plumbed the stone up, put the pieces together, and tied it off with wire. I set a Lunde marker 5" to the Northwest of the stone center. The Lunde is a witness marker only. The stone is 5' North of the fence.

Describe or show any material discrepancy between the location of the restored corner and that of the corner previously restored or reestablished.

NONE KNOWN

## WISCONSIN COORDINATE SYSTEM

North

East

Theta Angle

Horiz. Order

Vert. Order

## TYPE OF LANDMARK

FOUND 6" SQUARE STONE

BEARINGS ARE REFERENCED TO

