


21605070020

U. S. PUBLIC LAND SURVEY MONUMENT RECORD

SECTION 7 T 16 N, R 5 W, TOWN OF BANGOR
 LA CROSSE COUNTY

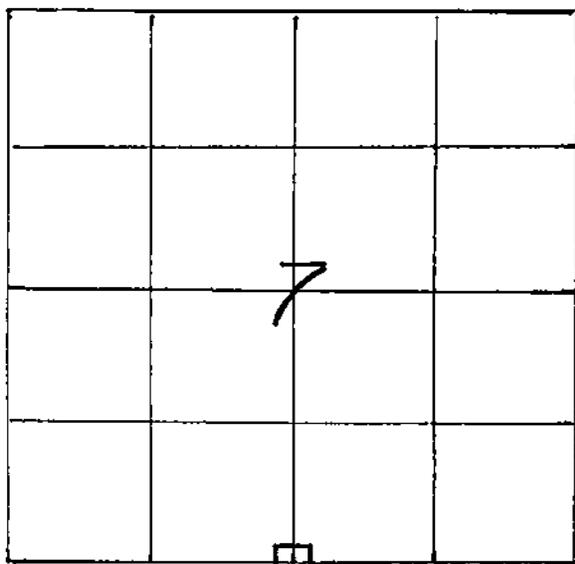

LOCATION OF LANDMARK

CREW: WILLIAM C. JUNG
 PETER F. FOLLANSBEE
 DATE: 8/07/1997

WISCONSIN COORDINATE SYSTEM

North

East

Theta Angle

Horiz. Order

Vert. Order

TYPE OF LANDMARK

6" SQ. STONE SPLIT IN 3 PIECES.

BEARINGS ARE REFERENCED TO

TRUE NORTH ($\pm 02'$)

Describe any record evidence, monument evidence, testimonial evidence or any other material evidence you considered and whether the monument was found or restored through acceptance of an obliterated evidence location.

I found Bliss' old 1867 stone of record and tied it off.

Describe or show any material discrepancy between the location of the restored corner and that of the corner previously restored or reestablished.

NONE KNOWN.

