


21605072000

U. S. PUBLIC LAND SURVEY MONUMENT RECORD

SECTION 7 T 16 N, R 5 W, TOWN OF BANGOR
 LA CROSSE COUNTY

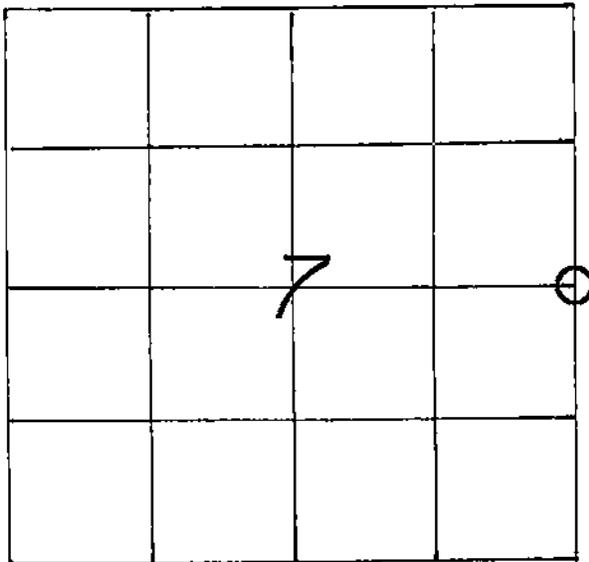

LOCATION OF LANDMARK

CREW: WILLIAM G. JUNG
 PETER F. FOLLANSBEE
 DATE: 9/09/1997

WISCONSIN COORDINATE SYSTEM

North

East

Theta Angle

Horiz. Order

Vert. Order

TYPE OF LANDMARK

2-1/2" X 29" IRON PIPE (O.D.)

BEARINGS ARE REFERENCED TO

TRUE NORTH ($\pm 02'$)

Describe any record evidence, monument evidence, testimonial evidence or any other material evidence you considered and whether the monument was found or restored through acceptance of an obliterated evidence location.


I accepted the occupied corner as the best available evidence of the original government corner position and monumented it with an iron pipe. I searched at length for the old stone of record, but had no luck.

Describe or show any material discrepancy between the location of the restored corner and that of the corner previously restored or reestablished.

NONE KNOWN.


RECORD OF DURABLE WITNESS MONUMENTS

NO	DESCRIPTION	BEARING	DISTANCE
1	SET A 3/4" x 15" ROUND IRON BAR 13 1/2' SOUTH OF CENTERLINE	S' WESTERLY ±	29.91 FT.
2	DISTANCE TO CENTER OF A STEEL FENCE POST IN CONCRETE	N 55° W (MAG.)	44.96 FT.
3	SET A 3/4" x 15" ROUND IRON BAR 15 1/2' EAST OF CENTERLINE	N' EASTERLY ±	30.11 FT.
4	SET A NAIL IN THE S-SIDE 9" CHERRY (UNBLAZED) (3' N. OF FENCE)	EASTERLY ±	62.23 FT.

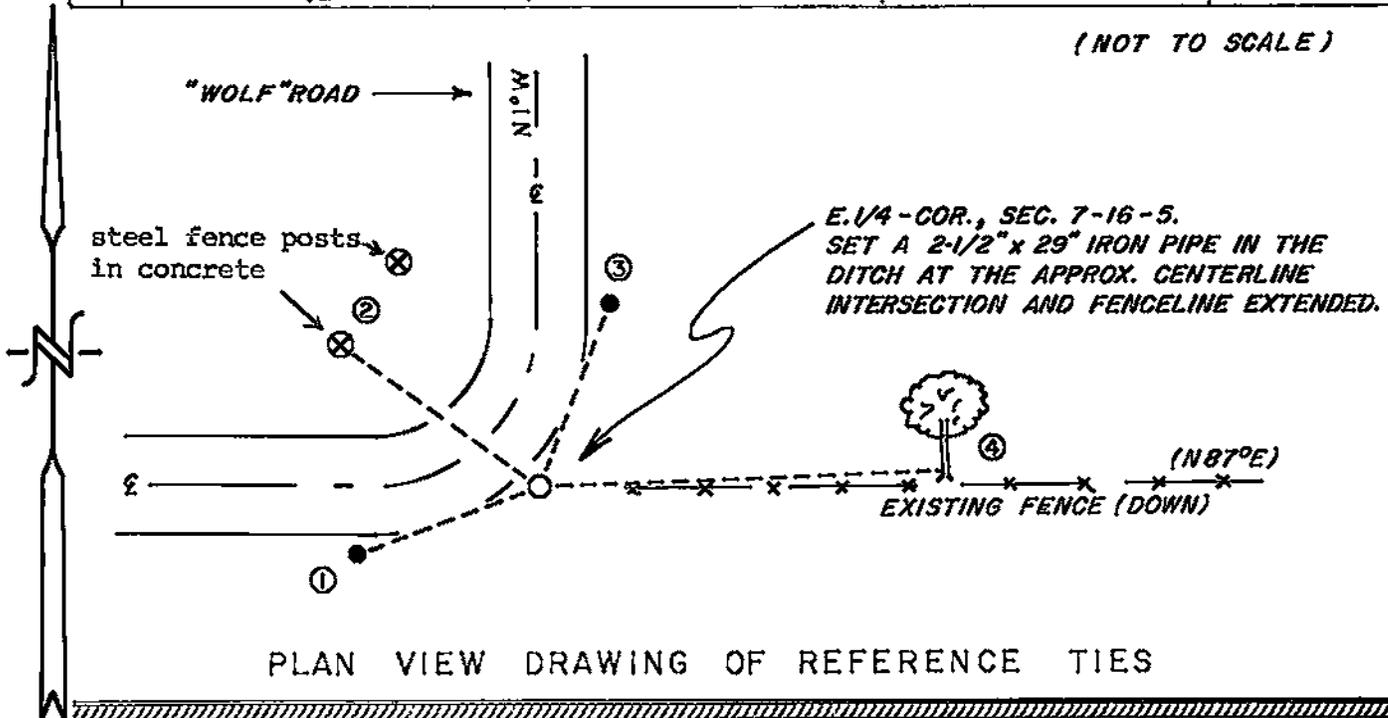

MAP SHOWING DISTANCE AND DIRECTION TO OTHER PUBLIC LAND SURVEY CORNERS USED FOR REESTABLISHING THE CORNER

(not to scale)

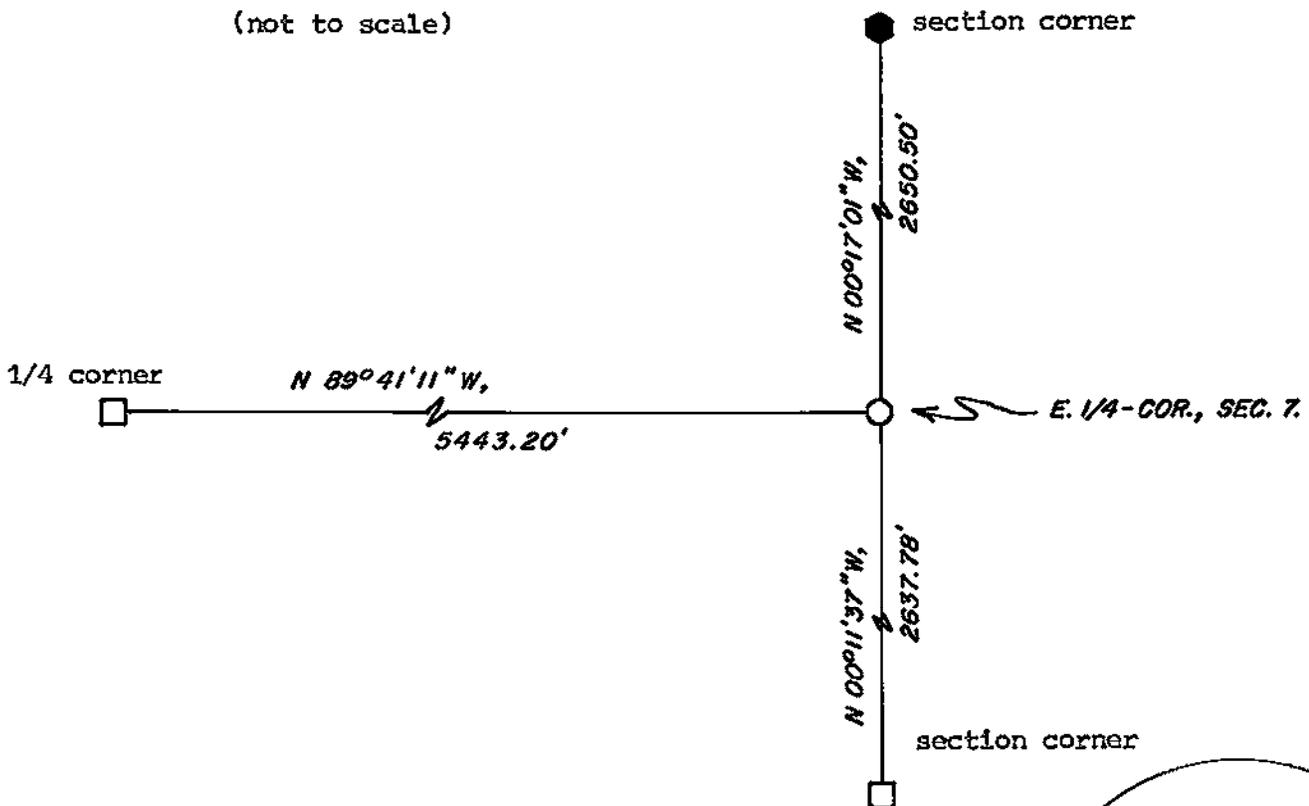

I, WILLIAM C. JUNG, COUNTY SURVEYOR
 HEREBY CERTIFY THAT THE CORNER LOCATION SHOWN ON THIS RECORD
 WAS DETERMINED BY ME OR UNDER MY DIRECTION AND CONTROL AND
 THAT THIS U. S. PUBLIC LAND SURVEY MONUMENT RECORD IS CORRECT
 AND COMPLETE TO THE BEST OF MY KNOWLEDGE AND BELIEF.

William C. Jung
 Signature

March 5, 1998
 Date



Seal