


U. S. PUBLIC LAND SURVEY MONUMENT RECORD

SECTION 9 T 16 N, R 5 W, TOWN OF BANGOR

LA CROSSE COUNTY

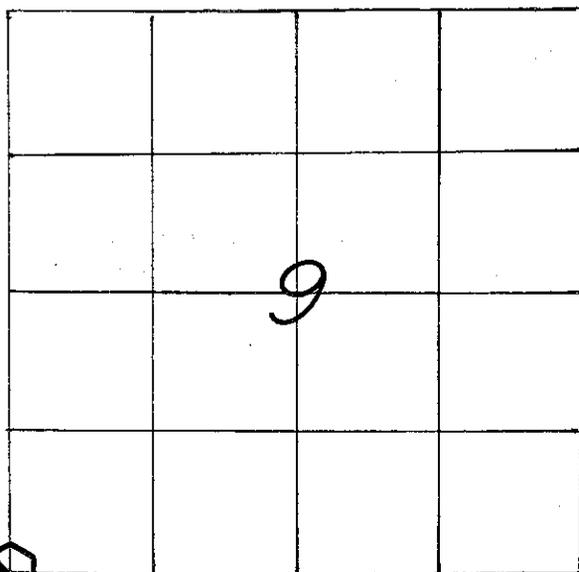

LOCATION OF LANDMARK

CREW: **BRYAN H. MEYER**
PETER F. FOLLANSBEE
 DATE: **11/11/2009**

| | |
|--|-----------------------|
| WISCONSIN COORDINATE SYSTEM | |
| North | 683,196.957 |
| East | 1,707,312.622 |
| Theta Angle | |
| Horiz. Order | |
| Vert. Order | |
| DATUM: | NAD 1983 ('91) |
| TYPE OF LANDMARK | |
| 30" ALUMINUM BERNTSEN MARKER. | |
| BEARINGS ARE REFERENCED TO | |
| GRID NORTH AS PER SECTION DATA. | |


Describe any record evidence, monument evidence, testimonial evidence or any other material evidence you considered and whether the monument was found or restored through acceptance of an obliterated evidence location.

Describe or show any material discrepancy between the location of the restored corner and that of the corner previously restored or reestablished.

RECORD OF DURABLE WITNESS MONUMENTS

MAGNETIC

| NO | DESCRIPTION | BEARING | DISTANCE |
|----|---|---------|----------------|
| 1 | SET A NAIL IN S.W.-SIDE OF AN 11-1/2" WHITE OAK | N 72° W | 40.24 FT. |
| 2 | SET A NAIL IN S.E.-SIDE OF A DOUBLE OAK | S 73° W | 30.17 FT. |
| 3 | EX. P.K. NAIL IN S.E.-SIDE OF A 19" WHITE OAK | S 12° W | SLOPE = 56.74' |
| 4 | SET A NAIL IN W.-SIDE OF A 19" RED OAK | S 03° E | 28.10 FT. |

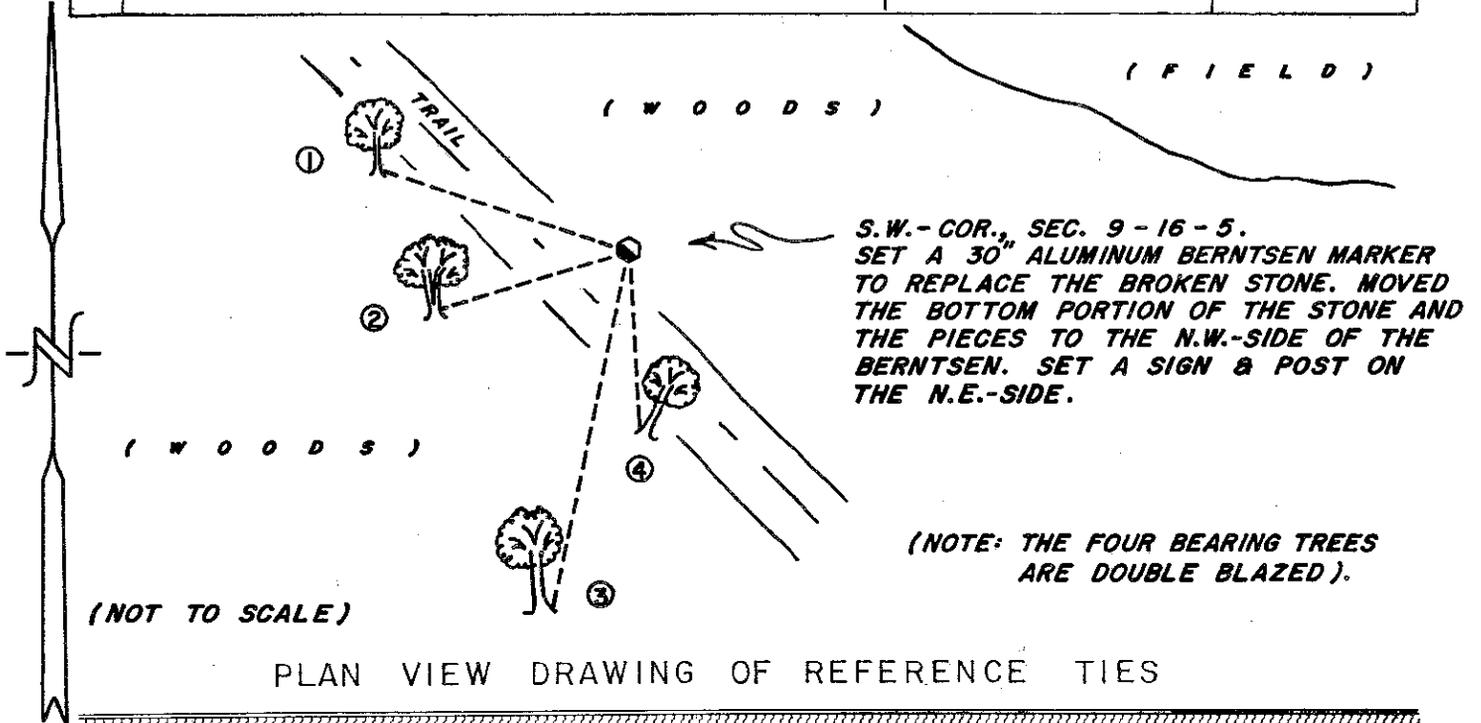


MAP SHOWING DISTANCE AND DIRECTION TO OTHER PUBLIC LAND SURVEY CORNERS USED FOR REESTABLISHING THE CORNER

I, BRYAN H. MEYER, COUNTY SURVEYOR
HEREBY CERTIFY THAT THE CORNER LOCATION SHOWN ON THIS RECORD WAS DETERMINED BY ME OR UNDER MY DIRECTION AND CONTROL AND THAT THIS U. S. PUBLIC LAND SURVEY MONUMENT RECORD IS CORRECT AND COMPLETE TO THE BEST OF MY KNOWLEDGE AND BELIEF.

Bryan H. Meyer
Signature

July 9, 2010
Date

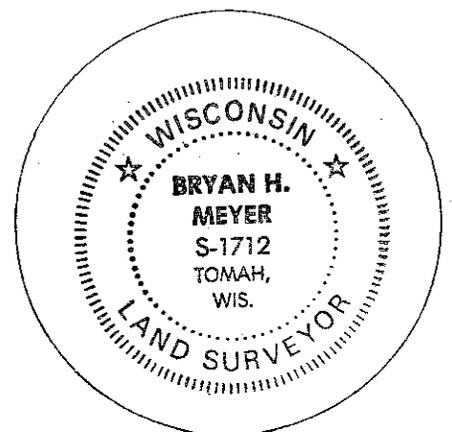


Seal

21605080000

U. S. PUBLIC LAND SURVEY MONUMENT RECORD

SECTION 9 T 16 N, R 5 W, TOWN OF Bangor

LA CROSSE COUNTY

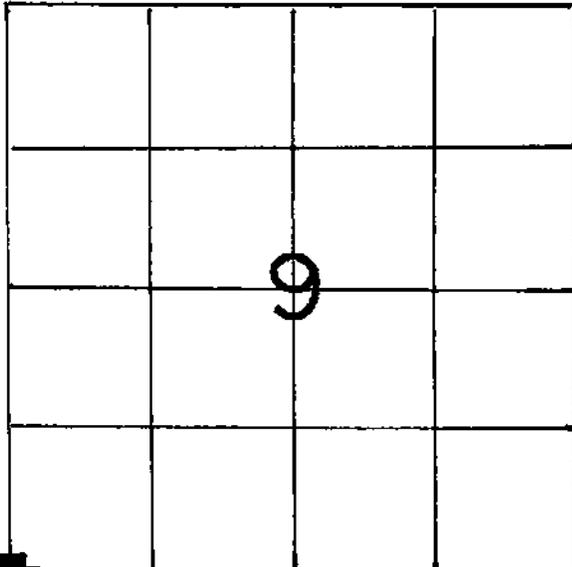

LOCATION OF LANDMARK

Crew: William C. Jung
Peter Follansbee

Date: 10/26/88

Describe any record evidence, monument evidence, testimonial evidence or any other material evidence you considered and whether the monument was found or restored through acceptance of an obliterated evidence location.

I found a 6" square scribed stone at the corner and accepted it as the best available evidence of the original government corner position. The stone is on the North side of the trail. I buried a whiskey bottle with an empty M-16 cartridge on the Northeast side of the stone.

Describe or show any material discrepancy between the location of the restored corner and that of the corner previously restored or reestablished.

None known.

WISCONSIN COORDINATE SYSTEM

North

East

Theta Angle

Horiz. Order

Vert. Order

TYPE OF LANDMARK

Stone

BEARINGS ARE REFERENCED TO

True

