


U. S. PUBLIC LAND SURVEY MONUMENT RECORD

SECTION 17 T 16 N, R 5 W, TOWN OF BANGOR

LA CROSSE COUNTY

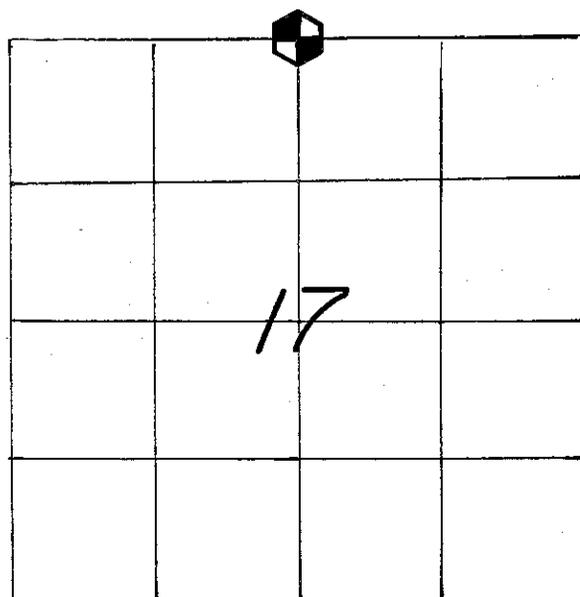

LOCATION OF LANDMARK

CREW: **BRYAN H. MEYER**
PETER F. FOLLANSBEE
 DATE: **5/03/2010**

WISCONSIN COORDINATE SYSTEM	
North	683,188.822
East	1,704,665.010
Theta Angle	
Horiz. Order	
Vert. Order	
DATUM:	1983('91)
TYPE OF LANDMARK	
BRASS CAP LUNDE MARKER.	
BEARINGS ARE REFERENCED TO	
GRID NORTH AS PER SECTION DATA.	

Describe any record evidence, monument evidence, testimonial evidence or any other material evidence you considered and whether the monument was found or restored through acceptance of an obliterated evidence location.

Describe or show any material discrepancy between the location of the restored corner and that of the corner previously restored or reestablished.


RECORD OF DURABLE WITNESS MONUMENTS

MAGNETIC

NO	DESCRIPTION	BEARING	DISTANCE
1	EX. 1" IRON PIPE	WEST ±	33.22 FT.
2	EX. 1-1/2" IRON PIPE, UP 1'	N 08° W	0.85 FT.
3	RESET AN EX. 1" IRON PIPE	EAST ±	32.82 FT.
4	EX. P.K. NAIL IN S.W.-SIDE OF A POWER POLE	S 48° E	22.55 FT.


(NOT TO SCALE)

(FIELD)

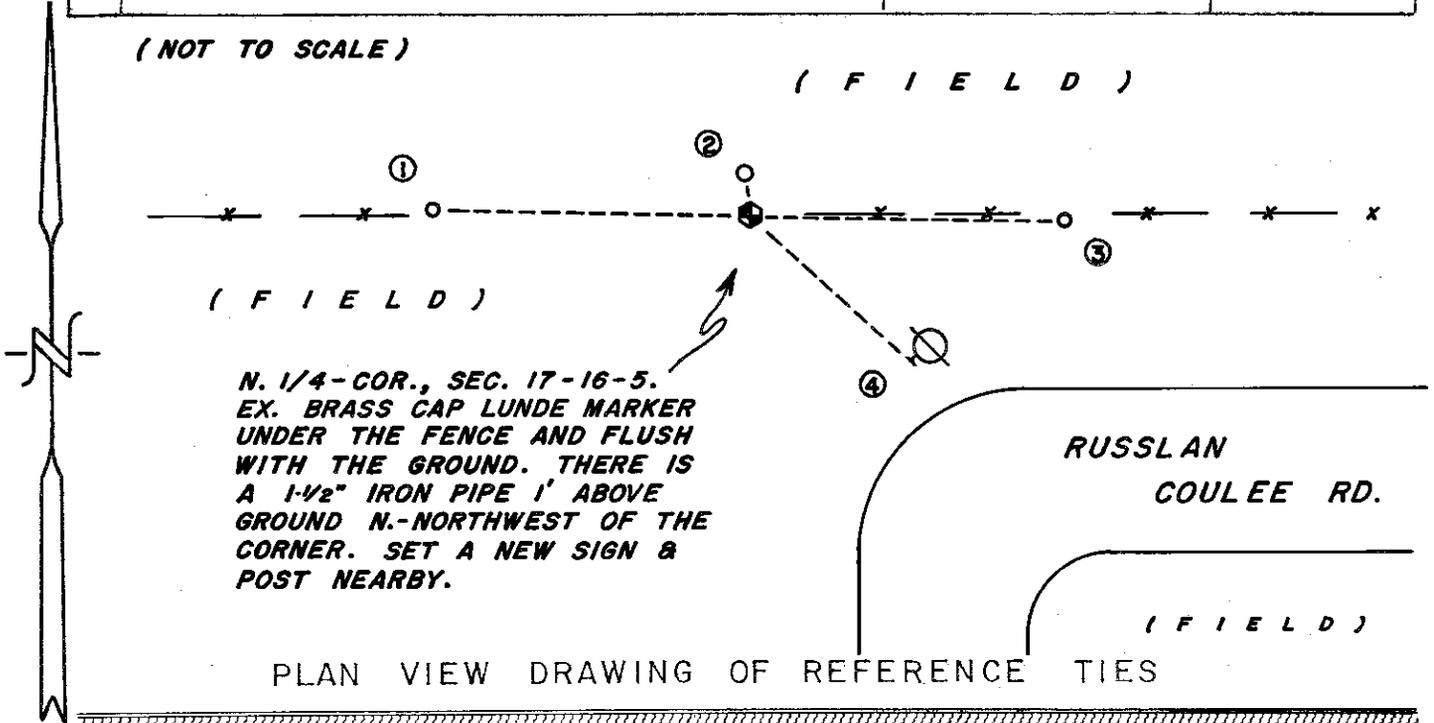

MAP SHOWING DISTANCE AND DIRECTION TO OTHER PUBLIC LAND SURVEY CORNERS USED FOR REESTABLISHING THE CORNER

(GRID BEARINGS AND DISTANCES)
(GRID FACTOR: 0.9999381)
(NOT TO SCALE)

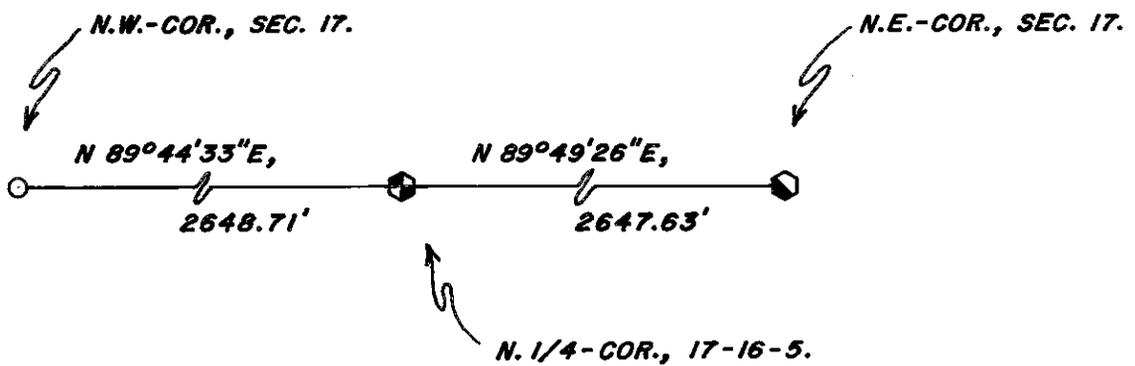

I, BRYAN H. MEYER, COUNTY SURVEYOR
HEREBY CERTIFY THAT THE CORNER LOCATION SHOWN ON THIS RECORD WAS DETERMINED BY ME OR UNDER MY DIRECTION AND CONTROL AND THAT THIS U. S. PUBLIC LAND SURVEY MONUMENT RECORD IS CORRECT AND COMPLETE TO THE BEST OF MY KNOWLEDGE AND BELIEF.

Signature

Date

Bryan H. Meyer 7/14/2010




Seal

21605080020

U. S. PUBLIC LAND SURVEY MONUMENT RECORD

SECTION 17 T 16 N, R 5 W, TOWN OF Bangor

LA CROSSE COUNTY

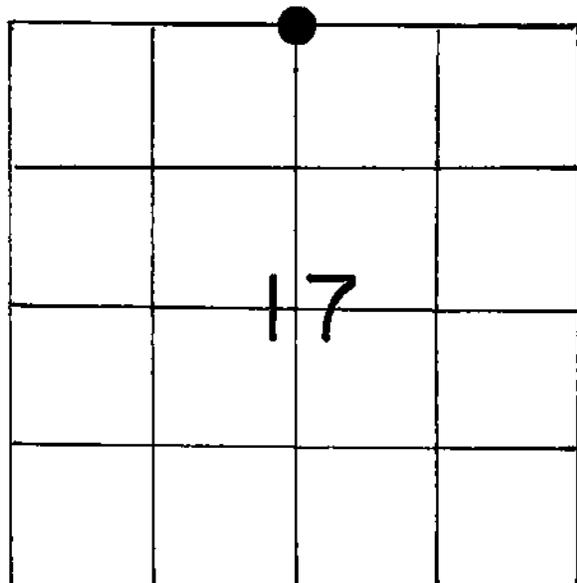

LOCATION OF LANDMARK

Crew: William C. Jung
Peter Follansbee

Date: 10/26/89

WISCONSIN COORDINATE SYSTEM

North

East

Theta Angle

Horiz. Order

Vert. Order

TYPE OF LANDMARK

Brass capped Lunde marker

BEARINGS ARE REFERENCED TO

Crew: William C. Jung
Peter Follansbee

Date: May 26, 1992

Describe any record evidence, monument evidence, testimonial evidence or any other material evidence you considered and whether the monument was found or restored through acceptance of an obliterated evidence location.

I set this corner in cooperation with Mid-State Associates, Inc. I found the stones at the NW and NE corners, and they traversed the mile. Their computations show the fence to be very close. Mr. Zurbuchen said that this line was surveyed years ago (by Woods?) and that the fence was built on the line. He also said that he put the pipe in and that it was not the corner. Using the Mid-State measurements, I set the corner equidistant between the section corner stones and on line with the old E-W fence. The corner is about 10" North of a straight line between the stones.


A post with a sign was set near the corner in May of 1992.

Describe or show any material discrepancy between the location of the restored corner and that of the corner previously restored or reestablished.

None known.


RECORD OF DURABLE WITNESS MONUMENTS

NO	DESCRIPTION	BEARING	DISTANCE
1	Set 1" iron pipe	West _±	33.17
2	Existing 1½" iron pipe, up 1'	N8°W	0.90
3	Set 1" iron pipe	East _±	32.88
4	Set P.K. nail on SW side of power pole	S48°E	22.49

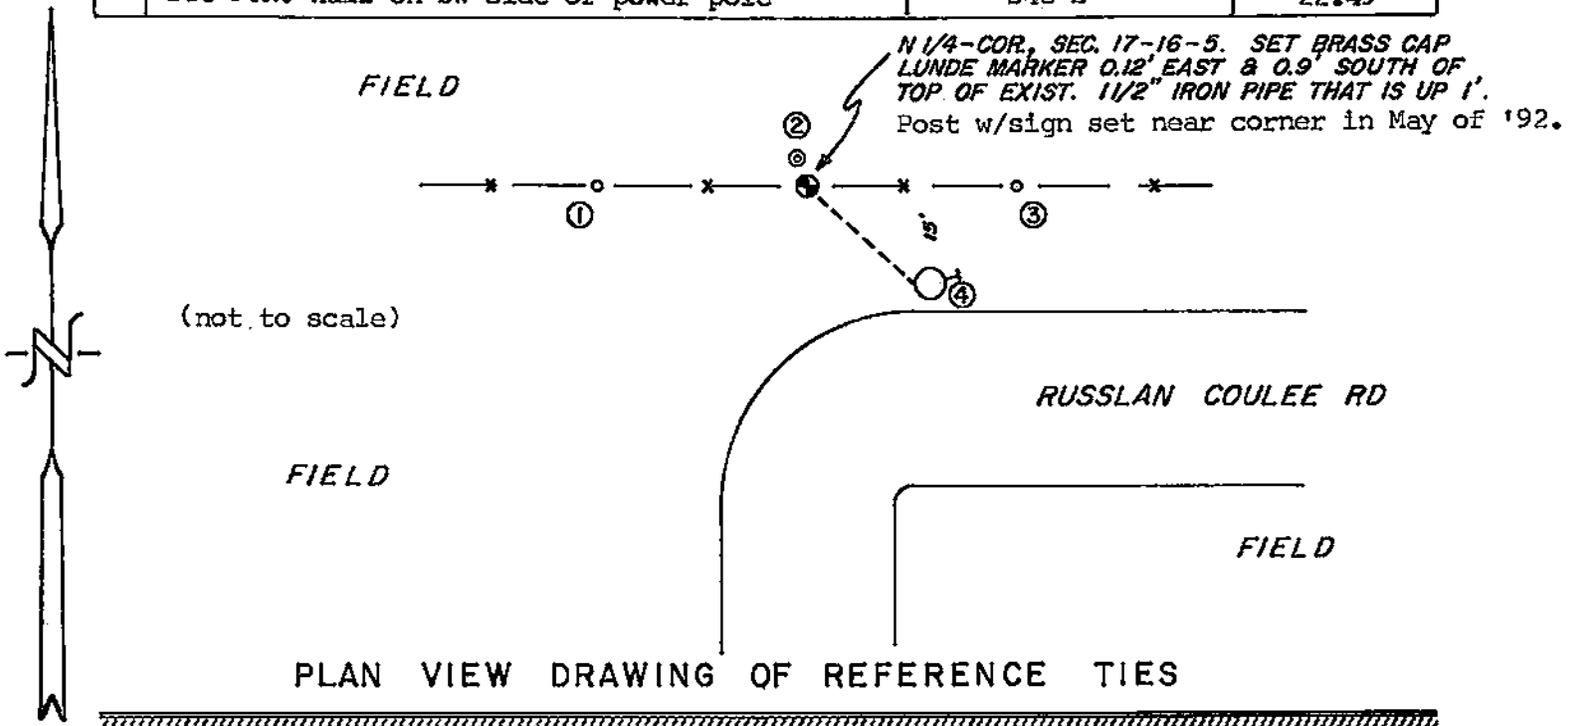

MAP SHOWING DISTANCE AND DIRECTION TO OTHER PUBLIC LAND SURVEY CORNERS USED FOR REESTABLISHING THE CORNER

(not to scale)

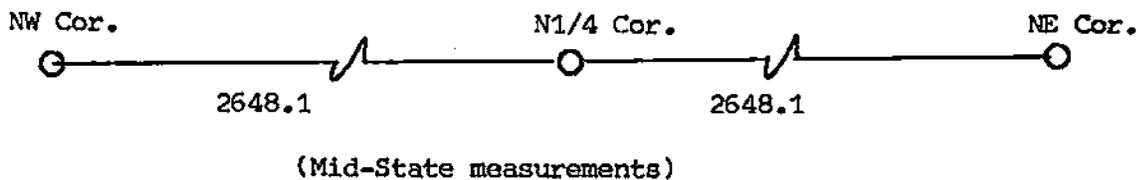

I, William C. Jung, Deputy County Surveyor,
 HEREBY CERTIFY THAT THE CORNER LOCATION SHOWN ON THIS RECORD
 WAS DETERMINED BY ME OR UNDER MY DIRECTION AND CONTROL AND
 THAT THIS U. S. PUBLIC LAND SURVEY MONUMENT RECORD IS CORRECT
 AND COMPLETE TO THE BEST OF MY KNOWLEDGE AND BELIEF.

William C. Jung
 Signature

11/27/89
 Date

Revised: June 2, 1992
wef

