


21605082000

U. S. PUBLIC LAND SURVEY MONUMENT RECORD

SECTION 9 T 16 N, R 5 W, TOWN OF Bangor

LA CROSSE COUNTY

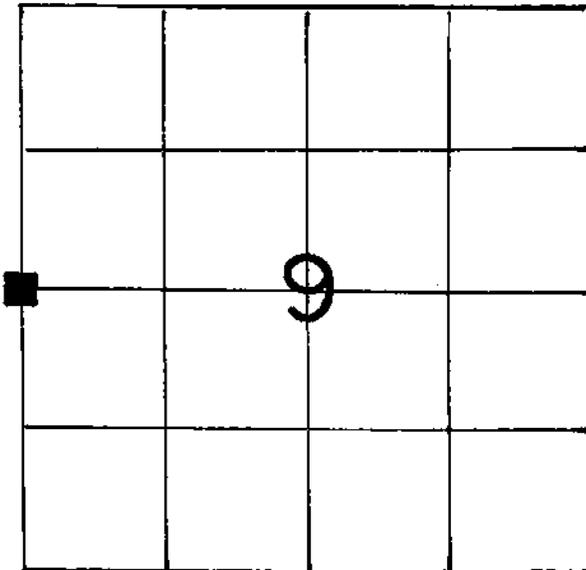

LOCATION OF LANDMARK

Crew: William C. Jung
Peter Follansbee

Date: 10/26/88

Describe any record evidence, monument evidence, testimonial evidence or any other material evidence you considered and whether the monument was found or restored through acceptance of an obliterated evidence location.

I found a broken 6" square stone at the corner and accepted it as the best available evidence of the original government corner position. The top was broken into (4) pieces, but the bottom portion was good. I placed the (4) pieces over the bottom and tied them off with barbed wire. I set a large nail in the center of the stone pieces. I also set a 1 $\frac{1}{4}$ " iron pipe on the West side of the stone as a brace. I buried a whiskey bottle with an empty M-16 cartridge on the Southwest side of the stone. I placed field stone around the corner.

Describe or show any material discrepancy between the location of the restored corner and that of the corner previously restored or reestablished.

None known.

WISCONSIN COORDINATE SYSTEM

North

East

Theta Angle

Horiz. Order

Vert. Order

TYPE OF LANDMARK

Stone


BEARINGS ARE REFERENCED TO

RECORD OF DURABLE WITNESS MONUMENTS

NO	DESCRIPTION	BEARING	DISTANCE
1	P.K. in double blazed 11" oak	-----	17.24
2	P.K. in double blazed 13" oak	Magnetic=N6°E	10.18
3	P.K. in double blazed 7" hickory	-----	15.98
4	P.K. in double blazed 16" oak	-----	20.49

(not to scale)

W O O D S

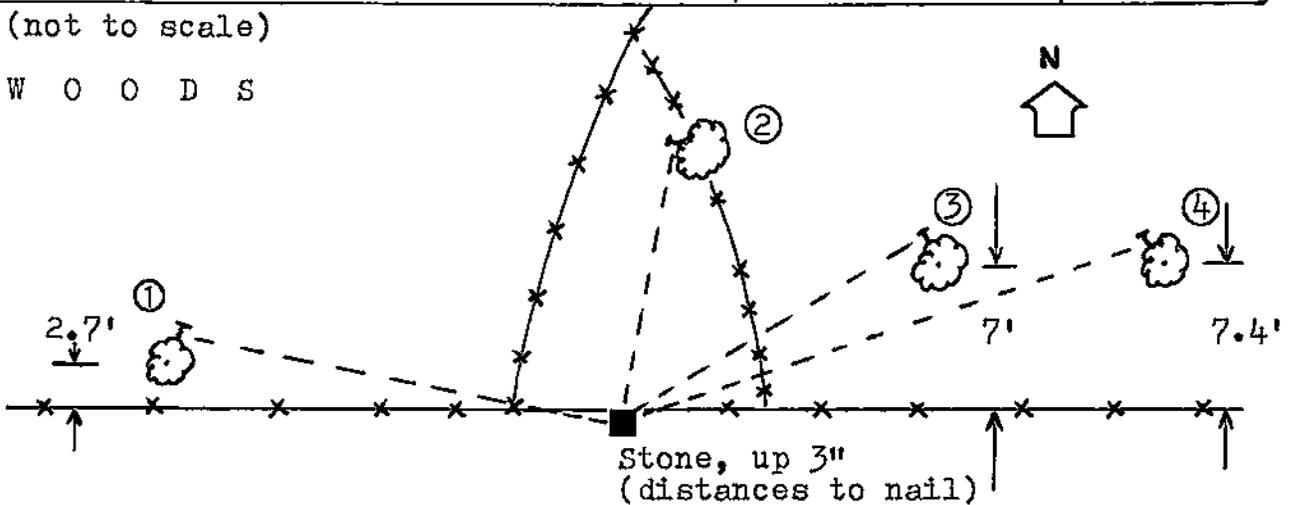

P A S T U R E

PLAN VIEW DRAWING OF REFERENCE TIES

MAP SHOWING DISTANCE AND DIRECTION TO OTHER PUBLIC LAND SURVEY CORNERS USED FOR REESTABLISHING THE CORNER

(no measurements made by me at this time)

I, William C. Jung, Deputy County Surveyor
 HEREBY CERTIFY THAT THE CORNER LOCATION SHOWN ON THIS RECORD
 WAS DETERMINED BY ME OR UNDER MY DIRECTION AND CONTROL AND
 THAT THIS U. S. PUBLIC LAND SURVEY MONUMENT RECORD IS CORRECT
 AND COMPLETE TO THE BEST OF MY KNOWLEDGE AND BELIEF.

William C. Jung
 Signature

1/10/89
 Date



Seal