


U. S. PUBLIC LAND SURVEY MONUMENT RECORD

SECTION 9 T 16 N, R 5 W, TOWN OF BANGOR

LA CROSSE COUNTY

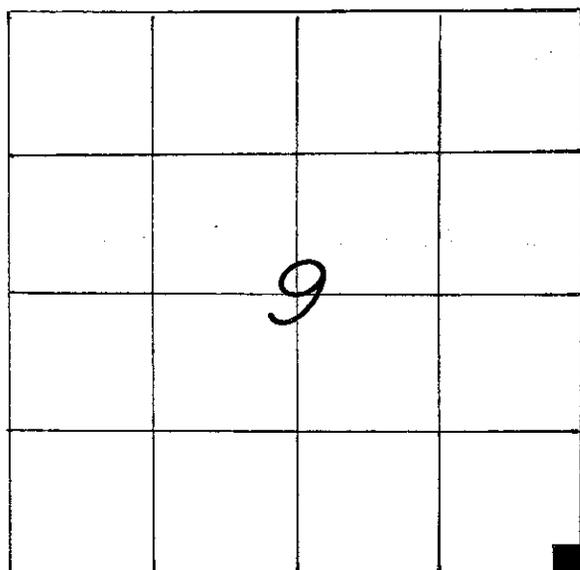

LOCATION OF LANDMARK

CREW: **BRYAN H. MEYER**
PETER F. FOLLANSBEE
 DATE: **12/01/2009**

WISCONSIN COORDINATE SYSTEM

North

East

Theta Angle

Horiz. Order

Vert. Order

TYPE OF LANDMARK

STONE MONUMENT.

BEARINGS ARE REFERENCED TO


Describe any record evidence, monument evidence, testimonial evidence or any other material evidence you considered and whether the monument was found or restored through acceptance of an obliterated evidence location.

Describe or show any material discrepancy between the location of the restored corner and that of the corner previously restored or reestablished.

RECORD OF DURABLE WITNESS MONUMENTS

MAGNETIC

NO	DESCRIPTION	BEARING	DISTANCE
1	SET A NAIL IN S.-SIDE OF A 36" ELM	N 62° W	62.38 FT.
2	SET A NAIL IN S.-SIDE OF A 19-1/2" WHITE OAK	N 76° W	36.80 FT.
3	SET A NAIL IN N.E.-SIDE OF A 19" HICKORY	S 28° W	10.64 FT.
4	SET A NAIL IN N.E.-SIDE OF A 34" BLACK OAK	S 40° E	49.05 FT.

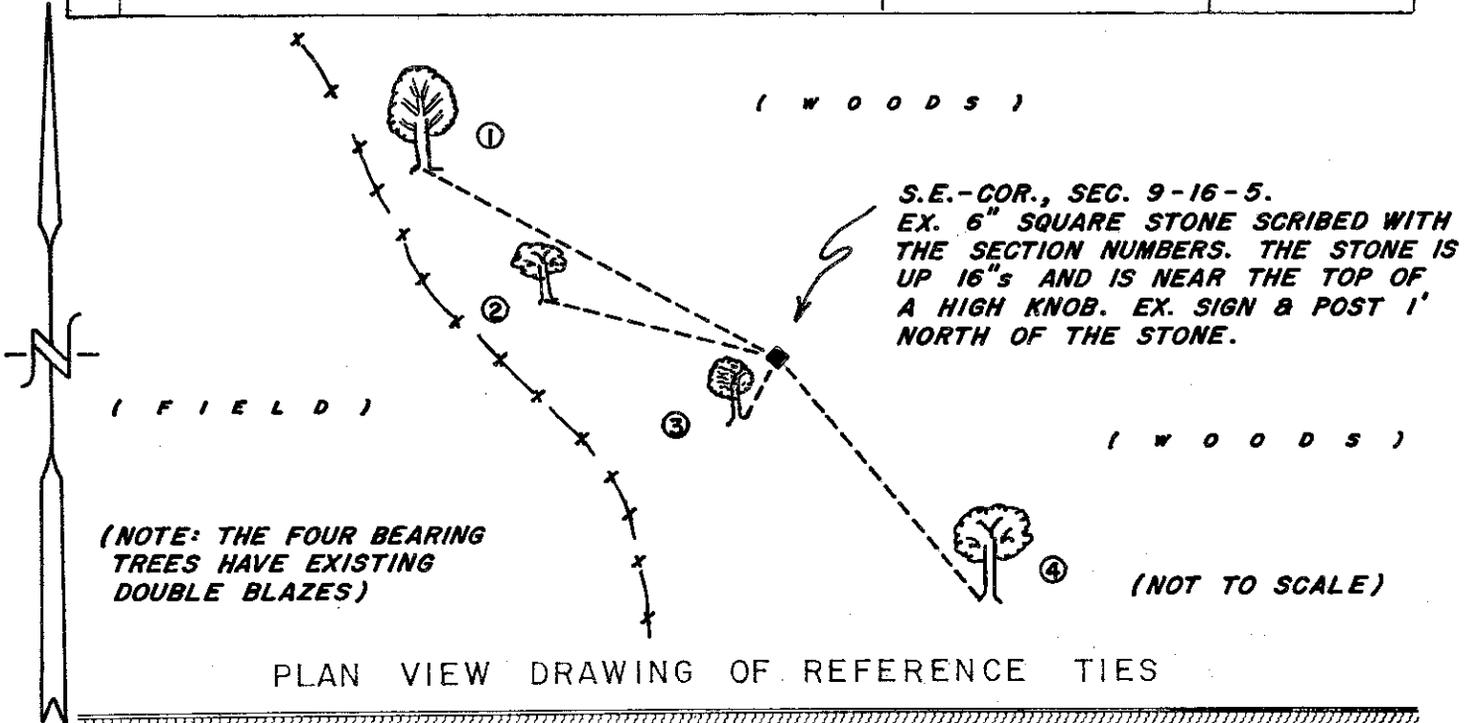


MAP SHOWING DISTANCE AND DIRECTION TO OTHER PUBLIC LAND SURVEY CORNERS USED FOR REESTABLISHING THE CORNER

I, BRYAN H. MEYER, COUNTY SURVEYOR
HEREBY CERTIFY THAT THE CORNER LOCATION SHOWN ON THIS RECORD WAS DETERMINED BY ME OR UNDER MY DIRECTION AND CONTROL AND THAT THIS U. S. PUBLIC LAND SURVEY MONUMENT RECORD IS CORRECT AND COMPLETE TO THE BEST OF MY KNOWLEDGE AND BELIEF.

Bryan H. Meyer
Signature

July 9, 2010
Date

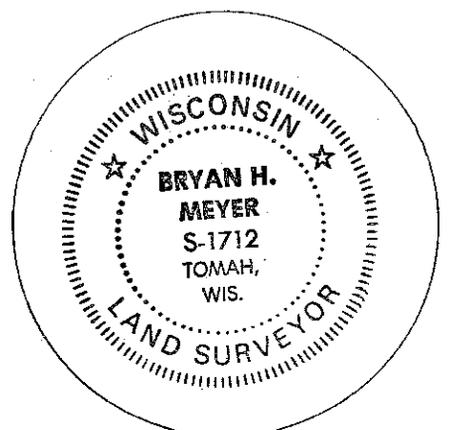


Seal

21605090000

U. S. PUBLIC LAND SURVEY MONUMENT RECORD

SECTION 9 T 16 N, R 5 W, TOWN OF BANGOR
 LA CROSSE COUNTY

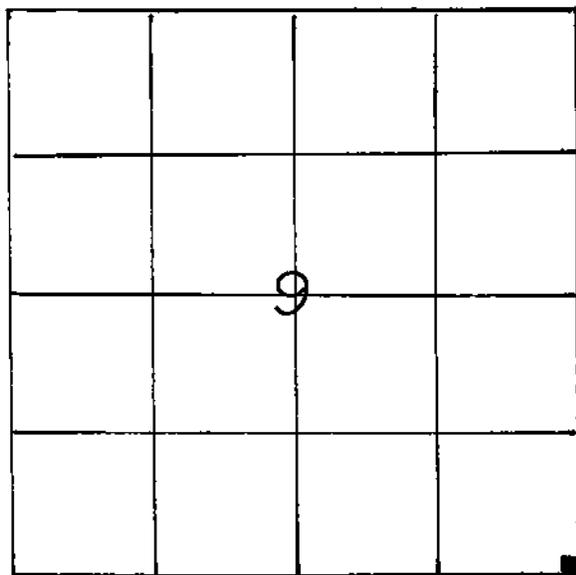

LOCATION OF LANDMARK

DATE: 11-17-86
 CREW: BILL JUNG, PERRY DAHL

WISCONSIN COORDINATE SYSTEM
North
East
Theta Angle
Horiz. Order
Vert. Order
TYPE OF LANDMARK
STONE MONUMENT
BEARINGS ARE REFERENCED TO
True

Describe any record evidence, monument evidence, testimonial evidence or any other material evidence you considered and whether the monument was found or restored through acceptance of an obliterated evidence location.


I found a stone at the corner and accepted it as the best available evidence of the original government corner position.

Describe or show any material discrepancy between the location of the restored monument and that of the corner previously restored or reestablished.

None known.

RECORD OF DURABLE WITNESS MONUMENTS


NO	DESCRIPTION	MAGNETIC	
		BEARING	DISTANCE
1	P.K. NAIL IN DOUBLE-BLAZED 24" ELM	N66°W	62.4'
2	P.K. NAIL IN DOUBLE-BLAZED 14" OAK	N83°W	36.96'
3	P.K. NAIL IN DOUBLE-BLAZED 14" HICKORY	S26°W	10.6'
4	P.K. NAIL IN DOUBLE-BLAZED 27" OAK	S38°E	49.6'

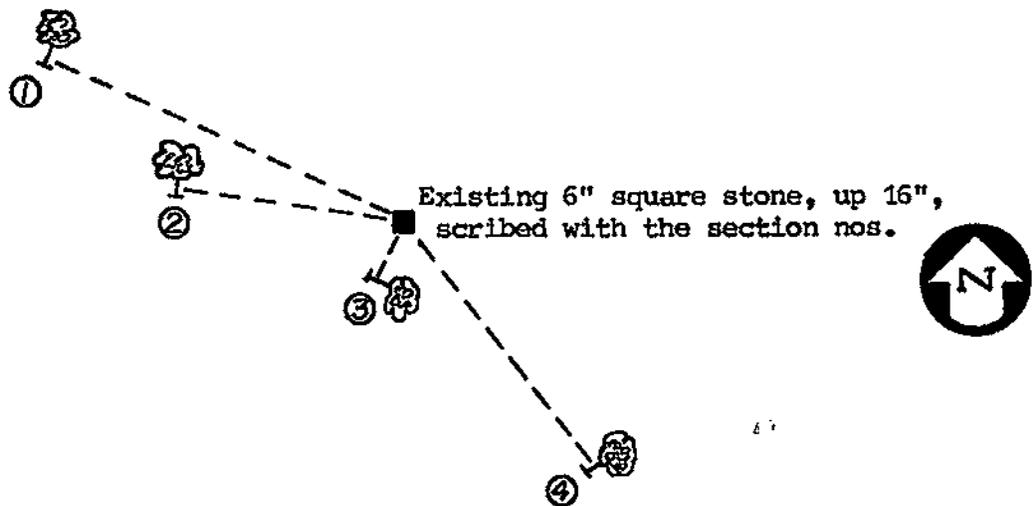

PLAN VIEW DRAWING OF REFERENCE TIES

MAP SHOWING DISTANCE AND DIRECTION TO OTHER PUBLIC LAND SURVEY CORNERS USED FOR REESTABLISHING THE CORNER


(not to scale)

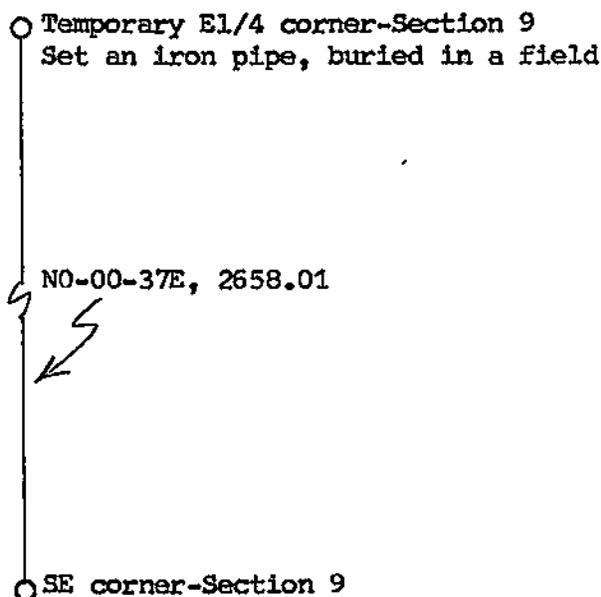

I, William C. Jung, Deputy County Surveyor,
HEREBY CERTIFY THAT THE CORNER LOCATION SHOWN ON THIS RECORD
WAS DETERMINED BY ME OR UNDER MY DIRECTION AND CONTROL AND
THAT THIS U. S. PUBLIC LAND SURVEY MONUMENT RECORD IS CORRECT
AND COMPLETE TO THE BEST OF MY KNOWLEDGE AND BELIEF.

William C. Jung
Signature

March 10, 1987
Date

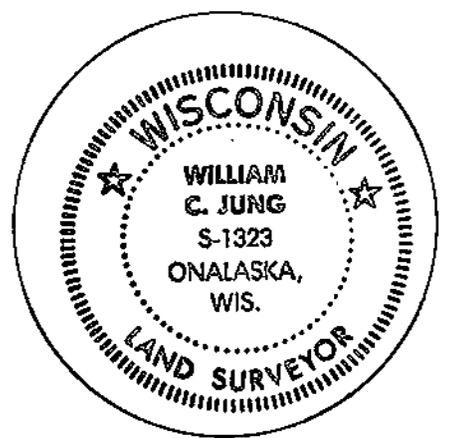

Seal