


21605090020

U. S. PUBLIC LAND SURVEY MONUMENT RECORD

SECTION 9 T 16 N, R 5 W, TOWN OF BANGOR

LA CROSSE COUNTY

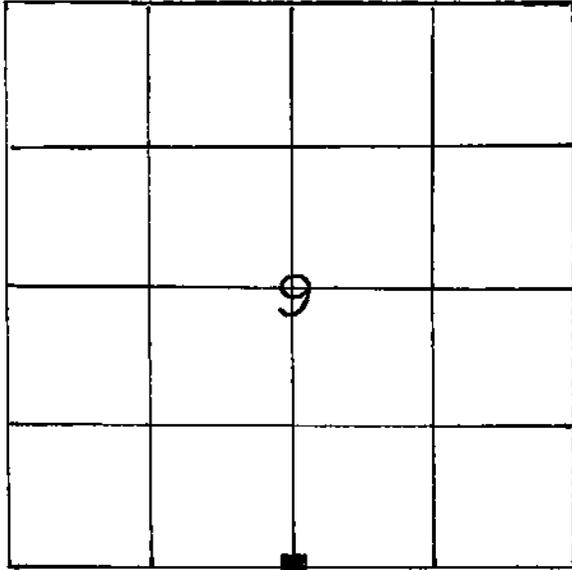

LOCATION OF LANDMARK

WISCONSIN COORDINATE SYSTEM
North
East
Theta Angle
Horiz. Order
Vert. Order
TYPE OF LANDMARK
STONE MONUMENT
BEARINGS ARE REFERENCED TO

DATE: 11-21-86

Date: 12-22-97

CREW: BILL JUNG, PERRY DAHL

Crew: Bill Jung, Peter Follansbee

Describe any record evidence, monument evidence, testimonial evidence or any other material evidence you considered and whether the monument was found or restored through acceptance of an obliterated evidence location.

I found a stone at the corner and accepted it as the best available evidence of the original government corner position.

1997-We found the stone in good condition (painted blue !!!!!!!?) and set a sign and post by the stone, and made a new bearing tree.


Describe or show any material discrepancy between the location of the restored corner and that of the corner previously restored or reestablished.

None known.

RECORD OF DURABLE WITNESS MONUMENTS  
MAGNETIC

NO	DESCRIPTION	BEARING	DISTANCE
1	P.K. NAIL IN DOUBLE-BLAZED 15" Tree	N22°W	15.19'
2	P.K. NAIL IN DOUBLE-BLAZED 7" Tree	N30°E	11.46'
3	P.K. NAIL IN DOUBLE-BLAZED 7" Tree	N70°E	8.86'
4	CENTER OF UNBLAZED 17" WHITE OAK	S8°W	21.5'

Scale: 1"=20'

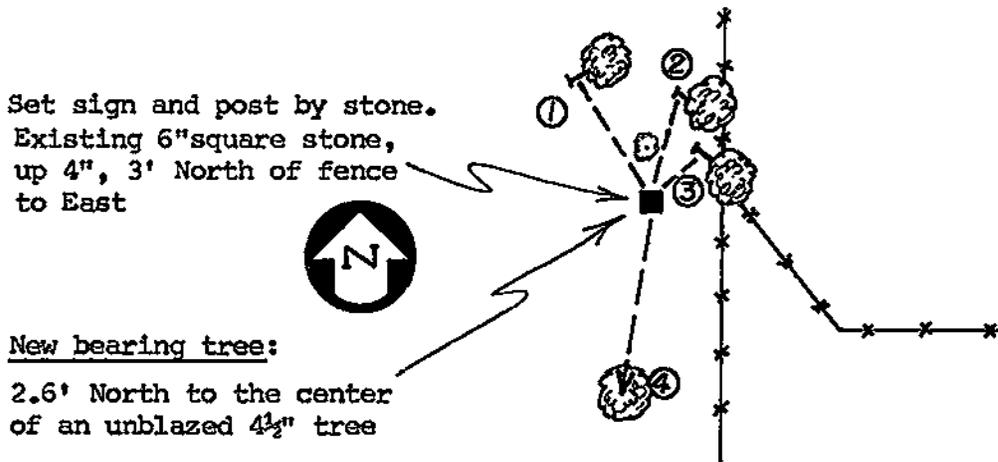

PLAN VIEW DRAWING OF REFERENCE TIES

MAP SHOWING DISTANCE AND DIRECTION TO OTHER PUBLIC LAND  
SURVEY CORNERS USED FOR REESTABLISHING THE CORNER


(none made by me at this time)

I, William C. Jung, Deputy County Surveyor,  
HEREBY CERTIFY THAT THE CORNER LOCATION SHOWN ON THIS RECORD  
WAS DETERMINED BY ME OR UNDER MY DIRECTION AND CONTROL AND  
THAT THIS U. S. PUBLIC LAND SURVEY MONUMENT RECORD IS CORRECT  
AND COMPLETE TO THE BEST OF MY KNOWLEDGE AND BELIEF.

William C. Jung  
Signature

March 10, 1987  
Date

Revised: 2/12/98 *aseq*

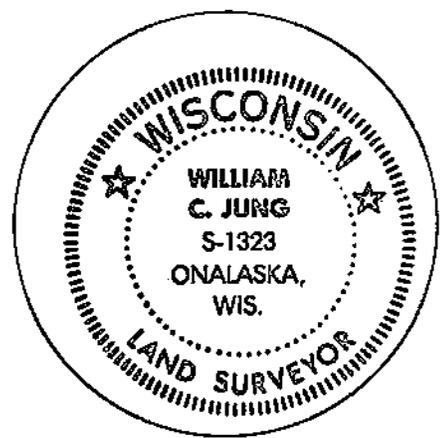

Seal