


21605100000

U. S. PUBLIC LAND SURVEY MONUMENT RECORD

SECTION 10 T 16 N, R 5 W, TOWN OF BANGOR

LA CROSSE COUNTY

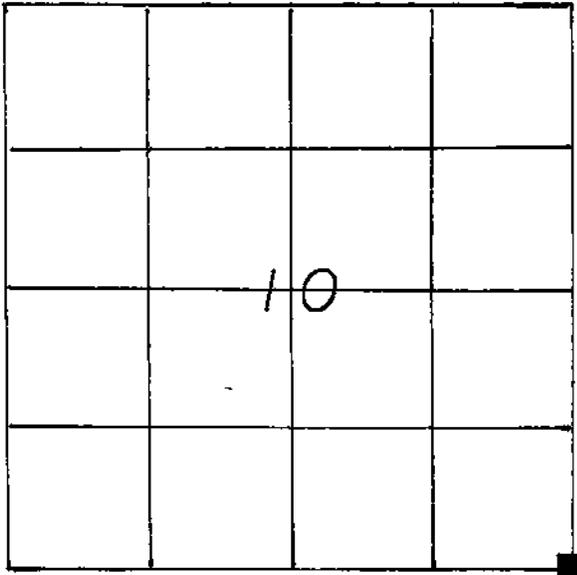

LOCATION OF LANDMARK

DATE: 11-25-86

CREW: BILL JUNG, PERRY DAHL

WISCONSIN COORDINATE SYSTEM

North

East

Theta Angle

Horiz. Order

Vert. Order

TYPE OF LANDMARK

STONE MONUMENT

BEARINGS ARE REFERENCED TO

Describe any record evidence, monument evidence, testimonial evidence or any other material evidence you considered and whether the monument was found or restored through acceptance of an obliterated evidence location.

I found a stone at the corner and accepted it as the best available evidence of the original government corner position.


Describe or show any material discrepancy between the location of the restored corner and that of the corner previously restored or reestablished.

None known.

RECORD OF DURABLE WITNESS MONUMENTS
MAGNETIC

NO	DESCRIPTION	BEARING	DISTANCE
1	P.K. NAIL IN DOUBLE-BLAZED 20" W. OAK	N63°E	31.10'
2	P.K. NAIL IN DOUBLE-BLAZED 19" BURR OAK	N49°E	9.26'
3	P.K. NAIL IN DOUBLE-BLAZED 7" HICKORY	S56°W	SLOPE 27.5'
4	P.K. NAIL IN DOUBLE-BLAZED 30" BL. OAK	S34°E	48.36'

I found a 6" square stone almost toppled over. I straightened it up and mounded it also. The stone is up 1.5' on a West sidehill and 4' South of the fence. The section numbers are scribed on the stone.

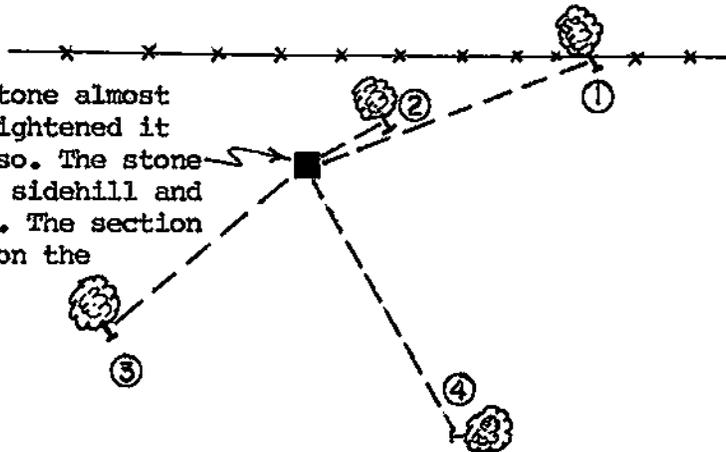

PLAN VIEW DRAWING OF REFERENCE TIES


MAP SHOWING DISTANCE AND DIRECTION TO OTHER PUBLIC LAND SURVEY CORNERS USED FOR REESTABLISHING THE CORNER

(none made by me at this time)

I, William C. Jung, Deputy County Surveyor,
HEREBY CERTIFY THAT THE CORNER LOCATION SHOWN ON THIS RECORD
WAS DETERMINED BY ME OR UNDER MY DIRECTION AND CONTROL AND
THAT THIS U. S. PUBLIC LAND SURVEY MONUMENT RECORD IS CORRECT
AND COMPLETE TO THE BEST OF MY KNOWLEDGE AND BELIEF.

William C. Jung
Signature

March 6, 1987
Date

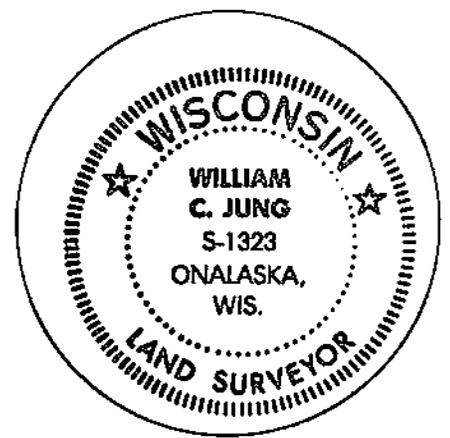

Seal