


21605102000

U. S. PUBLIC LAND SURVEY MONUMENT RECORD

SECTION 10 T 16 N, R 5 W, TOWN OF BANGOR

LA CROSSE COUNTY

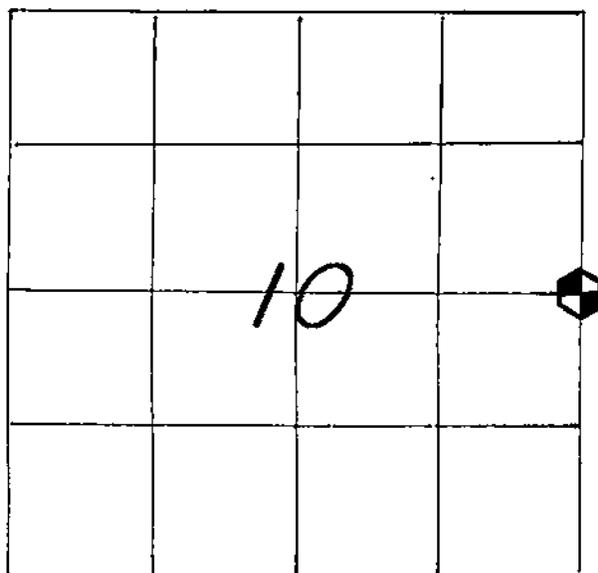

WISCONSIN COORDINATE SYSTEM

North

East

Theta Angle

Horiz. Order

Vert. Order

TYPE OF LANDMARK

BRASS CAP LUNDE MARKER.

BEARINGS ARE REFERENCED TO

TRUE NORTH AS PER SECTION DATA.

LOCATION OF LANDMARK

CREW: WILLIAM C. JUNG
 PETER F. FOLLANSBEE
 DATE: 9/16/1999.


Describe any record evidence, monument evidence, testimonial evidence or any other material evidence you considered and whether the monument was found or restored through acceptance of an obliterated evidence location.

I traversed to this corner in 1986 and found an old corner post with a fence going to the East. I could not find a stone. Scott Dunnum, a crew chief for Coulee Region Land Surveyors, traversed to this point and found the fence gone and the post moved. He talked to a long time landowner who had never seen a stone here. Pete and I searched again for a stone but found nothing. The corner is set on line between the section corners and in the old fence location that I had found years ago. I set a Lunde at the corner. Describe or show any material discrepancy between the location of the restored corner and that of the corner previously restored or reestablished.

NONE KNOWN.

RECORD OF DURABLE WITNESS MONUMENTS
TRUE NORTH

NO	DESCRIPTION	BEARING	DISTANCE
1	SET P.K. NAIL IN S.E.-SIDE 15" HICKORY	N 43°52'24" E	262.48 FT.
2	SET P.K. NAIL IN N.W.-SIDE 15" HICKORY	N 64°37'18" E	265.22 FT.
3	SET P.K. NAIL IN S.E.-SIDE 14" HICKORY	N 76°51'35" E	288.21 FT.
4	SET A 1/4" x 24" IRON PIPE 18" NORTH OF A FENCE POST	N 88°02'45" E	243.46 FT.

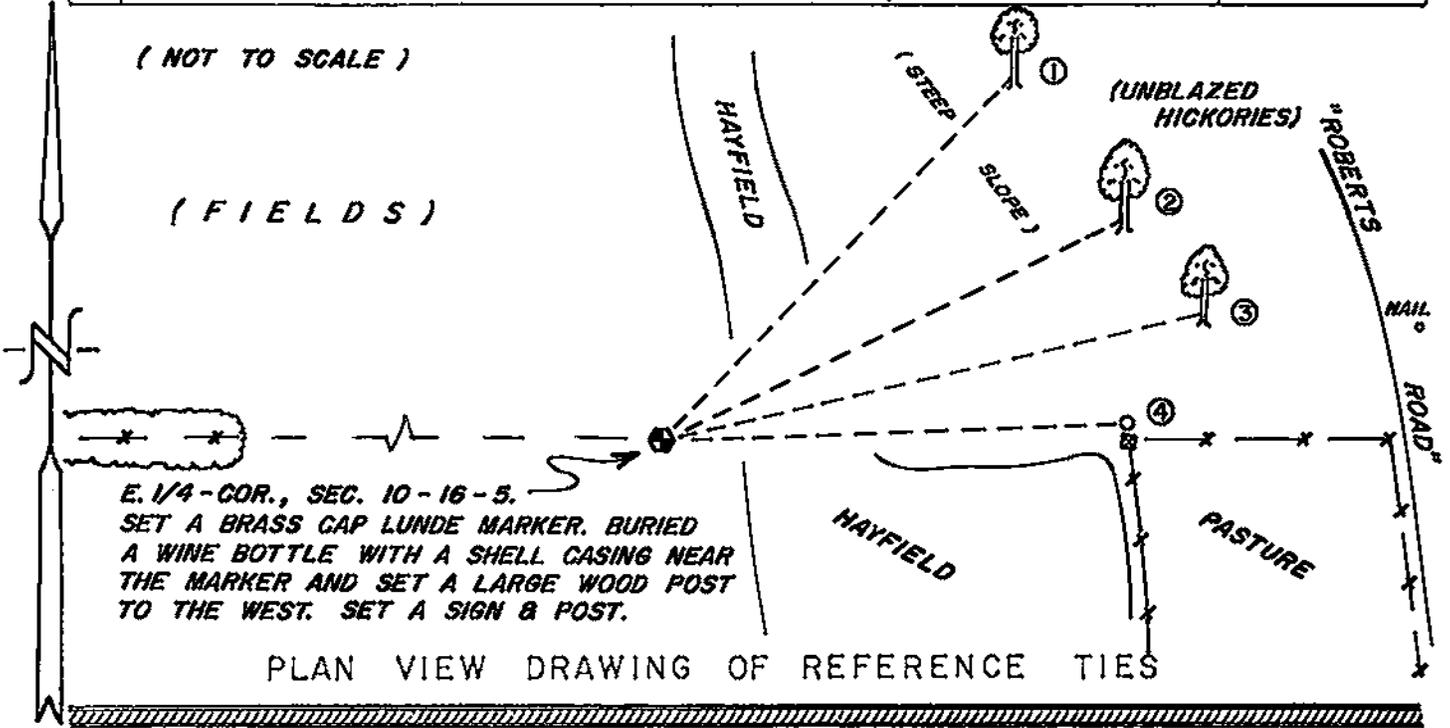


MAP SHOWING DISTANCE AND DIRECTION TO OTHER PUBLIC LAND SURVEY CORNERS USED FOR REESTABLISHING THE CORNER

I did not do any more traversing at this time. Scott Dunnum did the control traverse for Coulee Region Land Surveyors. I worked off of their survey points.

I, WILLIAM G. JUNG, COUNTY SURVEYOR
HEREBY CERTIFY THAT THE CORNER LOCATION SHOWN ON THIS RECORD WAS DETERMINED BY ME OR UNDER MY DIRECTION AND CONTROL AND THAT THIS U. S. PUBLIC LAND SURVEY MONUMENT RECORD IS CORRECT AND COMPLETE TO THE BEST OF MY KNOWLEDGE AND BELIEF.

William G. Jung 9/27/99
Signature Date

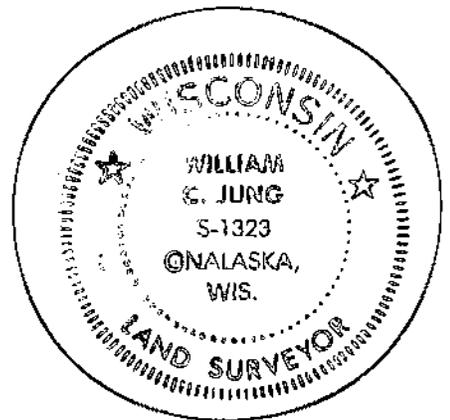

Seal