


21605110000

U. S. PUBLIC LAND SURVEY MONUMENT RECORD

SECTION 12 T 16 N, R 5 W, TOWN OF BANGOR

LA CROSSE COUNTY

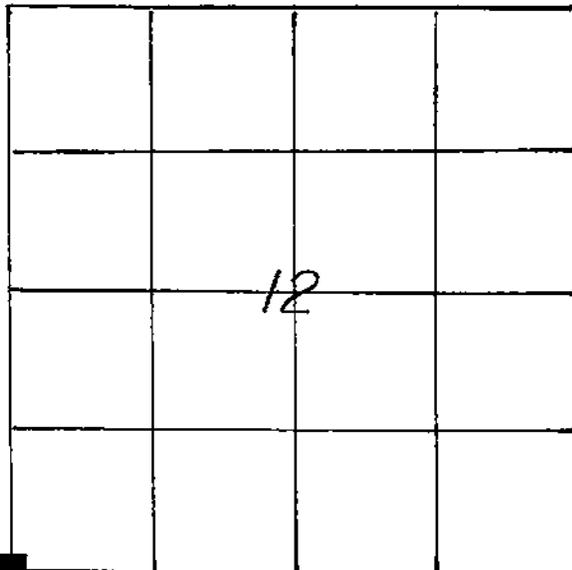

LOCATION OF LANDMARK

DATE: 12-23-86

CREW: BILL JUNG, PERRY DAHL

WISCONSIN COORDINATE SYSTEM

North

East

Theta Angle

Horiz. Order

Vert. Order

TYPE OF LANDMARK
STONE MONUMENT

BEARINGS ARE REFERENCED TO

Describe any record evidence, monument evidence, testimonial evidence or any other material evidence you considered and whether the monument was found or restored through acceptance of an obliterated evidence location.


I found a stone at the corner and accepted it as the best available evidence of the original government corner position.

Describe or show any material discrepancy between the location of the restored corner and that of the corner previously restored or reestablished.

None known.

RECORD OF DURABLE WITNESS MONUMENTS
MAGNETIC

NO	DESCRIPTION	BEARING	DISTANCE
1	P.K. NAIL IN DOUBLE-BLAZED 10" OAK	N62°W	20.41'
2	P.K. NAIL IN DOUBLE-BLAZED 4" OAK	N85°W	24.00'
3	P.K. NAIL IN DOUBLE-BLAZED 5" OAK	S73°W	21.65'
4	P.K. NAIL IN DOUBLE-BLAZED 9" OAK	S17°E	9.28'

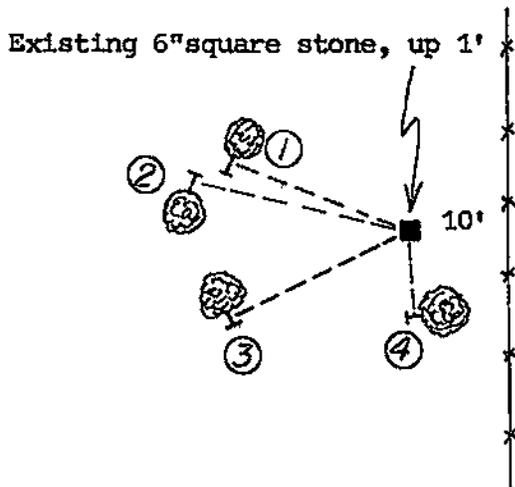

PLAN VIEW DRAWING OF REFERENCE TIES


MAP SHOWING DISTANCE AND DIRECTION TO OTHER PUBLIC LAND SURVEY CORNERS USED FOR REESTABLISHING THE CORNER

(none made by me at this time)

I, William C. Jung, Deputy County Surveyor,
HEREBY CERTIFY THAT THE CORNER LOCATION SHOWN ON THIS RECORD
WAS DETERMINED BY ME OR UNDER MY DIRECTION AND CONTROL AND
THAT THIS U. S. PUBLIC LAND SURVEY MONUMENT RECORD IS CORRECT
AND COMPLETE TO THE BEST OF MY KNOWLEDGE AND BELIEF.

William C. Jung
Signature

March 6, 1987
Date

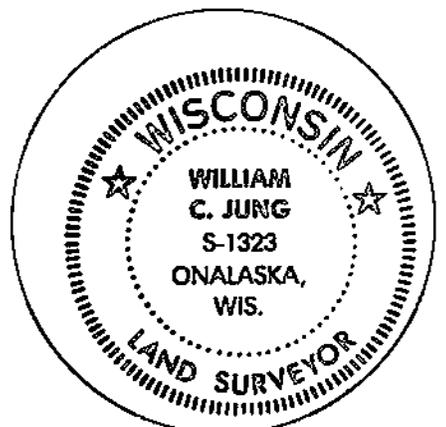

Seal