


21605110020

U. S. PUBLIC LAND SURVEY MONUMENT RECORD

SECTION 11 T 16 N, R 5 W, TOWN OF BANGOR

LA CROSSE COUNTY

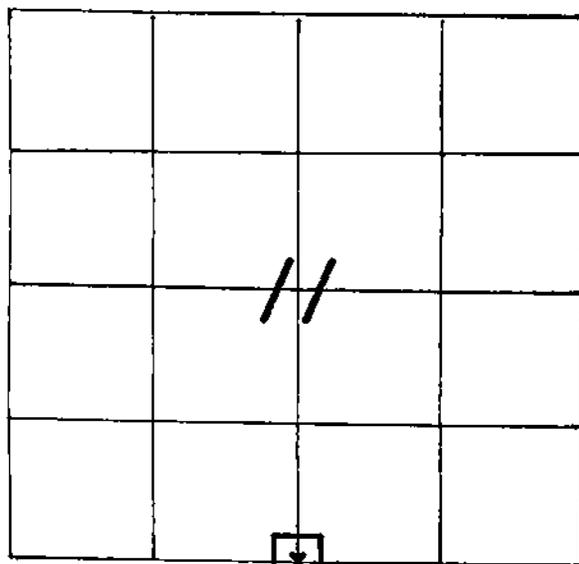

LOCATION OF LANDMARK

CREW: WILLIAM C. JUNG
 PETER F. FOLLANSBEE
 DATE: 11/06/2007

WISCONSIN COORDINATE SYSTEM

North 683,097.334

East 1,720,456.625

Theta Angle

Horiz. Order

Vert. Order

DATUM: 1983('91)

TYPE OF LANDMARK

6" x 6" SQUARE STONE.

BEARINGS ARE REFERENCED TO
 GRID NORTH AS PER SECTION DATA.

Describe any record evidence, monument evidence, testimonial evidence or any other material evidence you considered and whether the monument was found or restored through acceptance of an obliterated evidence location.


Bliss set a stone at this corner in 1867. We made a total of six trips to this corner before we finally had it found, measured to, and tied off. A piece of logging equipment had apparently run the stone over years ago, shaving the top off, and driving the rest of the stone into the ground. I found the stone, plumbed it up, set the top back on, and mounded it with rocks. The Berntsen on the South side of the stone was set as^a witness marker.

Describe or show any material discrepancy between the location of the restored corner and that of the corner previously restored or reestablished.

NONE KNOWN.


RECORD OF DURABLE WITNESS MONUMENTS

NO	DESCRIPTION	MAGNETIC	
		BEARING	DISTANCE
1	SET A NAIL IN S.E.-SIDE OF A 12" BIRCH	S 74° W	14.92 FT.
2	SET A NAIL IN S.W.-SIDE OF AN 8" BIRCH	N 38° W	12.94 FT.
3	SET A NAIL IN S.W.-SIDE OF A 10" OAK	S 58° E	53.90 FT.
4	SET A NAIL IN N.W.-SIDE OF A 20" OAK	S 04° E	SLOPE = 47.04'

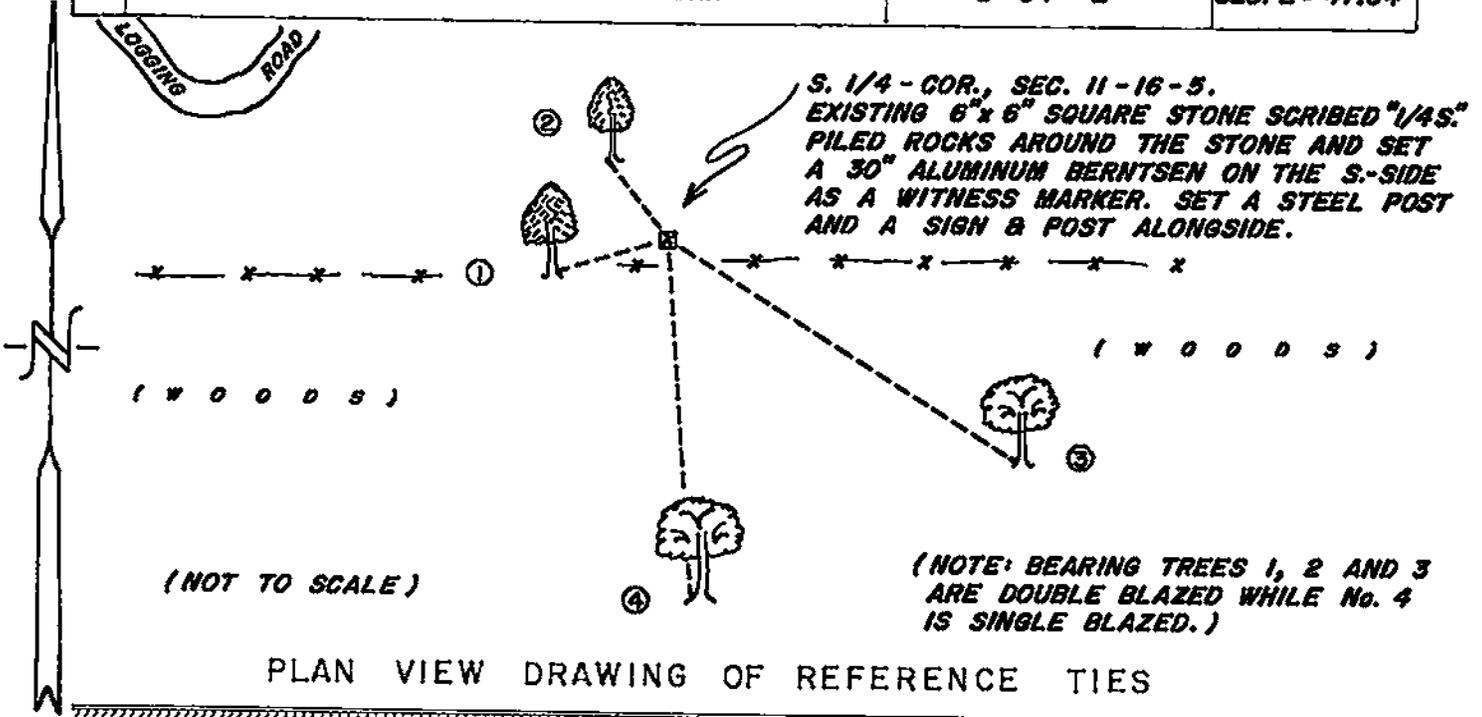

MAP SHOWING DISTANCE AND DIRECTION TO OTHER PUBLIC LAND SURVEY CORNERS USED FOR REESTABLISHING THE CORNER

(GRID BEARINGS AND DISTANCES)
(GRID FACTOR: 0.999938)
(NOT TO SCALE)

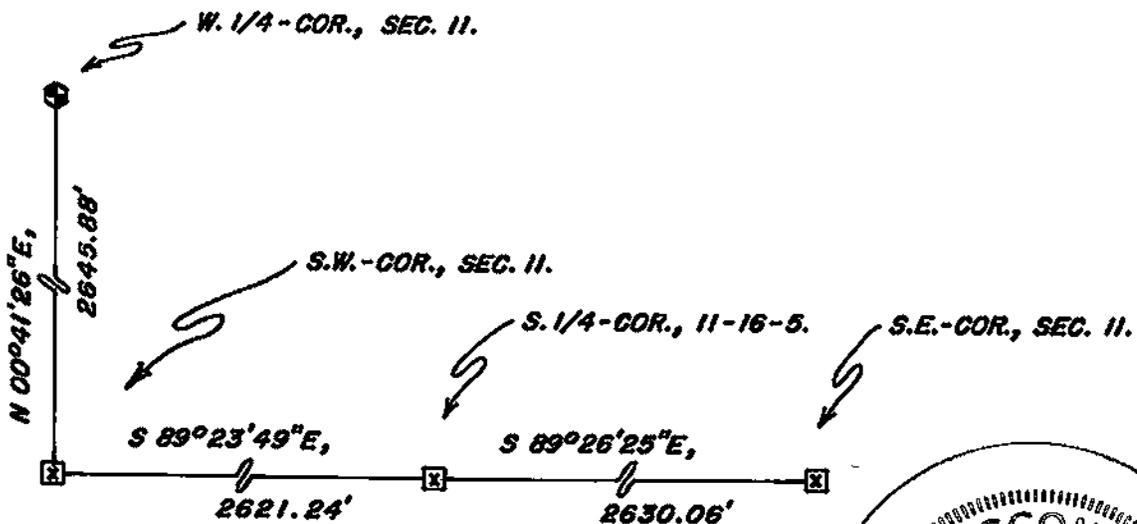

I, WILLIAM C. JUNG, COUNTY SURVEYOR
HEREBY CERTIFY THAT THE CORNER LOCATION SHOWN ON THIS RECORD
WAS DETERMINED BY ME OR UNDER MY DIRECTION AND CONTROL AND
THAT THIS U. S. PUBLIC LAND SURVEY MONUMENT RECORD IS CORRECT
AND COMPLETE TO THE BEST OF MY KNOWLEDGE AND BELIEF.

William C. Jung 12/7/07
Signature Date



Seal