


21605112000

## U. S. PUBLIC LAND SURVEY MONUMENT RECORD

SECTION 12 T 16 N, R 5 W, TOWN OF Bangor

LA CROSSE COUNTY

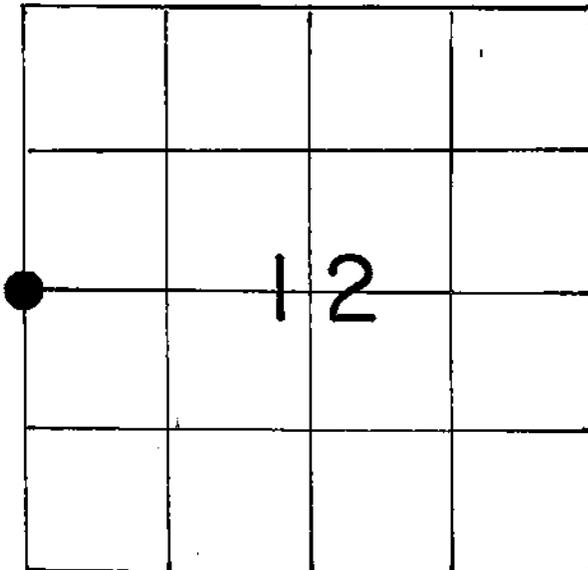

LOCATION OF LANDMARK

## WISCONSIN COORDINATE SYSTEM

North

East

Theta Angle

Horiz. Order

Vert. Order

## TYPE OF LANDMARK

Brass capped Lunde marker

## BEARINGS ARE REFERENCED TO

Assumed North

Crew: William C. Jung  
Peter Follansbee

Witness: Dennis Melichar

Date: September 11, 1989

Describe any record evidence, monument evidence, testimonial evidence or any other material evidence you considered and whether the monument was found or restored through acceptance of an obliterated evidence location.


Norm Hurlburt set the corner on line and equidistant between the section corners. We set a brass capped Lunde marker at the corner. The late LeVern Thielker told me at one time that he found the top of a broken stone near this corner but that he never found the bottom. We three searched at some length but never found the stone. Since it falls in the old logging road, it is possible that the stone was knocked out some time ago.

Describe or show any material discrepancy between the location of the restored corner and that of the corner previously restored or reestablished.

None known.


RECORD OF DURABLE WITNESS MONUMENTS

NO	DESCRIPTION	BEARING	DISTANCE
1	P.K. nail in double blazed 11" aspen	S44°W	35.68'
2	" " " " " 8" hickory	N64°W	40.50'
3	" " " " " 6" hickory	N51°W	41.88'
4	" " " " " 5" hickory with a survey witness sign on the tree	N30°E	16.96'

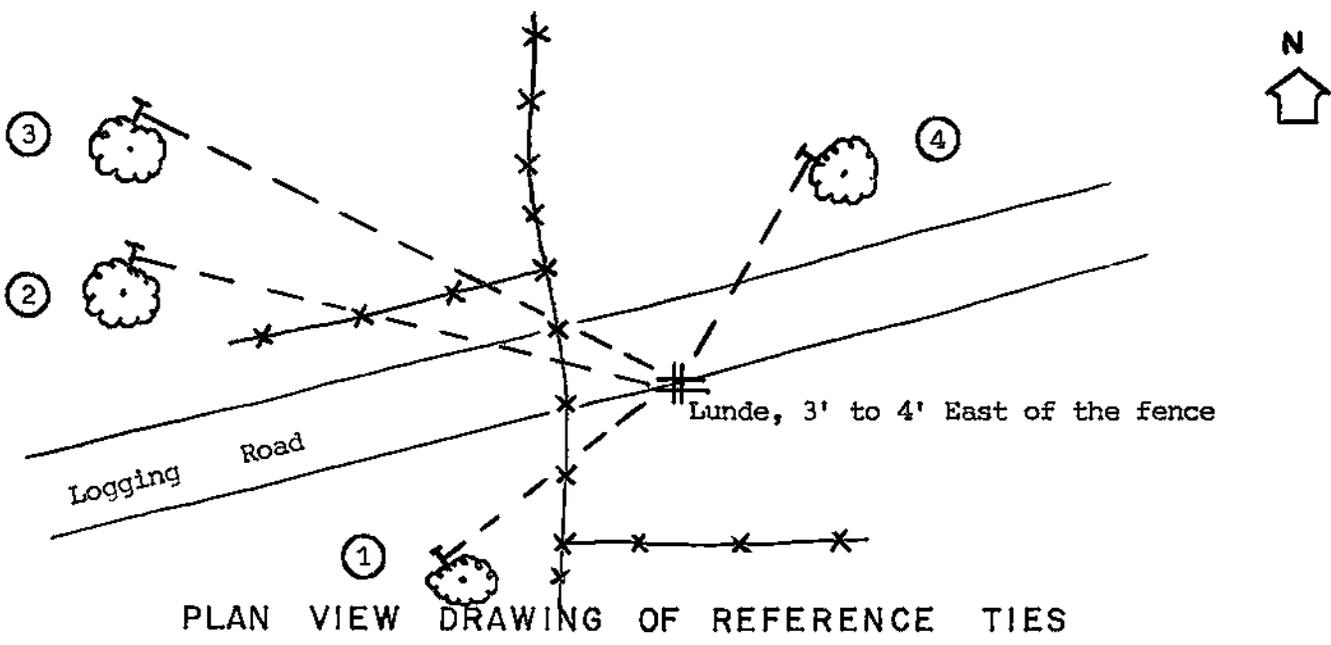

MAP SHOWING DISTANCE AND DIRECTION TO OTHER PUBLIC LAND SURVEY CORNERS USED FOR REESTABLISHING THE CORNER

(not to scale)

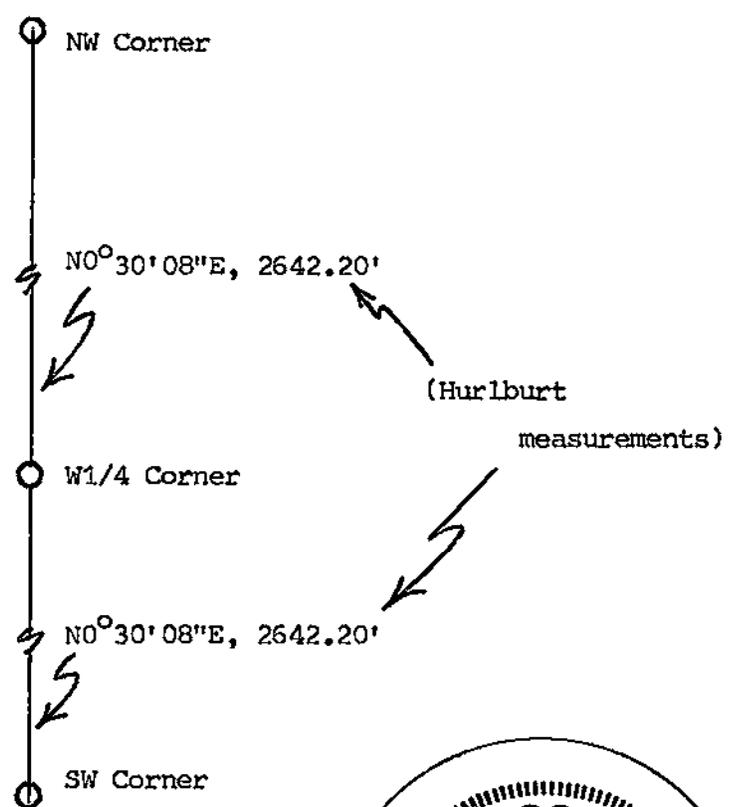

I, William C. Jung, Deputy County Surveyor,  
 HEREBY CERTIFY THAT THE CORNER LOCATION SHOWN ON THIS RECORD  
 WAS DETERMINED BY ME OR UNDER MY DIRECTION AND CONTROL AND  
 THAT THIS U. S. PUBLIC LAND SURVEY MONUMENT RECORD IS CORRECT  
 AND COMPLETE TO THE BEST OF MY KNOWLEDGE AND BELIEF.

William C. Jung December 20, 1989  
 Signature Date



Seal