


21605120000

U. S. PUBLIC LAND SURVEY MONUMENT RECORD

SECTION 12 T 16 N, R 5 W, TOWN OF Bangor

LA CROSSE COUNTY

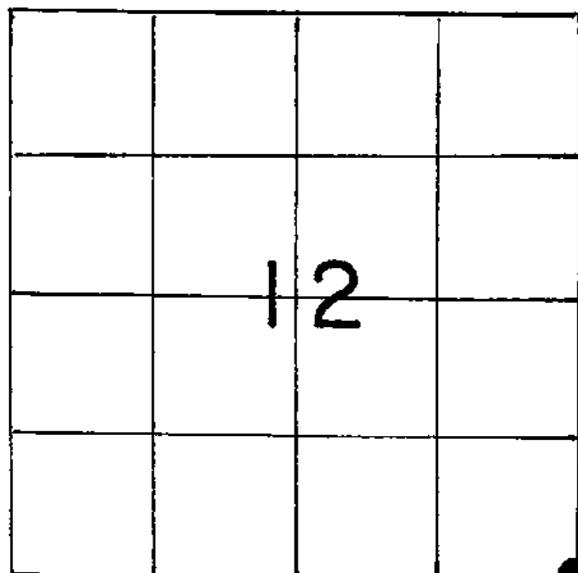

LOCATION OF LANDMARK

Crew: Dennis Melichar, RLS
and assistant

WISCONSIN COORDINATE SYSTEM

North

East

Theta Angle

Horiz. Order

Vert. Order

TYPE OF LANDMARK

Stone

BEARINGS ARE REFERENCED TO

Assumed North

Describe any record evidence, monument evidence, testimonial evidence or any other material evidence you considered and whether the monument was found or restored through acceptance of an obliterated evidence location.

Wilhite and Lund from the Monroe County Surveyor's Office found a stone at the corner in October of 1984. Dennis Melichar found a 6"x6"x18" stone and plumbed it up. The stone is up 2". There is an 11/16"x24" iron bar on the Southeast side of the tree.


Describe or show any material discrepancy between the location of the restored corner and that of the corner previously restored or reestablished.

(See previously recorded tie sheet for discrepancies.)

(as per Dennis Melichar, RLS)

RECORD OF DURABLE WITNESS MONUMENTS


NO	DESCRIPTION	BEARING	DISTANCE
1	To a bent spike on the West side of a dead 14" double blazed butternut	N37°W	15.52'
2	To a bent spike on the Northeast side of a dead 10' double blazed butternut	N63°W	29.53'
3	To a spike on the North side of a double blazed cherry	S54°W	29.25'
4	To a spike on the Southwest side of a double blazed 11" black oak	S48°E	25.09'

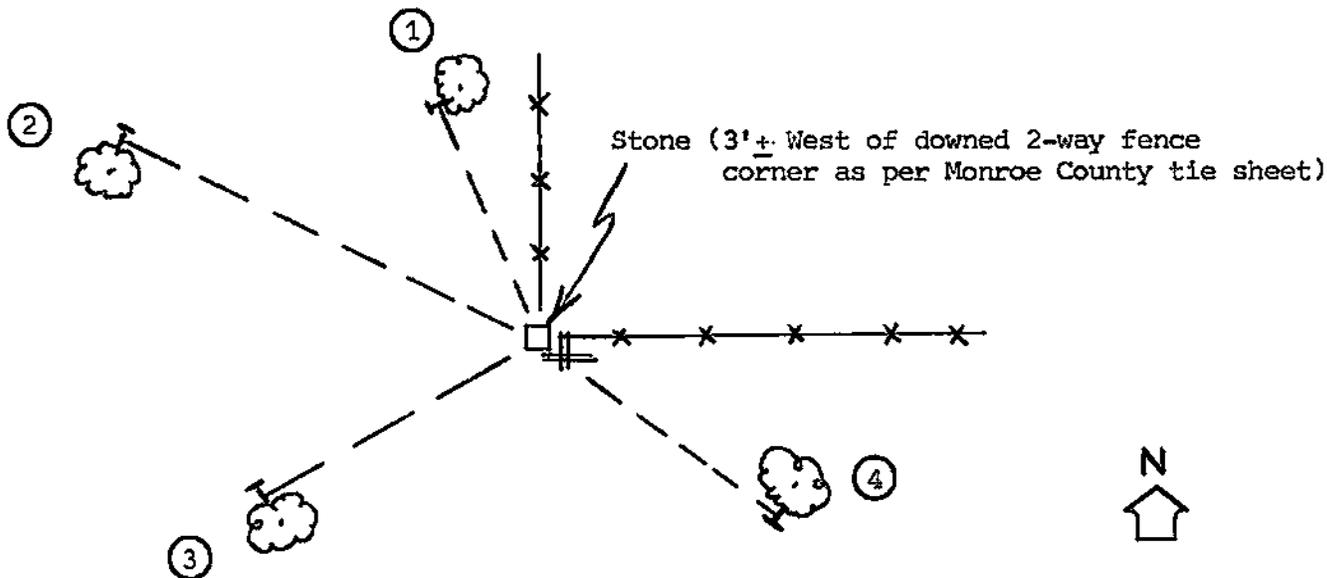

PLAN VIEW DRAWING OF REFERENCE TIES

MAP SHOWING DISTANCE AND DIRECTION TO OTHER PUBLIC LAND SURVEY CORNERS USED FOR REESTABLISHING THE CORNER


(not to scale)

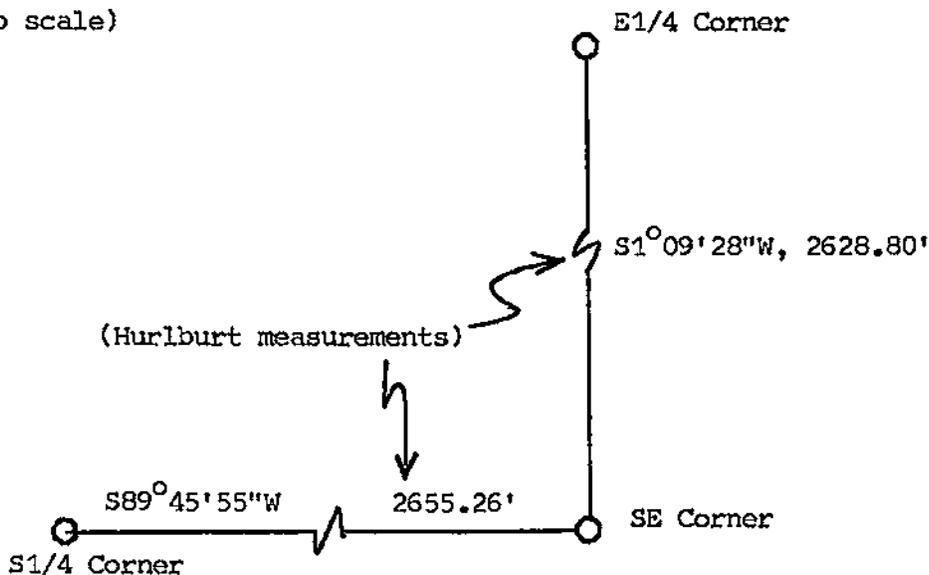

I, William C. Jung, Deputy County Surveyor,
 HEREBY CERTIFY THAT THE CORNER LOCATION SHOWN ON THIS RECORD
 WAS DETERMINED BY ME OR UNDER MY DIRECTION AND CONTROL AND
 THAT THIS U. S. PUBLIC LAND SURVEY MONUMENT RECORD IS CORRECT
 AND COMPLETE TO THE BEST OF MY KNOWLEDGE AND BELIEF.

William C. Jung
 Signature

December 20, 1989
 Date

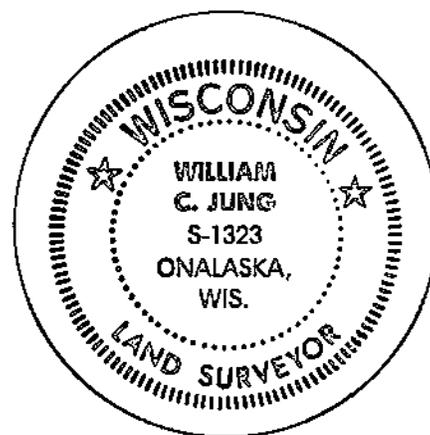


Seal

I, Bryan H. Meyer 1st day of October 1984, do hereby certify that on the 19th day of October 1984, I found (evidence) Section 18 of the Northwest corner of Section 18 T 16 N, R 4 W Fourth Principal Meridian, and I re-established said corner according to the Wisconsin Statutes as shown and described hereon.

Dated this 15th day of Oct. 1984.


Bryan H. Meyer
Deputy County Surveyor

History of corner establishment since Original Government Survey
Henry I. Bliss, County Surveyor of Lacrosse County, surveyed the entire Township of Bangor in 1867 and set monuments at each Section and Quarter corner.
Description of corner evidence found:
Found a 6"x6" stone, up 3", 3' West of a 2-way fence corner. This stone is similar to others found on the West line of the Township of Leon, therefore, I accepted the stone as the corner.

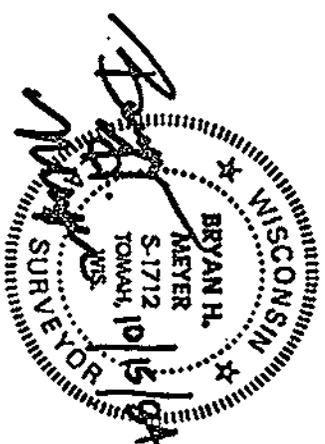


Description of corner and witness monuments, references and accessories used to perpetuate the original or re-established location of this corner:
Crew: Wilhite, Lund
Date: October 1, 1984
Weather: Clear, 65°+
Witnesses to corner location:

Dallas Wilhite
Jim Lund

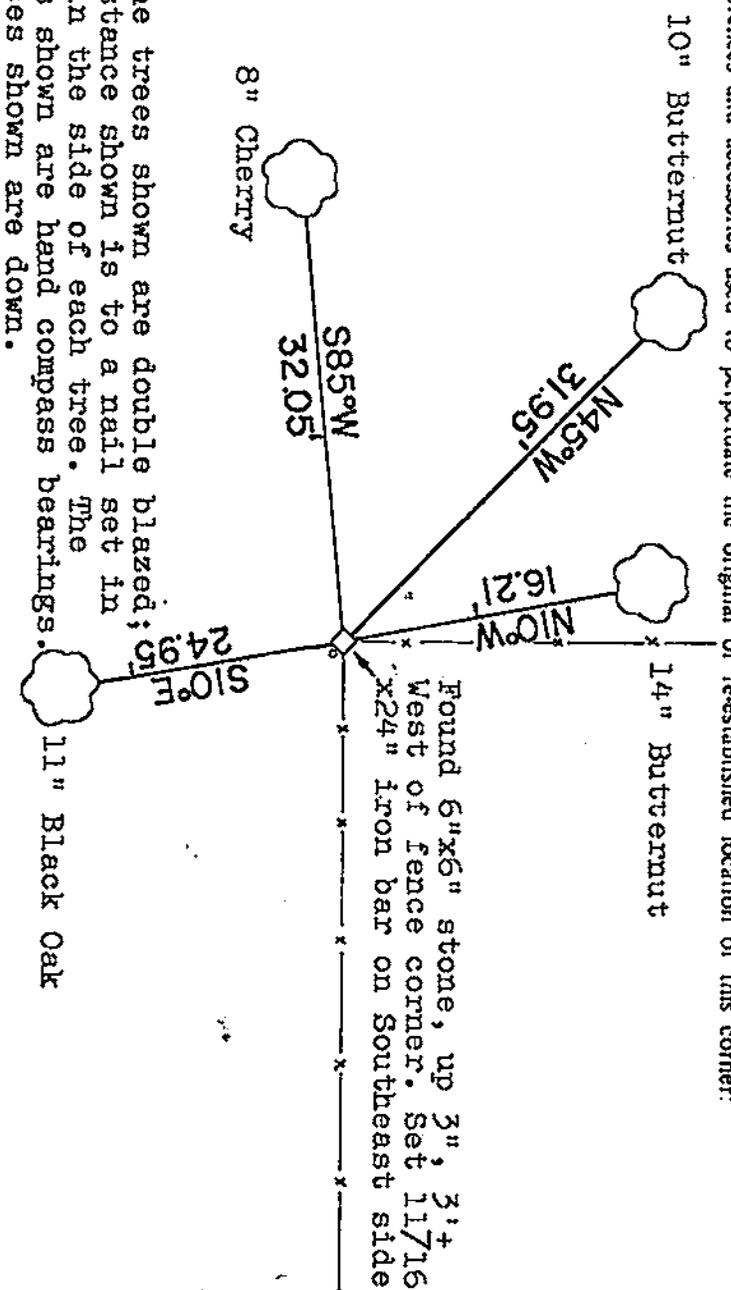

Note: The trees shown are double blazed; each distance shown is to a nail set in a hack in the side of each tree. The bearings shown are hand compass bearings. The fences shown are down.

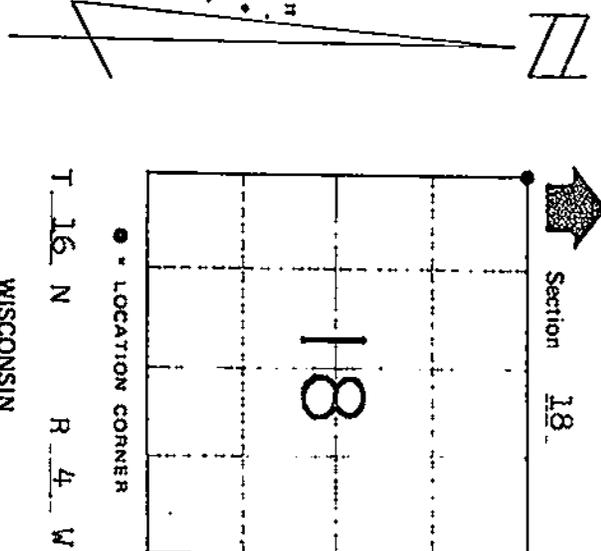

SURVEY CONTROL ORDER

Horizontal		East (X)		North (Y)		Elevation (Z)		Zone
Vertical		Corner						
		Control Sta. Name						

WISCONSIN COORDINATE SYSTEM

Town of Leon
County of Monroe