


21605120020

U. S. PUBLIC LAND SURVEY MONUMENT RECORD

SECTION 12 T 16 N, R 5 W, TOWN OF BANGOR

LA CROSSE COUNTY

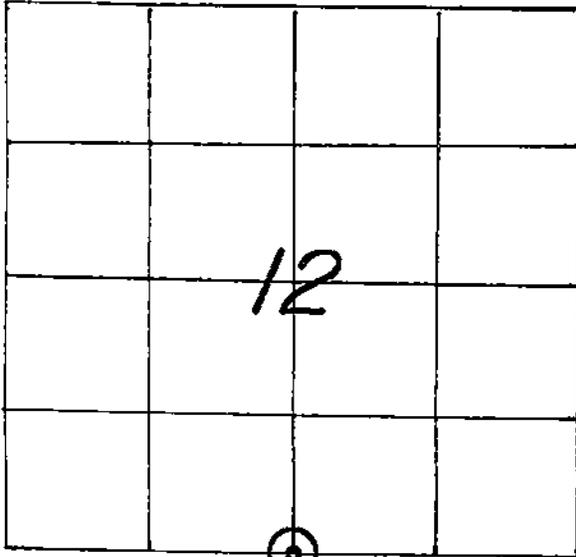

LOCATION OF LANDMARK

CREW: **WILLIAM C. JUNG**
PETER F. FOLLANSBEE
 DATE: **9/26/2006**

WISCONSIN COORDINATE SYSTEM

North **683,063.258**East **1,725,744.284**

Theta Angle

Horiz. Order

Vert. Order

DATUM: **1983('91)**

TYPE OF LANDMARK

"MAG NAIL" & CAP IN PAVEMENT.

BEARINGS ARE REFERENCED TO

GRID NORTH AS PER SECTION DATA.

Describe any record evidence, monument evidence, testimonial evidence or any other material evidence you considered and whether the monument was found or restored through acceptance of an obliterated evidence location.


During regrading and repaving this year the corner monument was damaged and also knocked off plumb. I found remnants of the monument down about 11 inches or so under the new pavement. The Lunde brass cap was gone and the pipe was knocked off plumb to the South. We set a mag nail and cap at the corner. The corner is now 1.8 feet West of the East edge of the new pavement. Digging at this corner was very hard.

Describe or show any material discrepancy between the location of the restored corner and that of the corner previously restored or reestablished.


NONE KNOWN.

RECORD OF DURABLE WITNESS MONUMENTS

NO	DESCRIPTION	GRID BEARINGS	GROUND DISTANCES
		BEARING	DISTANCE
1	RESET AN EXISTING 2" IRON PIPE EAST OF FENCE	N 89°53'18"W	45.33 FT.
2	SET A 3/4"x30" IRON BAR WITH A RED PLASTIC CAP	S 48°22'28"W	258.50 FT.
3	SET A 3/4"x30" IRON BAR WITH A RED PLASTIC CAP	S 10°43'01"W	204.09 FT.
4	SET A P.K. NAIL AT CENTERLINE INTERS'N "J" & "Y"	S 06°56'26"W	95.21 FT.

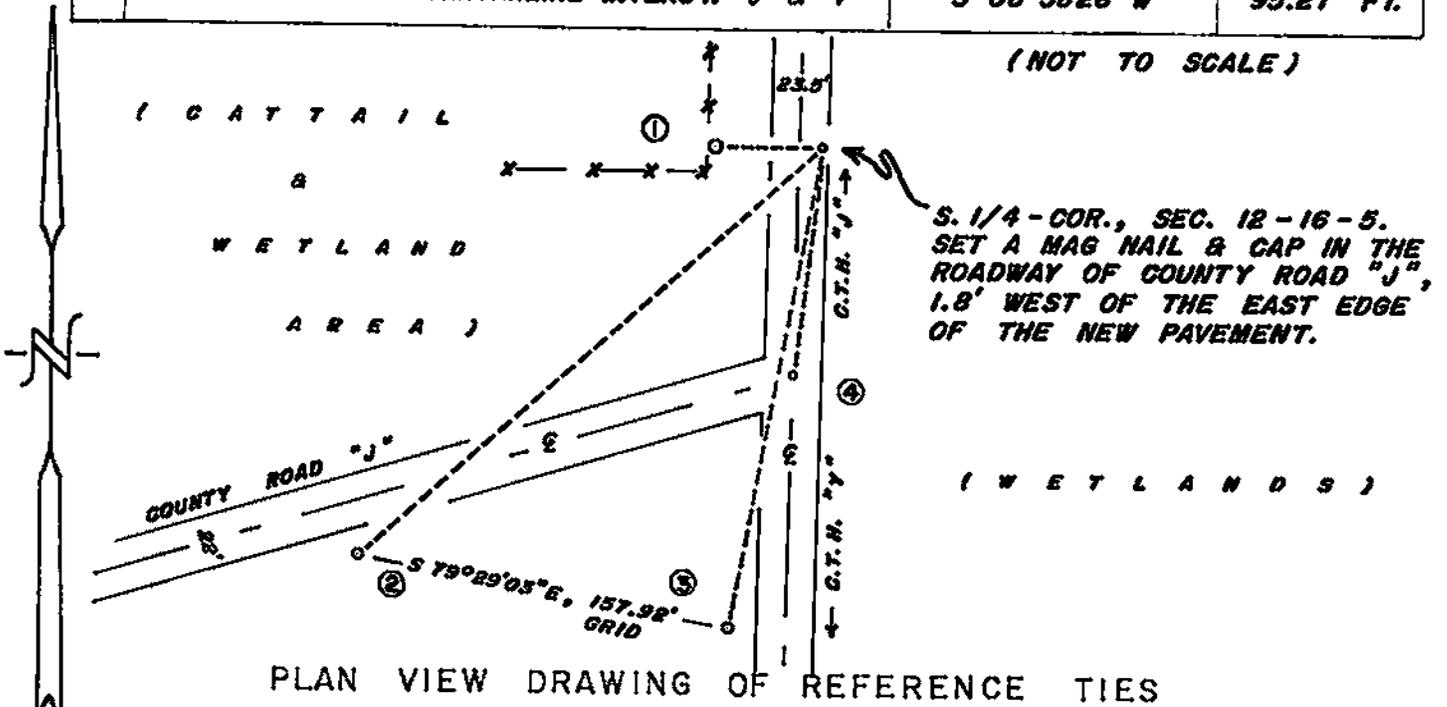

MAP SHOWING DISTANCE AND DIRECTION TO OTHER PUBLIC LAND SURVEY CORNERS USED FOR REESTABLISHING THE CORNER

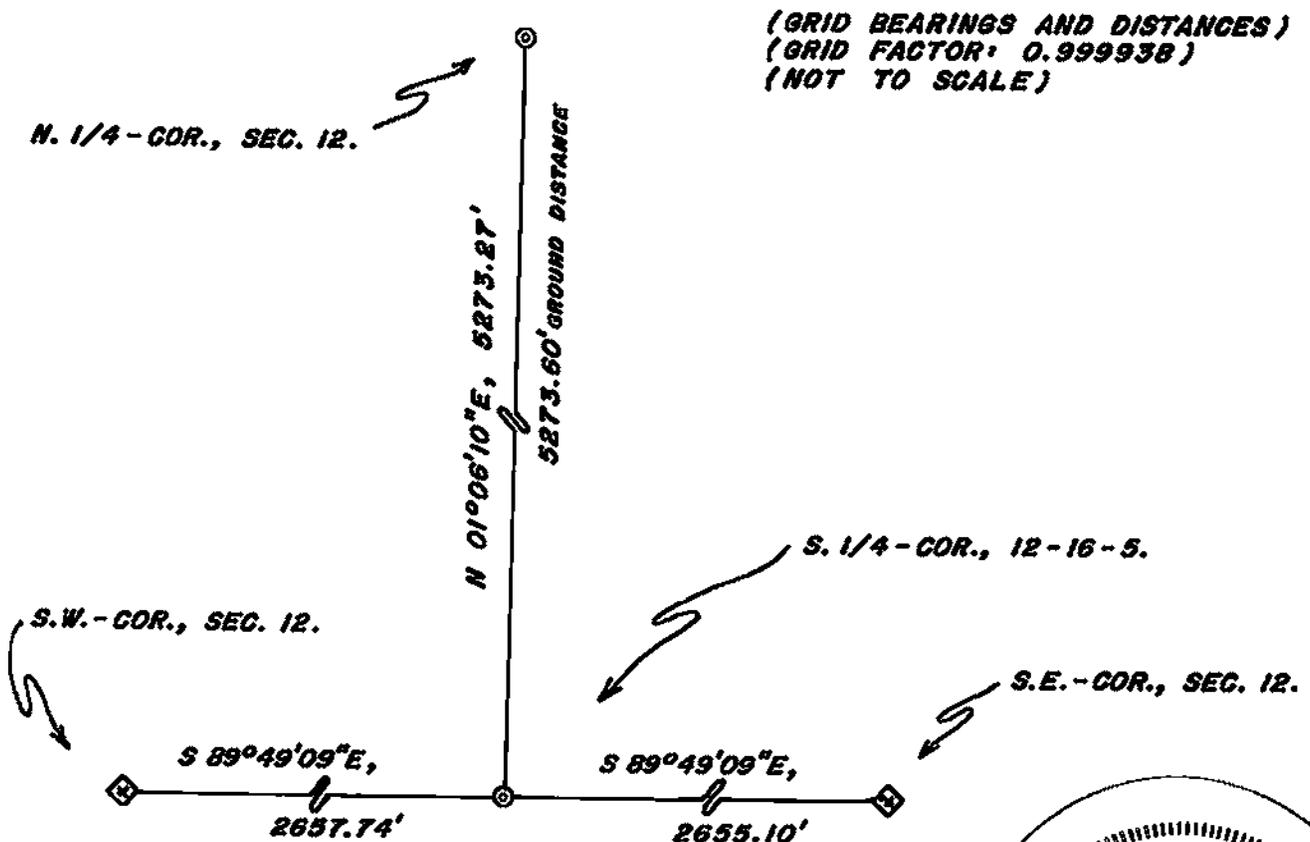

I, WILLIAM G. JUNG, COUNTY SURVEYOR
HEREBY CERTIFY THAT THE CORNER LOCATION SHOWN ON THIS RECORD
WAS DETERMINED BY ME OR UNDER MY DIRECTION AND CONTROL AND
THAT THIS U. S. PUBLIC LAND SURVEY MONUMENT RECORD IS CORRECT
AND COMPLETE TO THE BEST OF MY KNOWLEDGE AND BELIEF.

William G. Jung
Signature

12/7/06
Date




Seal

U. S. PUBLIC LAND SURVEY MONUMENT RECORD

SECTION 12 T 16 N, R 5 W, TOWN OF Bangor

LA CROSSE COUNTY

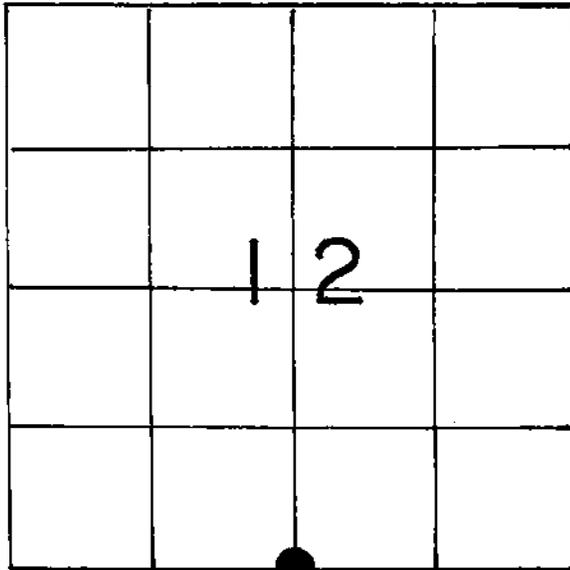

LOCATION OF LANDMARK

WISCONSIN COORDINATE SYSTEM

North

East

Theta Angle

Horiz. Order

Vert. Order

TYPE OF LANDMARK

Brass capped Lunde marker

BEARINGS ARE REFERENCED TO

Assumed North

Crew: William C. Jung
Peter Follansbee

Witness: Dennis Melichar

Date: September 11, 1989

Describe any record evidence, monument evidence, testimonial evidence or any other material evidence you considered and whether the monument was found or restored through acceptance of an obliterated evidence location.


We set a brass capped Lunde marker at Hurlburt's computed location. When we set the corner, Pete and I dug a hole and searched for a possible stone but found nothing. Hurlburt computed out a location that set the corner on line between the section corners and in proportion to Bliss' notes of 1867.

Describe or show any material discrepancy between the location of the restored corner and that of the corner previously restored or reestablished.

None known.

RECORD OF DURABLE WITNESS MONUMENTS


NO	DESCRIPTION	BEARING	DISTANCE
1	Set 2" iron pipe	-----	45.32'
2	Set railroad spike	-----	11.17'
3	Set railroad spike	-----	95.99'
4			

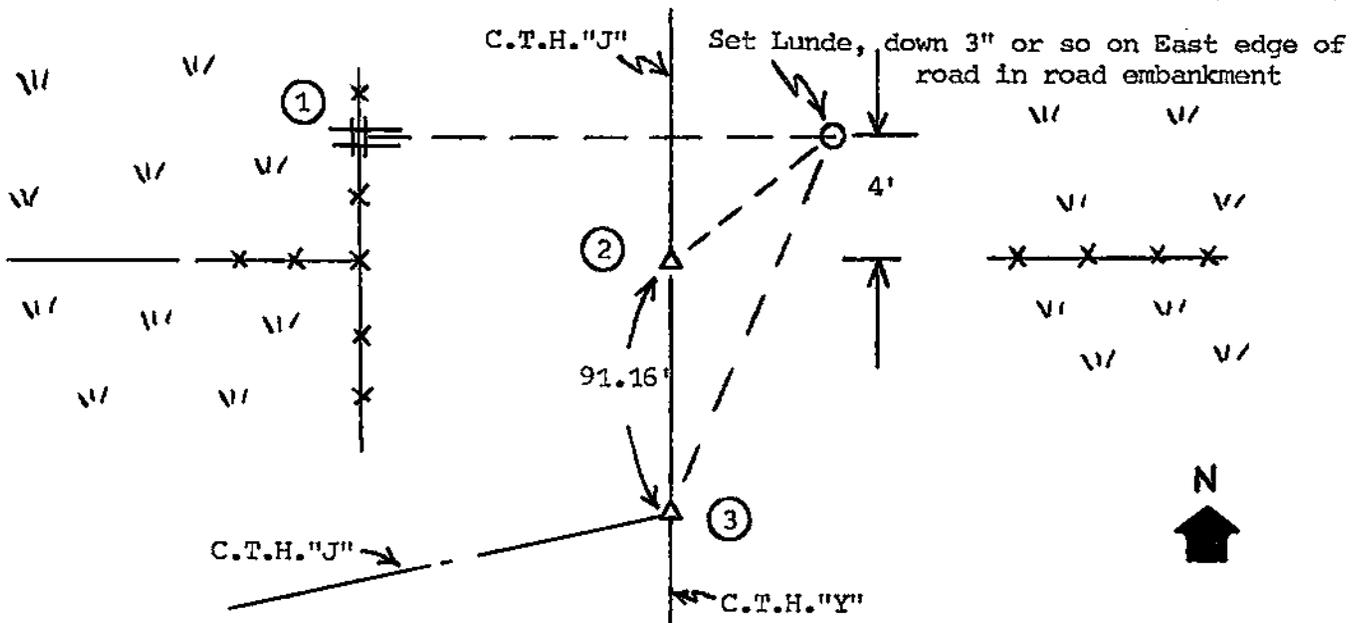

PLAN VIEW DRAWING OF REFERENCE TIES

MAP SHOWING DISTANCE AND DIRECTION TO OTHER PUBLIC LAND SURVEY CORNERS USED FOR REESTABLISHING THE CORNER

(not to scale)

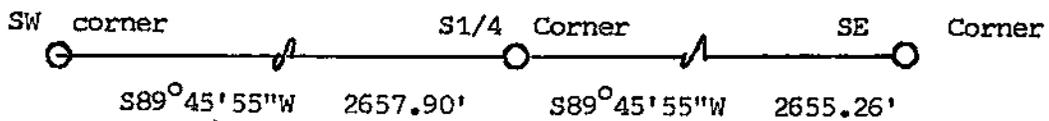


(Hurlburt measurements)

I, William C. Jung, Deputy County Surveyor,
 HEREBY CERTIFY THAT THE CORNER LOCATION SHOWN ON THIS RECORD
 WAS DETERMINED BY ME OR UNDER MY DIRECTION AND CONTROL AND
 THAT THIS U. S. PUBLIC LAND SURVEY MONUMENT RECORD IS CORRECT
 AND COMPLETE TO THE BEST OF MY KNOWLEDGE AND BELIEF.

William C. Jung
 Signature

December 20, 1989
 Date

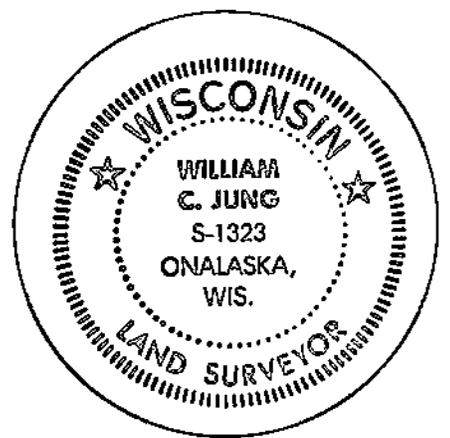

Seal