


21605122000

## U. S. PUBLIC LAND SURVEY MONUMENT RECORD

SECTION 12 T 16 N, R 5 W, TOWN OF Bangor

LA CROSSE COUNTY

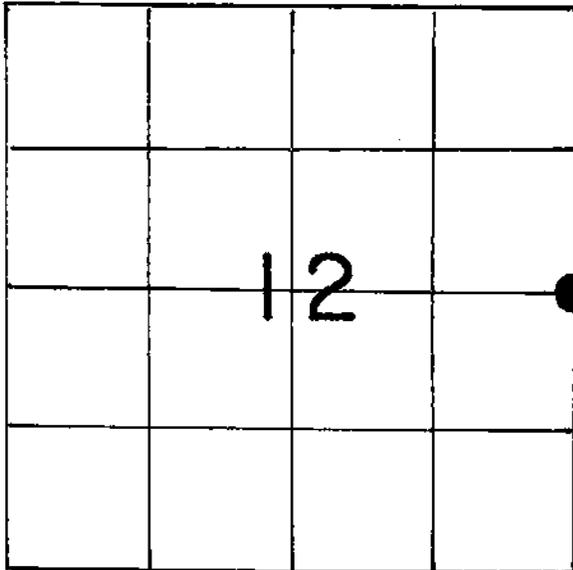

LOCATION OF LANDMARK

WISCONSIN COORDINATE SYSTEM
North
East
Theta Angle
Horiz. Order
Vert. Order
TYPE OF LANDMARK
Stone with a Lunde witness marker
BEARINGS ARE REFERENCED TO
Assumed North

Crew: William C. Jung  
Peter Follansbee

Witness: Dennis Melichar

Date: September 15, 1989

Describe any record evidence, monument evidence, testimonial evidence or any other material evidence you considered and whether the monument was found or restored through acceptance of an obliterated evidence location.


Wilhite and Lund from the Monroe County Surveyor's Office found a broken stone at this corner in October of 1984. I found the stone which had a top broken in four pieces. The bottom and one top piece are intact with a chisel mark on the Northwest corner of the top intact piece being the correct and final corner. As a witness marker, I set a brass capped Lunde marker 0.34' to the East of the stone. I buried two broken pieces of stone around and near the intact stone and Lunde. All tie distances are measured to the witness Lunde.

Describe or show any material discrepancy between the location of the restored corner and that of the corner previously restored or reestablished.

(See previously recorded tie sheet for discrepancies.)


RECORD OF DURABLE WITNESS MONUMENTS  
Magnetic

NO	DESCRIPTION	BEARING	DISTANCE
1	To nail in double blazed 7" hickory	S15°W	31.13'
2	" P.K. " " " 4" "	S71°W	40.15'
3	" nail " " " 6" "	S26°W	14.51'
4	" " " " " 5" "	N76°W	29.20'

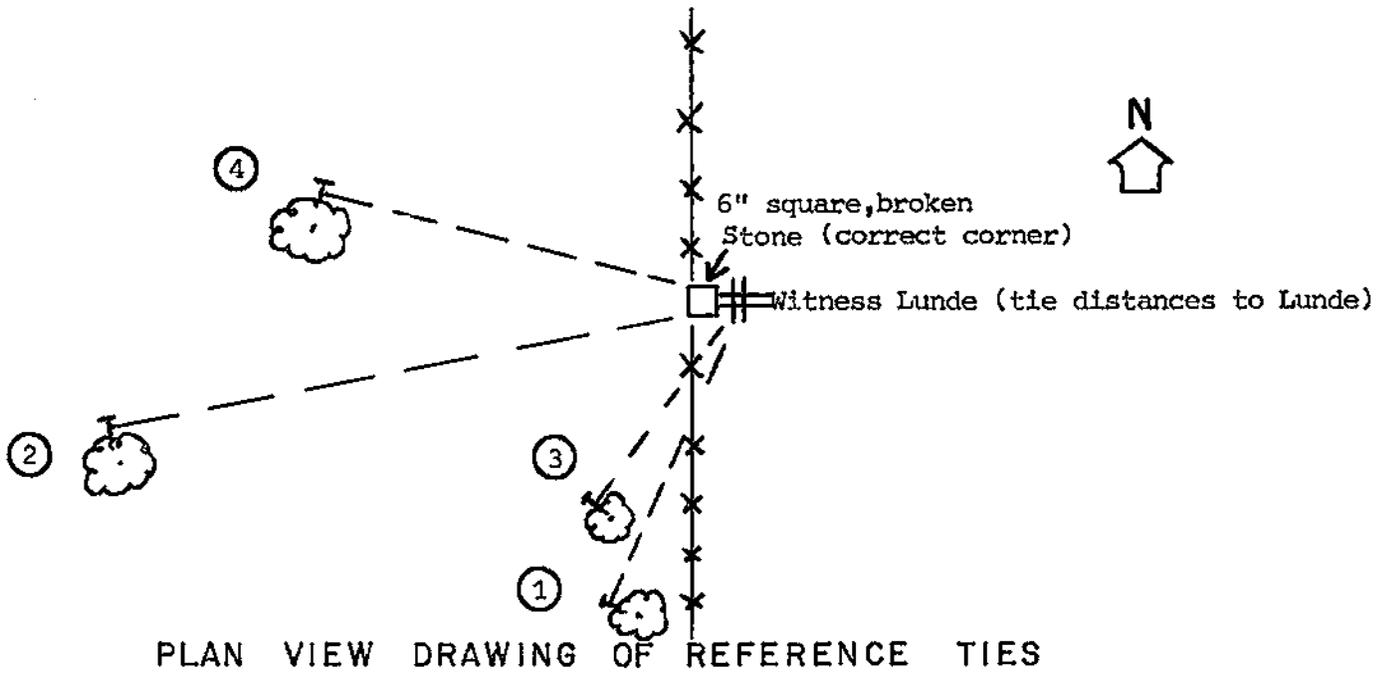

MAP SHOWING DISTANCE AND DIRECTION TO OTHER PUBLIC LAND SURVEY CORNERS USED FOR REESTABLISHING THE CORNER

(not to scale)

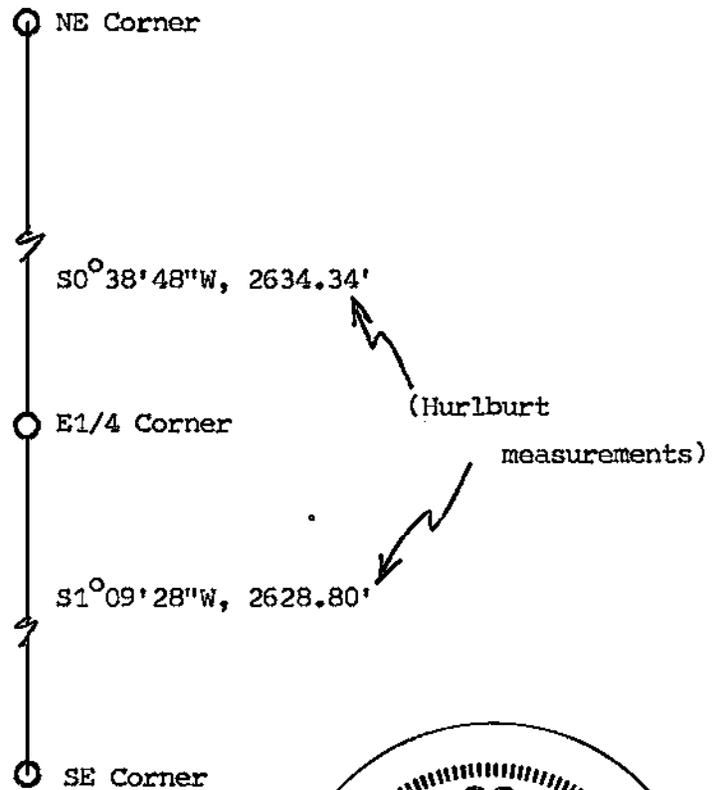

I, William C. Jung, Deputy County Surveyor,  
HEREBY CERTIFY THAT THE CORNER LOCATION SHOWN ON THIS RECORD  
WAS DETERMINED BY ME OR UNDER MY DIRECTION AND CONTROL AND  
THAT THIS U. S. PUBLIC LAND SURVEY MONUMENT RECORD IS CORRECT  
AND COMPLETE TO THE BEST OF MY KNOWLEDGE AND BELIEF.

William C. Jung  
Signature

December 20, 1989  
Date



Seal

CERTIFICATE

CERTIFIED LAND CORNER

Section 12-16-5  
Twp. Bangor

No. 34


I, Bryan H. Meyer, do hereby certify that on the 8th day of October 1984, I found (evidence) Section 7 of the West 1/4 corner of Section 7, T 16, N, R 4 W Fourth Principal Meridian, and I re-established said corner according to the Wisconsin Statutes as shown and described hereon.

Dated this 15th day of Oct. 1984.

*Bryan H. Meyer*  
Deputy County Surveyor  
Twp.



History of corner establishment since Original Government Survey  
Henry I. Bliss, County Surveyor of LaCrosse County, surveyed the entire Township of Bangor, in 1867, and set monuments at each Section and Quarter corner.

Description of corner evidence found:  
Found a 6"x6" stone in a North-South fence line. This stone is split in 2 places. This stone is similar to others found on the West line of the Township of Leon, therefore, I accepted the stone as the corner.

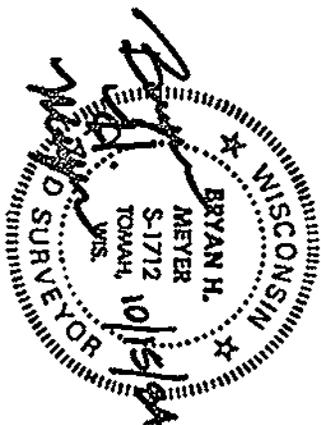

Description of corner and witness monuments, references and accessories used to perpetuate the original or re-established location of this corner:  
Crew: Wilhite, Lund  
Date: October 8, 1984  
Weather: Cloudy, 65°+.  
Witnesses to corner location:  
Dallas Wilhite  
James Lund

Note: The bearings shown are magnetic hand compass bearings.

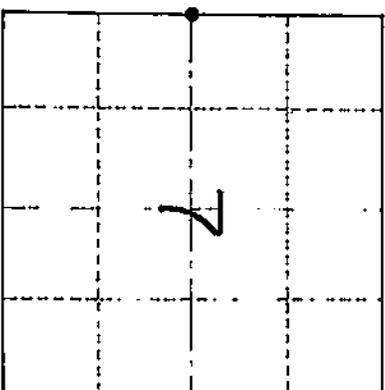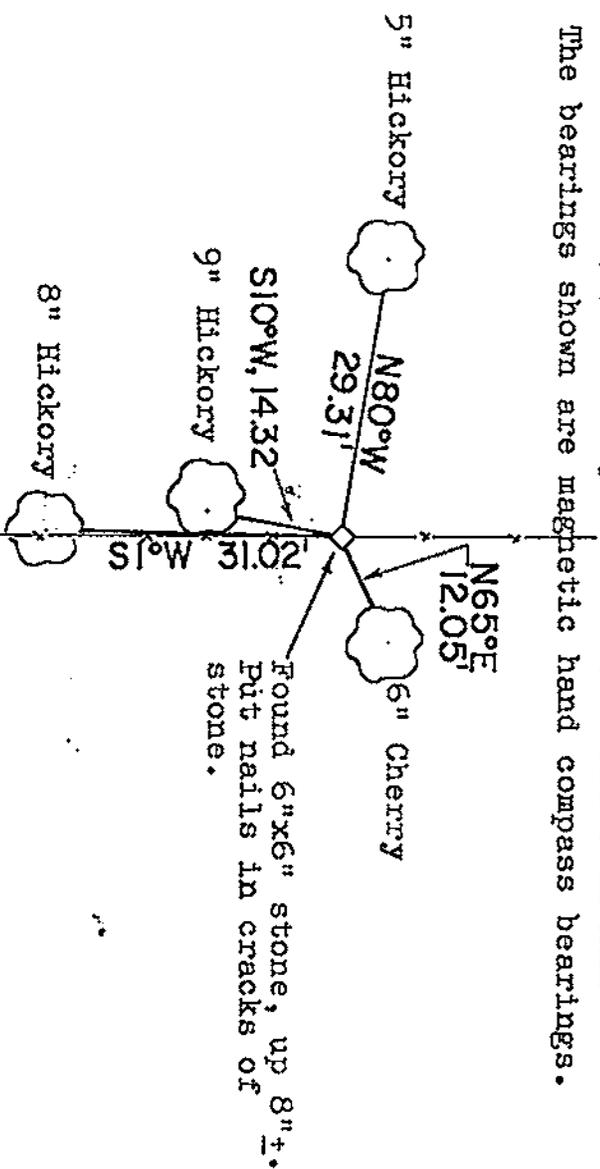

SURVEY CONTROL ORDER

Horizontal	
Vertical	

The four bearing trees shown are double blazed; each distance shown is to a nail set in a hack in the side of the tree.  
WISCONSIN COORDINATE SYSTEM

Corner	East (X)	North (Y)	Elevation (Z)	Zone
Control Sta. Name				

Town of Leon  
County of Monroe