


21605130000

U. S. PUBLIC LAND SURVEY MONUMENT RECORD

SECTION 24 T 16 N, R 5 W, TOWN OF BANGOR

LA CROSSE COUNTY

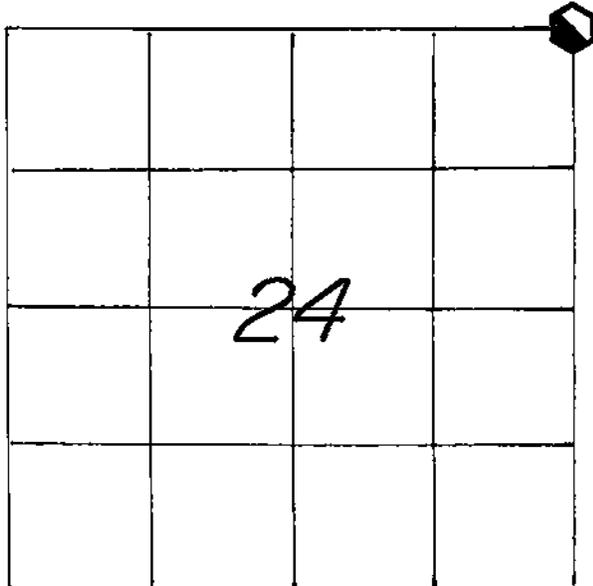

WISCONSIN COORDINATE SYSTEM

North *677,781.356*East *1,728,308.824*

Theta Angle

Horiz. Order

Vert. Order

DATUM: *83('91)*

TYPE OF LANDMARK

*EXISTING HARRISON MARKER.*BEARINGS ARE REFERENCED TO
GRID NORTH AS PER SECTION DATA.

LOCATION OF LANDMARK

CREW: *WILLIAM C. JUNG**PETER F. FOLLANSBEE*DATE: *10/27/2000*

Describe any record evidence, monument evidence, testimonial evidence or any other material evidence you considered and whether the monument was found or restored through acceptance of an obliterated evidence location.


Mike Harding set a Harrison marker at this corner. After analyzing this position and work done previously by Rodney Maxwell, I agree with the location of this Harrison and accepted it as the corner.

Describe or show any material discrepancy between the location of the restored corner and that of the corner previously restored or reestablished.

NONE KNOWN.


RECORD OF DURABLE WITNESS MONUMENTS
MAGNETIC

NO	DESCRIPTION	BEARING	DISTANCE
1	EX. NAIL IN THE S.E.-SIDE OF A CLUSTER OF MAPLES	N 54° W	32.06 FT.
2	SET A NAIL IN S.W.-SIDE OF A TRIPLE BOX ELDER	S 63° E	37.03 FT.
3	EX. 3/8" IRON ROD NEAR A FENCE CORNER	S 55° E	34.63 FT.
4	SET A NAIL IN W.-SIDE OF A DOUBLE BOX ELDER	S 31° E	63.11 FT.

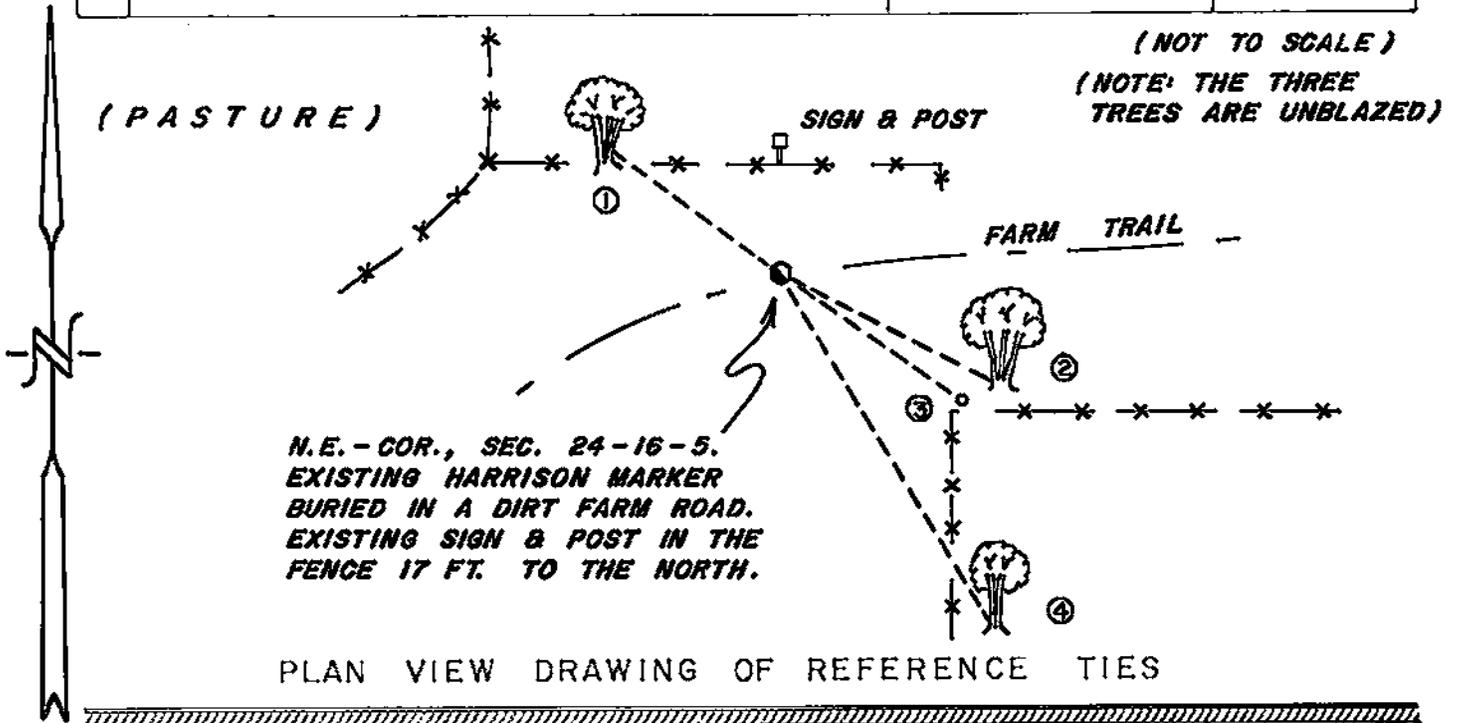


MAP SHOWING DISTANCE AND DIRECTION TO OTHER PUBLIC LAND SURVEY CORNERS USED FOR REESTABLISHING THE CORNER

(GRID BEARINGS AND DISTANCES)
(not to scale)

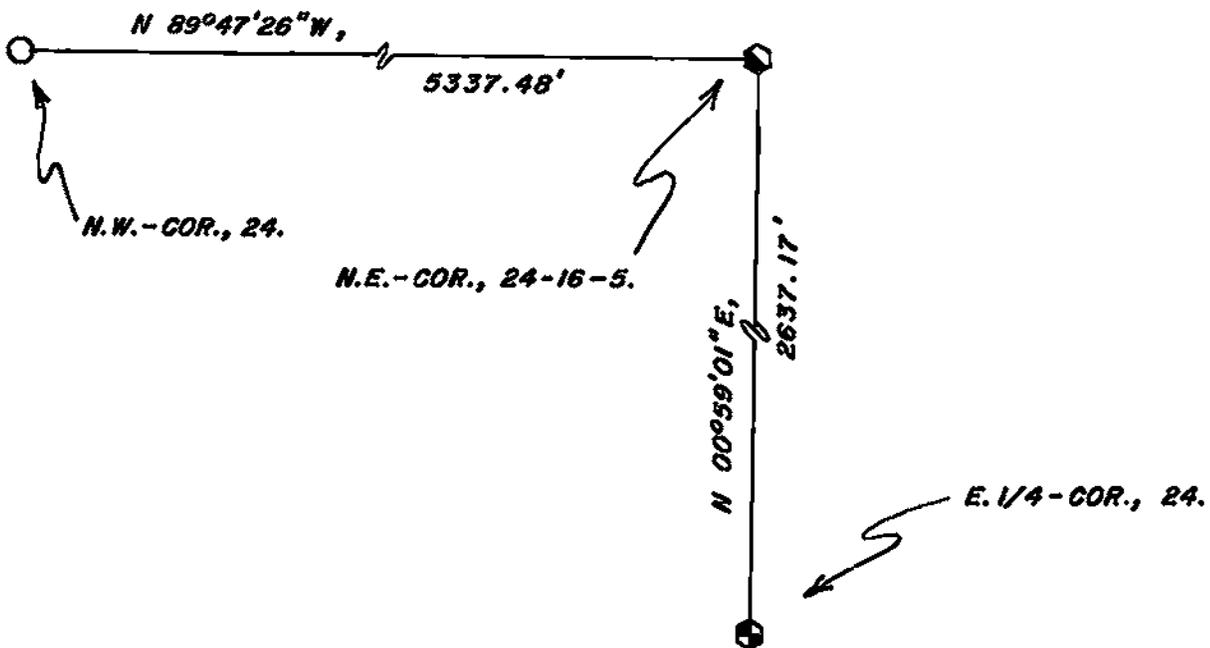

I, WILLIAM C. JUNG, COUNTY SURVEYOR
HEREBY CERTIFY THAT THE CORNER LOCATION SHOWN ON THIS RECORD
WAS DETERMINED BY ME OR UNDER MY DIRECTION AND CONTROL AND
THAT THIS U. S. PUBLIC LAND SURVEY MONUMENT RECORD IS CORRECT
AND COMPLETE TO THE BEST OF MY KNOWLEDGE AND BELIEF.

William C. Jung 11/17/00
Signature Date

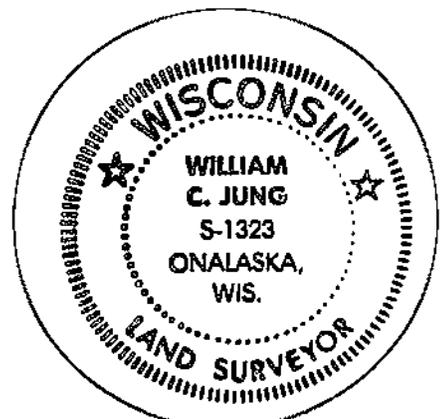

Seal