


21605130020

## U. S. PUBLIC LAND SURVEY MONUMENT RECORD

SECTION 24 T 16 N, R 5 W, TOWN OF BANGOR

LA CROSSE COUNTY

LAT: 43°51'21.39648" N  
 LONG: 90°35'14.51894" W  
 ELLIP. HEIGHT IN METERS: (350.431m)

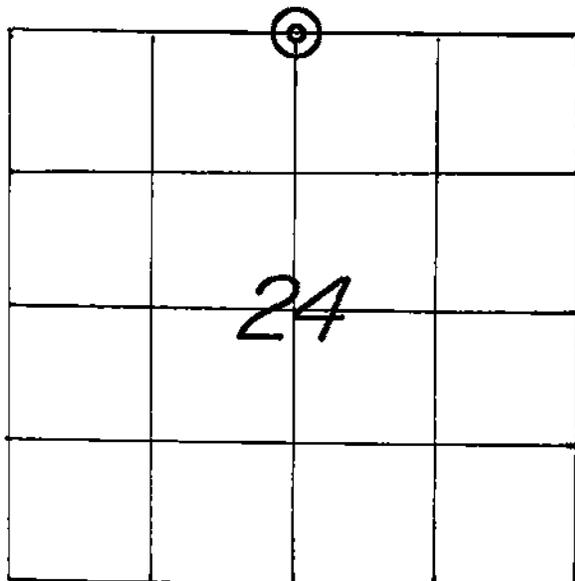

WISCONSIN COORDINATE SYSTEM

North 677,786.976

East 1,725,652.425

Theta Angle

Horiz. Order

Vert. Order

DATUM: 1983('91)

TYPE OF LANDMARK

3/4" x 30" IRON BAR WITH RED PLASTIC CAP

BEARINGS ARE REFERENCED TO

GRID NORTH AS PER SECTION DATA.

LOCATION OF LANDMARK

CREW: WILLIAM C. JUNG  
 PETER F. FOLLANSBEE  
 DATE: 9/17/2008

Describe any record evidence, monument evidence, testimonial evidence or any other material evidence you considered and whether the monument was found or restored through acceptance of an obliterated evidence location.

We searched twice at great length for the 1867 Bliss stone but could not find it. I did find a rotted 3 foot oak stump to the Southwest which I believe to be the original bearing tree stump. I set the corner off this stump and set a capped iron bar.


Describe or show any material discrepancy between the location of the restored corner and that of the corner previously restored or reestablished.

NONE KNOWN.

RECORD OF DURABLE WITNESS MONUMENTS


MAGNETIC

NO	DESCRIPTION	BEARING	DISTANCE
1	SET A NAIL IN N.-SIDE OF A 21" BURR OAK	S 70° W	9.90 FT.
2	SET A NAIL IN S.E.-SIDE OF A 5-1/2" ELM	N 28° E	12.14 FT.
3	SET A NAIL IN S.-SIDE OF A 3-1/2" HICKORY	N 85° E	6.65 FT.
4	SET A NAIL IN S.W.-SIDE OF A 7-1/2" HICKORY	S 47° E	9.40 FT.

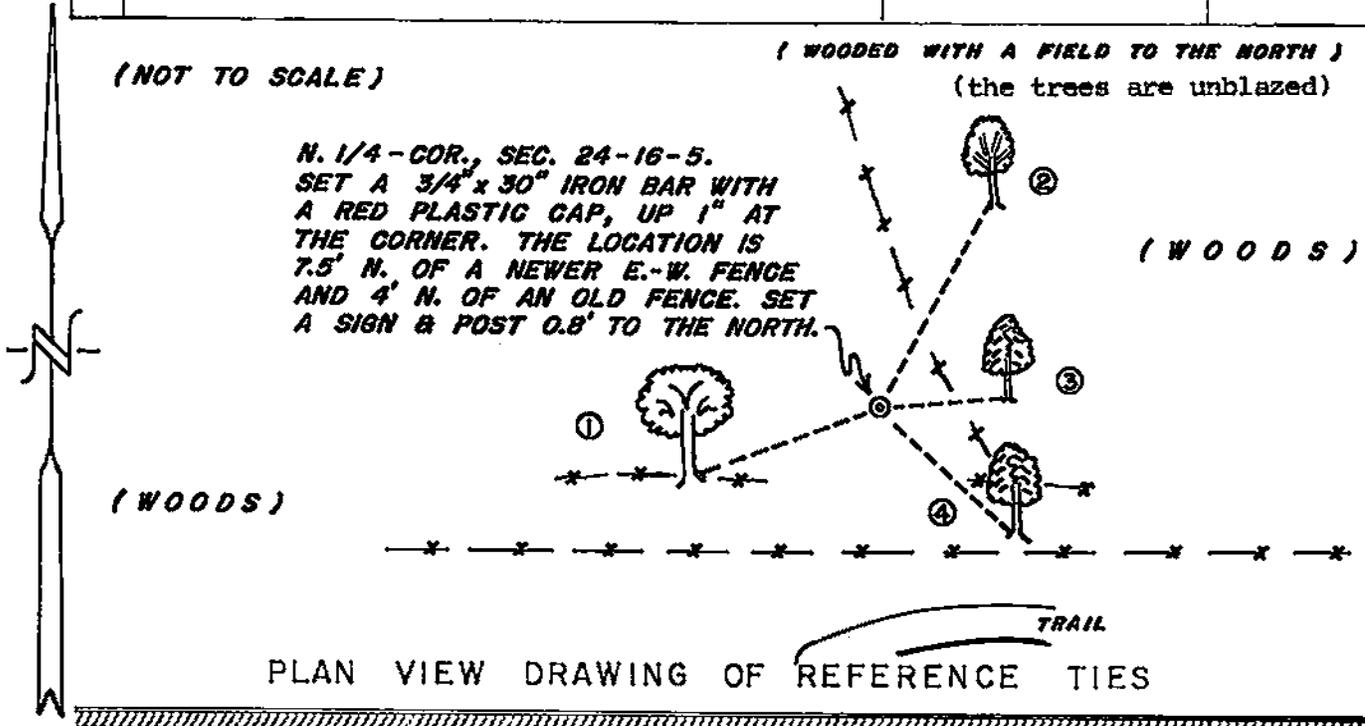

MAP SHOWING DISTANCE AND DIRECTION TO OTHER PUBLIC LAND SURVEY CORNERS USED FOR REESTABLISHING THE CORNER

(GRID BEARINGS AND DISTANCES)  
(GRID FACTOR: 0.99991)  
(NOT TO SCALE)

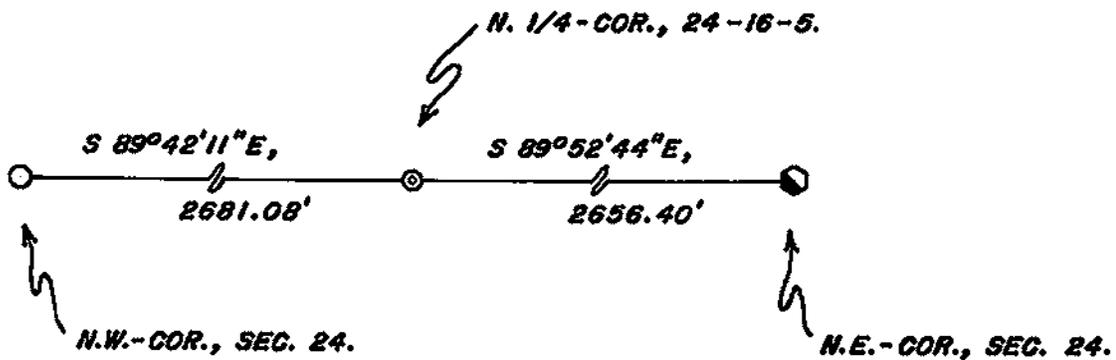

I, WILLIAM G. JUNG, COUNTY SURVEYOR  
HEREBY CERTIFY THAT THE CORNER LOCATION SHOWN ON THIS RECORD WAS DETERMINED BY ME OR UNDER MY DIRECTION AND CONTROL AND THAT THIS U. S. PUBLIC LAND SURVEY MONUMENT RECORD IS CORRECT AND COMPLETE TO THE BEST OF MY KNOWLEDGE AND BELIEF.

William G. Jung 10/29/08  
Signature Date



Seal