


21605140020

U. S. PUBLIC LAND SURVEY MONUMENT RECORD

SECTION 23 T 16 N, R 5 W, TOWN OF BANGOR

LA CROSSE COUNTY

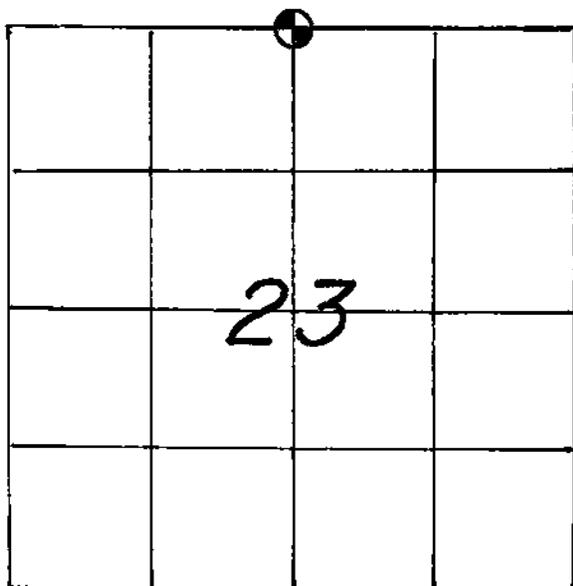

LOCATION OF LANDMARK

WISCONSIN COORDINATE SYSTEM

North

East

Theta Angle

Horiz. Order

Vert. Order

TYPE OF LANDMARK

Ex. 1-3/4" Iron Pipe over stone base.

BEARINGS ARE REFERENCED TO

Crew: WILLIAM C. JUNG
 PETER F. FOLLANSBEE
 Date: 10/31/1995

Describe any record evidence, monument evidence, testimonial evidence or any other material evidence you considered and whether the monument was found or restored through acceptance of an obliterated evidence location.


I found a pipe set over the base of the old stone set at the corner. The pipe and stone had been used in surveys by Solberg and Lampman. I accepted this location as the best available evidence of the original government corner location.

Describe or show any material discrepancy between the location of the restored corner and that of the corner previously restored or reestablished.

None Known.

RECORD OF DURABLE WITNESS MONUMENTS

NO	DESCRIPTION	MAGNETIC	DISTANCE
		BEARING	
1	Set P.K. Nail in SW-side 22" W. Oak (unblazed)	S 85° E	23.18 Ft.
2	Set P.K. Nail in SW-side 18" W. Oak (unblazed)	S 64° E	17.24 Ft.
3	Set P.K. Nail in NE-side 16" Hickory (ex. blaze)	S 32° E	Sl.= 59.54'
4	Set P.K. Nail in E.-side 23" W. Oak (ex. blaze)	S 06° E	Sl.= 68.00'

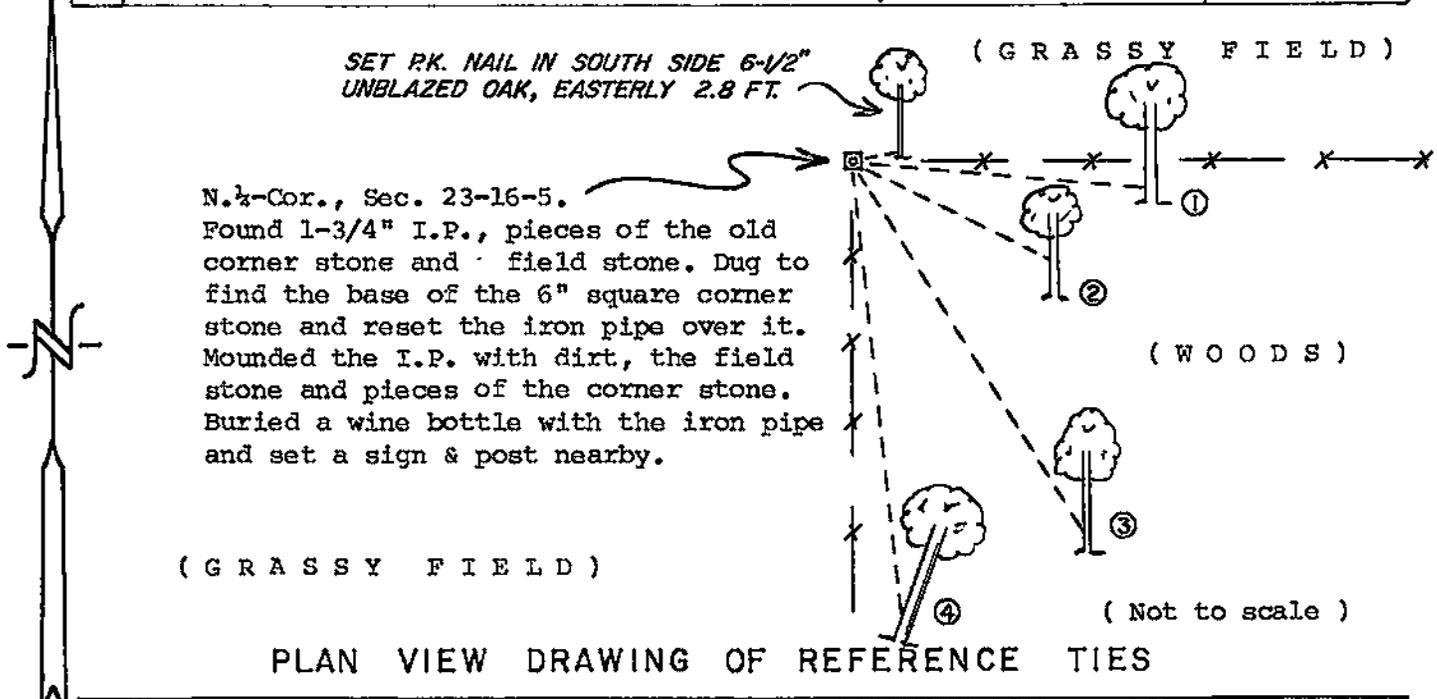


MAP SHOWING DISTANCE AND DIRECTION TO OTHER PUBLIC LAND SURVEY CORNERS USED FOR REESTABLISHING THE CORNER

No section measurements were made by me at this time.

I, William C. Jung, County Surveyor
 HEREBY CERTIFY THAT THE CORNER LOCATION SHOWN ON THIS RECORD WAS DETERMINED BY ME OR UNDER MY DIRECTION AND CONTROL AND THAT THIS U. S. PUBLIC LAND SURVEY MONUMENT RECORD IS CORRECT AND COMPLETE TO THE BEST OF MY KNOWLEDGE AND BELIEF.

William C. Jung 12/5/95
 Signature Date

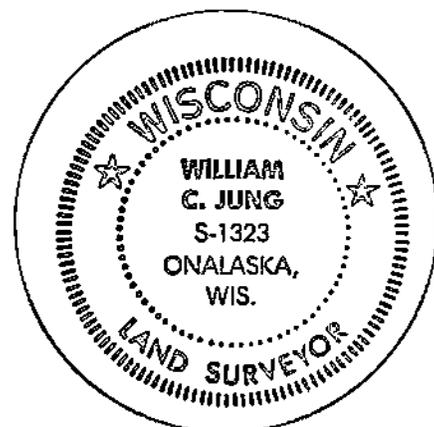

Seal