


21605142000

U. S. PUBLIC LAND SURVEY MONUMENT RECORD

SECTION 13 T 16 N, R 5 W, TOWN OF BANGOR

LA CROSSE COUNTY

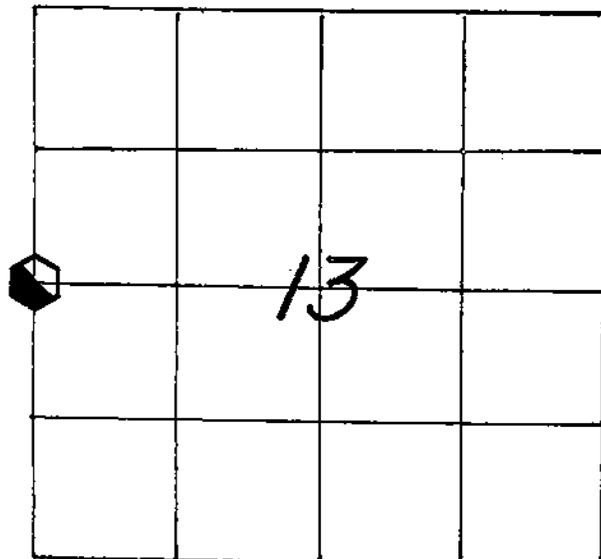

LOCATION OF LANDMARK

CREW: **WILLIAM C. JUNG**
PETER F. FOLLANSBEE
 DATE: **7/27/2005**

WISCONSIN COORDINATE SYSTEM	
North	680,434.692
East	1,723,043.275
Theta Angle	
Horiz. Order	
Vert. Order	
DATUM:	1983('91)
TYPE OF LANDMARK	
3" x 30" ALUMINUM BERNTSEN MARKER.	
BEARINGS ARE REFERENCED TO	
GRID NORTH AS PER SECTION DATA.	

Describe any record evidence, monument evidence, testimonial evidence or any other material evidence you considered and whether the monument was found or restored through acceptance of an obliterated evidence location.

We found the 1867 Bliss stone broken into 19 pieces. I set a 3"x30" Berntsen marker at the location of the old stone and made ties. The stone pieces mark the position of the original government corner. I buried the stone pieces with the Berntsen.


A sign and post were set nearby.

Describe or show any material discrepancy between the location of the restored corner and that of the corner previously restored or reestablished.

NONE KNOWN.


RECORD OF DURABLE WITNESS MONUMENTS

NO	DESCRIPTION	MAGNETIC	
		BEARING	DISTANCE
1	SET A NAIL IN N.-SIDE OF A BASSWOOD CLUSTER	WEST ±	13.33 FT.
2	SET A NAIL IN N.E.-SIDE OF A 24 1/2" OAK	N 78° W	27.87 FT.
3	SET A NAIL IN S.W.-SIDE OF A 17" OAK	N 75° E	31.60 FT.
4	SET A NAIL IN N.-SIDE OF A 16" OAK	EASTERLY ±	29.90 FT.

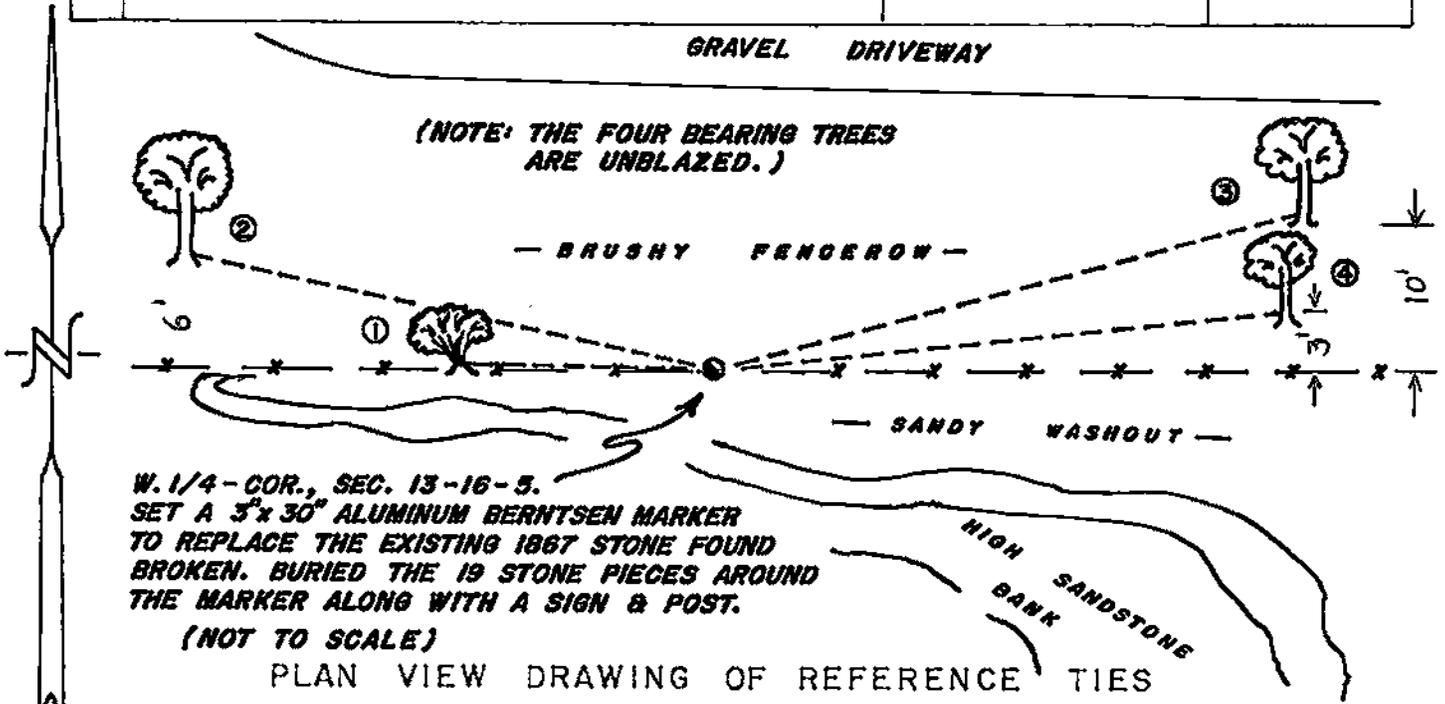


MAP SHOWING DISTANCE AND DIRECTION TO OTHER PUBLIC LAND SURVEY CORNERS USED FOR REESTABLISHING THE CORNER

(GRID BEARINGS AND DISTANCES)
 (GRID FACTOR: 0.99994)
 (NOT TO SCALE)

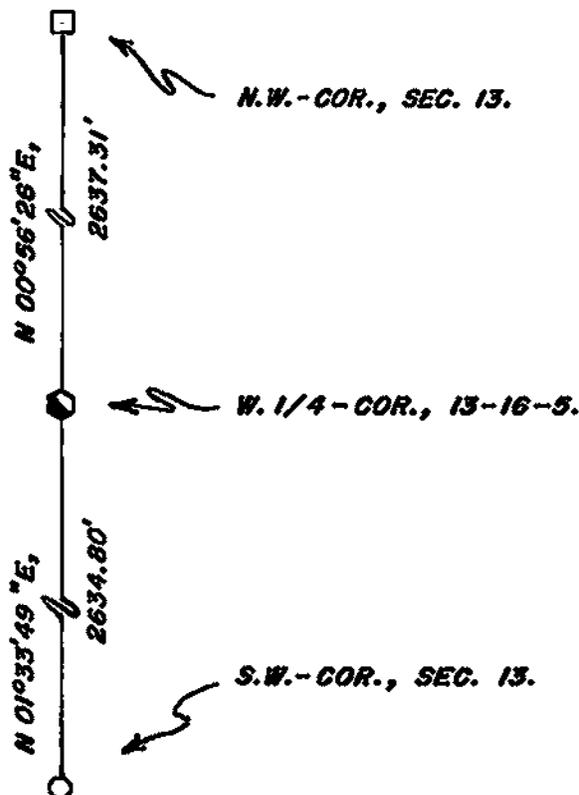

I, WILLIAM C. JUNG, COUNTY SURVEYOR
 HEREBY CERTIFY THAT THE CORNER LOCATION SHOWN ON THIS RECORD WAS DETERMINED BY ME OR UNDER MY DIRECTION AND CONTROL AND THAT THIS U. S. PUBLIC LAND SURVEY MONUMENT RECORD IS CORRECT AND COMPLETE TO THE BEST OF MY KNOWLEDGE AND BELIEF.

William C. Jung 11/28/05
 Signature Date

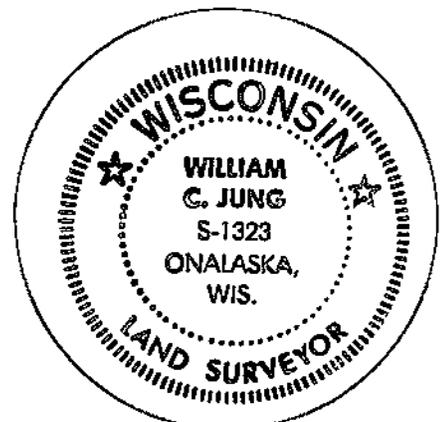

Seal