


U. S. PUBLIC LAND SURVEY MONUMENT RECORD

SECTION 23 T 16 N, R 5 W, TOWN OF BANGOR

LA CROSSE COUNTY

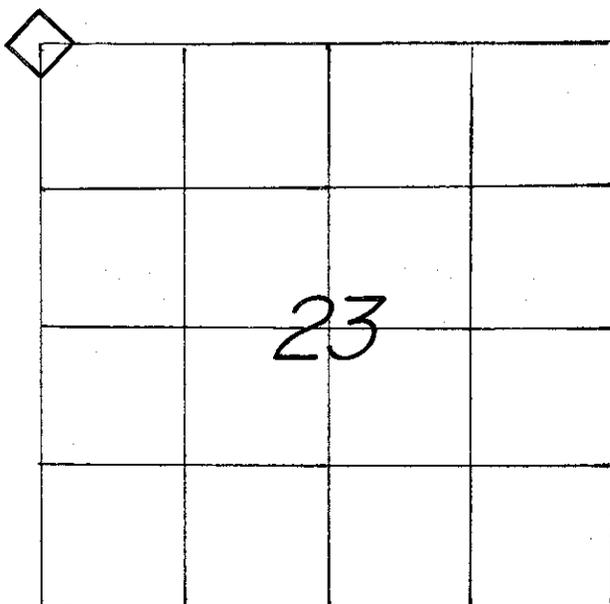

LOCATION OF LANDMARK

CREW: **BRYAN H. MEYER**
PETER F. FOLLANSBEE
 DATE: **12/02/2009**

WISCONSIN COORDINATE SYSTEM	
North	677,845.576
East	1,717,746.101
Theta Angle	
Horiz. Order	
Vert. Order	
DATUM:	1983('91)
TYPE OF LANDMARK	
STONE MONUMENT.	
BEARINGS ARE REFERENCED TO	
GRID NORTH AS PER SECTION DATA.	

Describe any record evidence, monument evidence, testimonial evidence or any other material evidence you considered and whether the monument was found or restored through acceptance of an obliterated evidence location.

Describe or show any material discrepancy between the location of the restored corner and that of the corner previously restored or reestablished.

RECORD OF DURABLE WITNESS MONUMENTS

MAGNETIC

NO	DESCRIPTION	BEARING	DISTANCE
1	SET A NEW NAIL IN E.-SIDE OF A 28" WHITE OAK	N 11° W	38.37 FT.
2	SET A NAIL IN N.W.-SIDE OF A 15-1/2" HICKORY	N 29° E	49.31 FT.
3	SET A NEW NAIL IN W.-SIDE OF A 27-1/2" WHITE OAK	S 06° E	26.82 FT.
4	SET A NEW NAIL IN N.W.-SIDE OF A 26" WHITE OAK	S 49° W	13.30 FT.

N.W.-COR., SEC. 23-16-5.
EX. SCRIBED STONE, UP 17"s AND
NEAR THE FENCE INTERSECTION.
REPLUMBED THE STONE AND TOOK
NEW TIES.

(WOODS)

(WOODS)

(WOODS)

(NOTE: THE FOUR BEARING TREES HAVE
EXISTING OR NEW DOUBLE BLAZES).


(NOT TO SCALE)

PLAN VIEW DRAWING OF REFERENCE TIES

MAP SHOWING DISTANCE AND DIRECTION TO OTHER PUBLIC LAND
SURVEY CORNERS USED FOR REESTABLISHING THE CORNER

(GRID BEARINGS AND DISTANCES)
(GRID FACTOR: 0.999911881)
(NOT TO SCALE)


E. 1/4 - COR., SEC. 15.

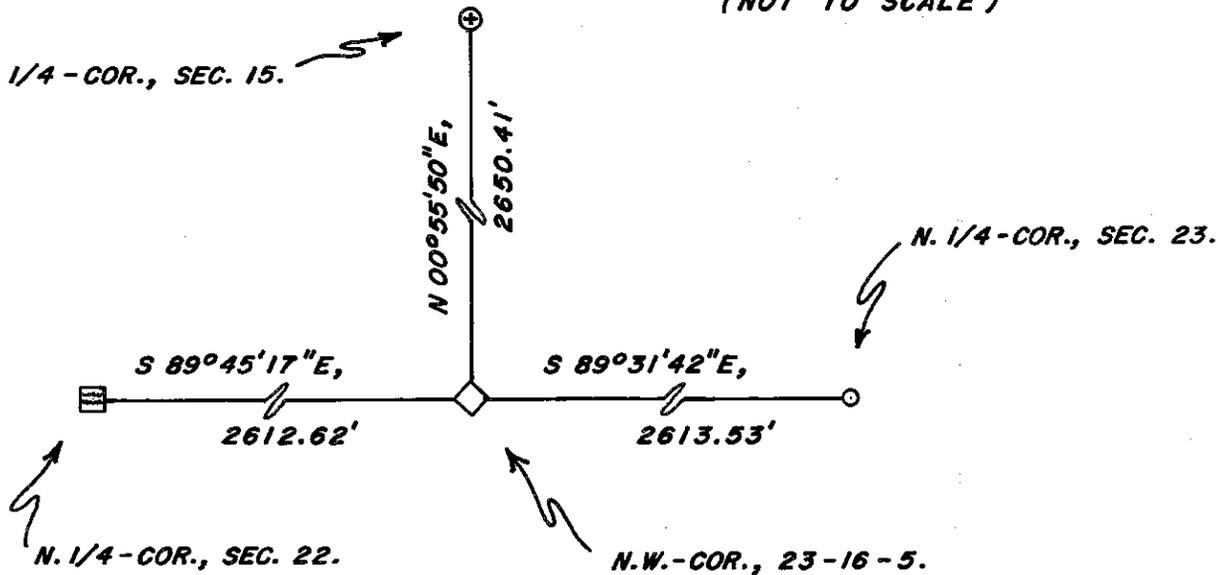

I, BRYAN H. MEYER, COUNTY SURVEYOR
HEREBY CERTIFY THAT THE CORNER LOCATION SHOWN ON THIS RECORD
WAS DETERMINED BY ME OR UNDER MY DIRECTION AND CONTROL AND
THAT THIS U. S. PUBLIC LAND SURVEY MONUMENT RECORD IS CORRECT
AND COMPLETE TO THE BEST OF MY KNOWLEDGE AND BELIEF.

Bryan H. Meyer
Signature

July 9, 2010
Date

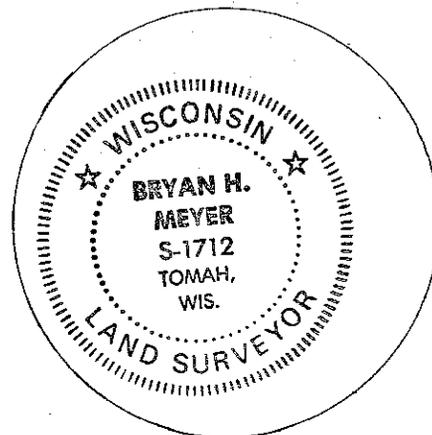


Seal

21605150000

NW CORNER, SECTION 23 - T16N - R5W

TOWN OF BANGOR

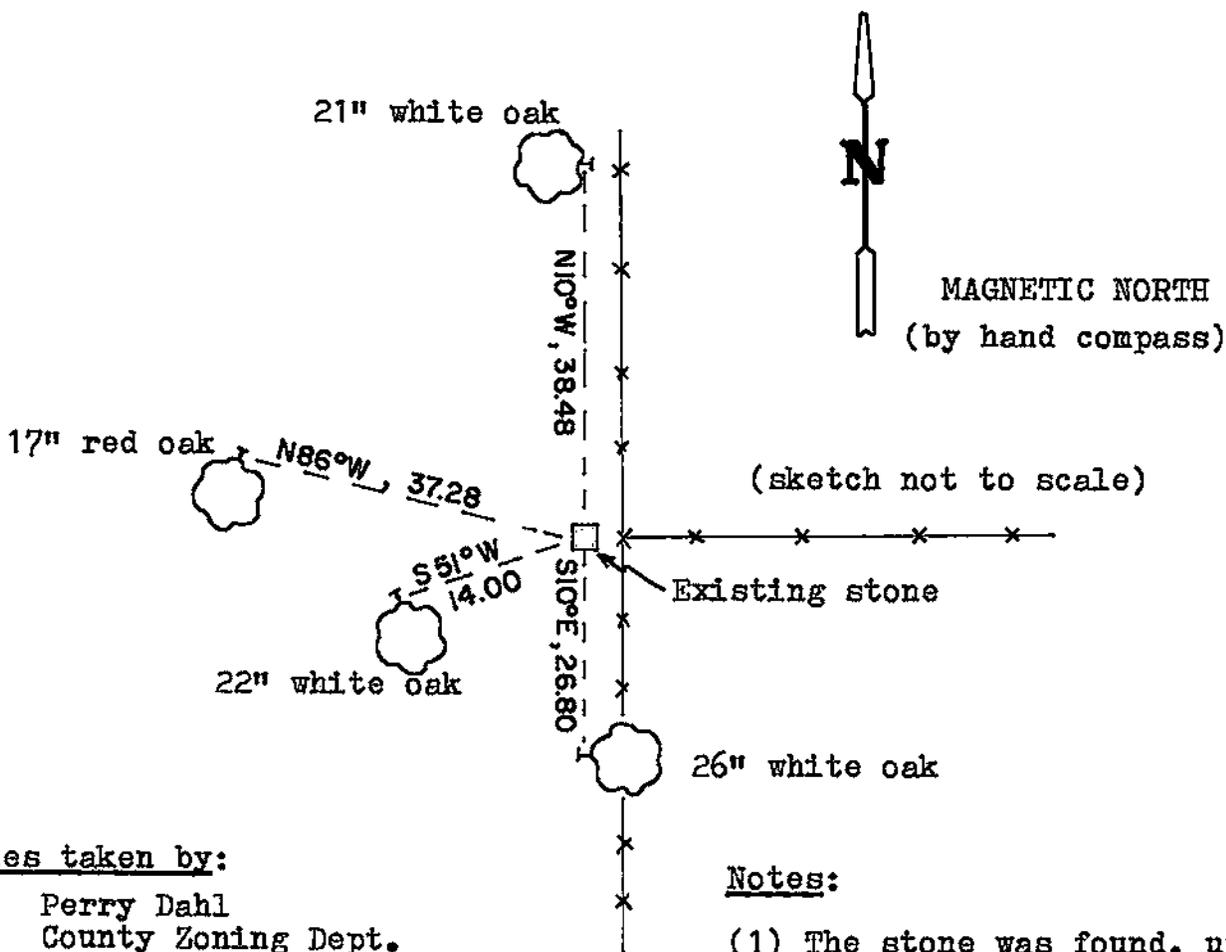

Ties taken by:

Perry Dahl
County Zoning Dept.
10/29/85
Witness: Sid Kirking

Notes:

- (1) The stone was found, up 17". It was plumbed up by Dahl.
- (2) The section numbers were scribed on the stone.
- (3) All the distances are slope distances.
- (4) All the trees are double blazed with each distance to a nail in a hack on the side of the tree