


## U. S. PUBLIC LAND SURVEY MONUMENT RECORD

SECTION 22 T 16 N, R 5 W, TOWN OF BANGOR

LA CROSSE COUNTY

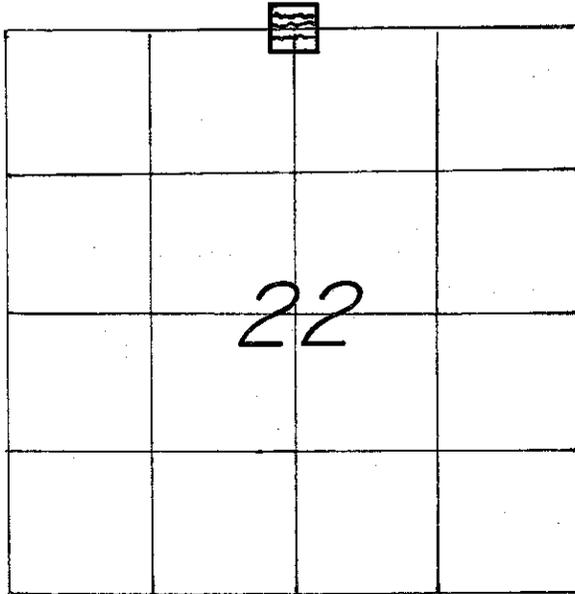

LOCATION OF LANDMARK

CREW: **BRYAN H. MEYER**  
**PETER F. FOLLANSBEE**  
 DATE: **12/02/2009**


WISCONSIN COORDINATE SYSTEM	
North	677,856.764
East	1,715,133.509
Theta Angle	
Horiz. Order	
Vert. Order	
DATUM:	1983('91)
TYPE OF LANDMARK	
6" x 6" SQUARE STONE. (BROKEN)	
BEARINGS ARE REFERENCED TO	
GRID NORTH AS PER SECTION DATA.	

Describe any record evidence, monument evidence, testimonial evidence or any other material evidence you considered and whether the monument was found or restored through acceptance of an obliterated evidence location.


Describe or show any material discrepancy between the location of the restored corner and that of the corner previously restored or reestablished.

RECORD OF DURABLE WITNESS MONUMENTS  
MAGNETIC

NO	DESCRIPTION	BEARING	DISTANCE
1	SET A NEW NAIL IN N.E.-SIDE OF AN 8-1/2" BL. OAK	N 37° W	19.85 FT.
2	SET A NEW NAIL IN N.W.-SIDE OF A 12" W. OAK	N 42° E	17.49 FT.
3	SET A NEW NAIL IN E.-SIDE OF A 7" HICKORY	S 30° W	12.50 FT.
4	SET A NAIL IN N.-SIDE OF AN 8" ASH	N 81° W	13.36 FT.

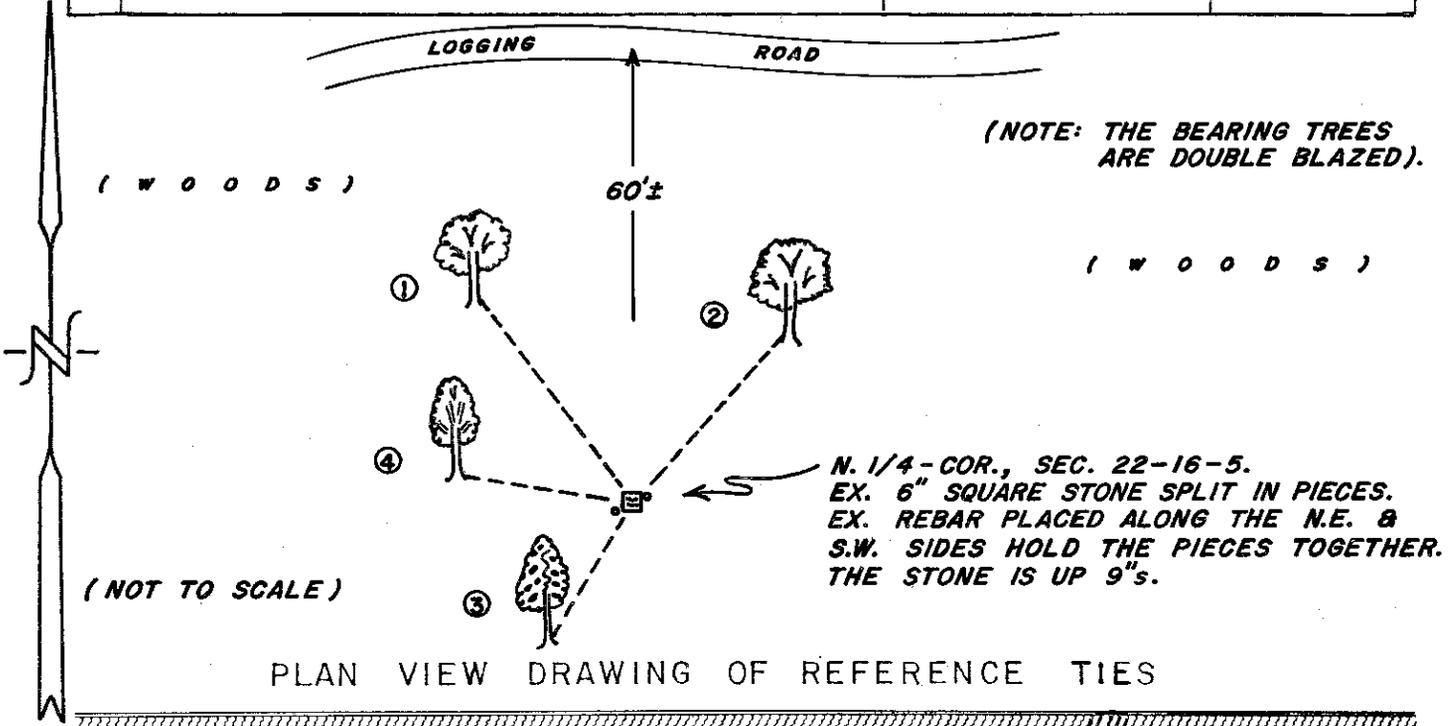

MAP SHOWING DISTANCE AND DIRECTION TO OTHER PUBLIC LAND SURVEY CORNERS USED FOR REESTABLISHING THE CORNER  
(GRID BEARINGS AND DISTANCES)

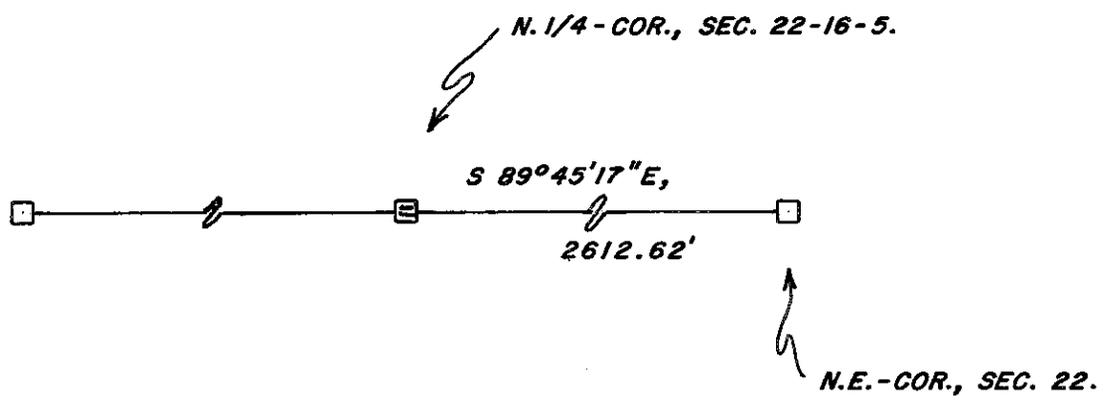

I, BRYAN H. MEYER, COUNTY SURVEYOR  
HEREBY CERTIFY THAT THE CORNER LOCATION SHOWN ON THIS RECORD WAS DETERMINED BY ME OR UNDER MY DIRECTION AND CONTROL AND THAT THIS U. S. PUBLIC LAND SURVEY MONUMENT RECORD IS CORRECT AND COMPLETE TO THE BEST OF MY KNOWLEDGE AND BELIEF.

Bryan H. Meyer      July 9, 2010  
Signature      Date



Seal


---

 U. S. PUBLIC LAND SURVEY MOUMENT RECORD
 

---

 SECTION 22, T.16N., R.5W., TOWN OF BANGOR  
 LACROSSE COUNTY, WISCONSIN
 

---

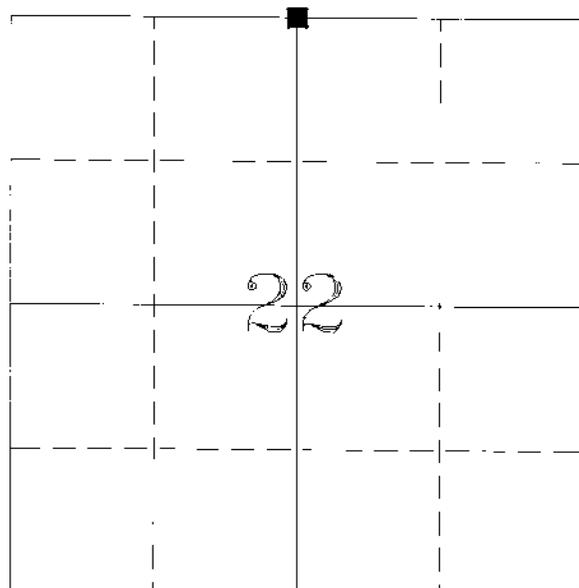

WISCONSIN COORDINATE SYSTEM	
North	
East	
Theta Angle	
Horiz. Order	
Vert. Order	
TYPE OF LANDMARK:	
6" x 6" Square Stone	
BEARINGS ARE REFERENCED TO:	

## LOCATION OF LANDMARK

 Crew: Rodney H. Maxwell  
 Laurence E. Johns III  
 Fred D. Bolen

Date: 26 April 2002

---

 Describe any record evidence, monument evidence, testimonial evidence or any other material evidence you considered and whether the monument was found or restored through acceptance of an obliterated evidence location.

Found 6" Square Stone with top broken off. One side was engraved with 1/4 S. Pieced top back together and placed on intact bottom. Tied top with wire and placed two 3/4" iron rods on N.E. and S.W. sides. Accepted this stone as the best available evidence of the original government corner.

---


 Describe or show any material discrepancy between the location of the restored corner and that of the corner previously restored or re-established.

None known.

# RECORD OF DURABLE WITNESS MONUMENTS


NO.	DESCRIPTION	BEARING	DISTANCE
1	6" Black Oak	N 25' W	19.55'
2	9" White Oak	N 45' E	17.0'
3	6" Shag Bark Hickory	S 40' W	12.2'
4	7" White Oak	West	13.1'

\*\* All trees double blazed with Mag Nail in lower hack.

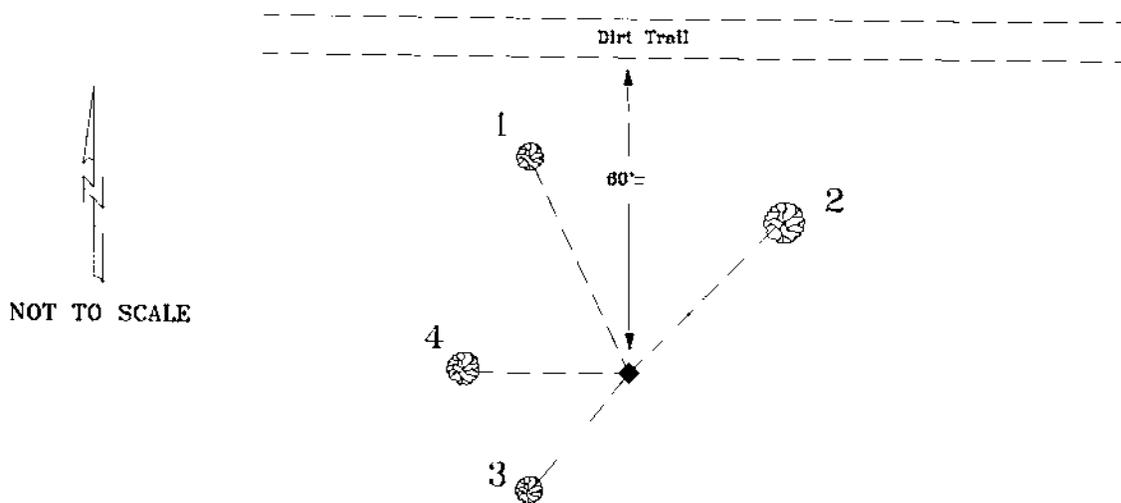

## PLAN VIEW DRAWING OF REFERENCE TIES

Map Showing Distance And Direction To Other Public Land Survey Corners Used For Re-Establishing The Corner

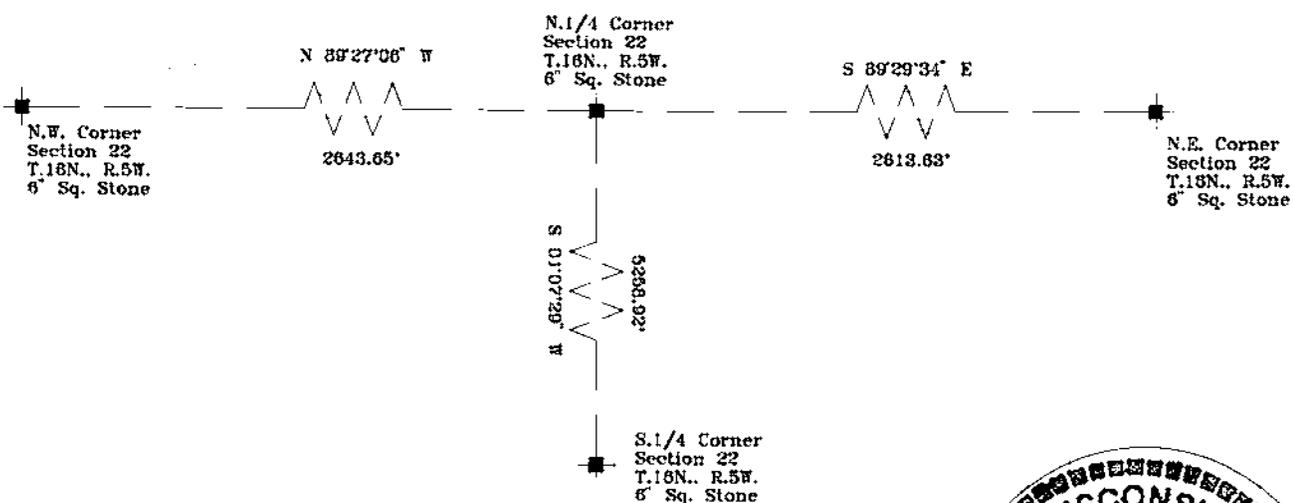

I, Rodney H. Maxwell, Registered Land Surveyor, hereby certify that the corner location shown on this record was determined by me or under my direction and control, and that this U. S. Public Land Survey Monument Record is correct and complete to the best of my knowledge and belief.

*Rodney H. Maxwell*  
 Rodney H. Maxwell  
 Maxwell Surveying  
 7457 Highway 16, Suite C  
 Sparta, Wisconsin  
 28 April 2002

