


21605152000

U. S. PUBLIC LAND SURVEY MONUMENT RECORD

SECTION 15 T 16 N, R 5 W, TOWN OF BANGOR

LA CROSSE COUNTY

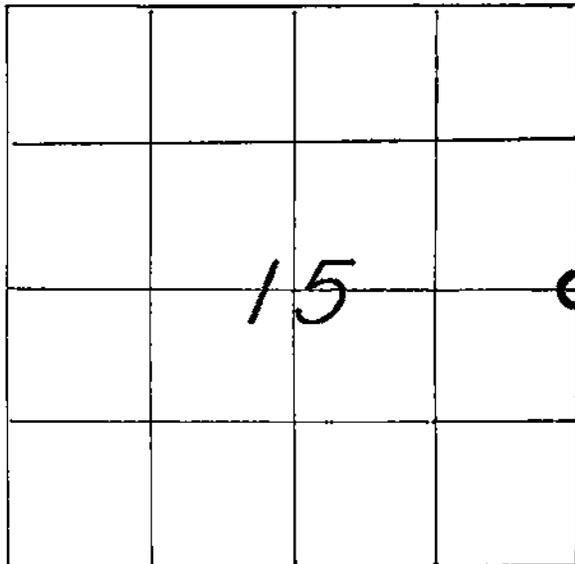

WISCONSIN COORDINATE SYSTEM

North

East

Theta Angle

Horiz. Order

Vert. Order

TYPE OF LANDMARK

3/4" x 30" IRON BAR WITH AN ALUMINUM CAP

BEARINGS ARE REFERENCED TO

LOCATION OF LANDMARK

CREW: WILLIAM C. JUNG

PETER F. FOLLANSBEE

DATE: 5/29/1998

Describe any record evidence, monument evidence, testimonial evidence or any other material evidence you considered and whether the monument was found or restored through acceptance of an obliterated evidence location.


I found Bliss' old 1867 stone of record. The stone was broken and off plumb. I set a 3/4"x30" round iron bar with cap on the Southeast side of the stone. This falls where the corner would be if the stone was plumbed up. A sign and post were set on the Southwest side of the corner.

Describe or show any material discrepancy between the location of the restored corner and that of the corner previously restored or reestablished.

NONE KNOWN.

RECORD OF DURABLE WITNESS MONUMENTS

NO	DESCRIPTION	BEARING	DISTANCE
1	SET A NAIL IN THE N.W.-SIDE OF A 12" NUT TREE	S'WESTERLY ±	34.58 FT.
2	SET A NAIL IN THE S.E.-SIDE OF A 16" NUT TREE	S'WESTERLY ±	28.41 FT.
3	SET A NAIL IN THE S.E.-SIDE OF A 10" NUT TREE	S'WESTERLY ±	17.57 FT.
4	SET A NAIL IN THE S.E.-SIDE OF A 10" NUT TREE	S'WESTERLY ±	8.46 FT.

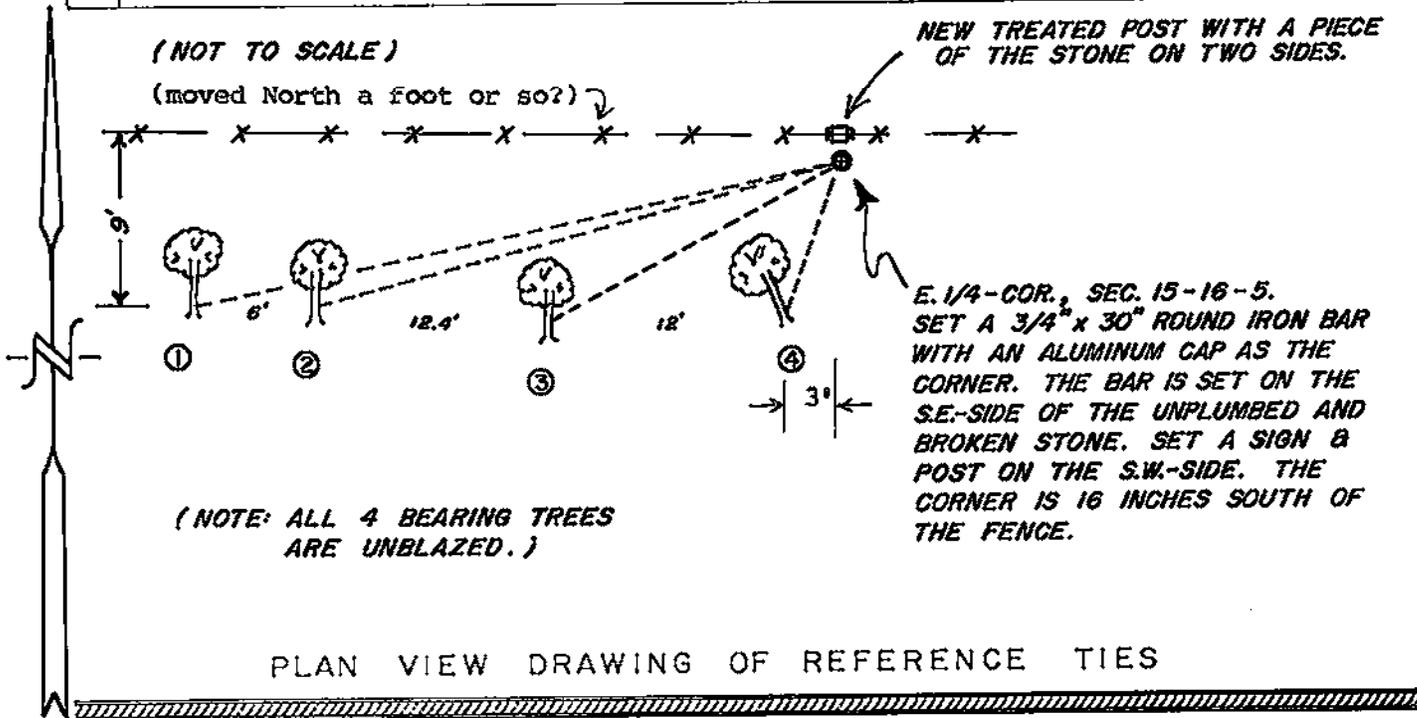


MAP SHOWING DISTANCE AND DIRECTION TO OTHER PUBLIC LAND SURVEY CORNERS USED FOR REESTABLISHING THE CORNER

No further section measurements were made by me at this time.

I, WILLIAM C. JUNG, COUNTY SURVEYOR
HEREBY CERTIFY THAT THE CORNER LOCATION SHOWN ON THIS RECORD WAS DETERMINED BY ME OR UNDER MY DIRECTION AND CONTROL AND THAT THIS U. S. PUBLIC LAND SURVEY MONUMENT RECORD IS CORRECT AND COMPLETE TO THE BEST OF MY KNOWLEDGE AND BELIEF.

William C. Jung 8/26/98
Signature Date

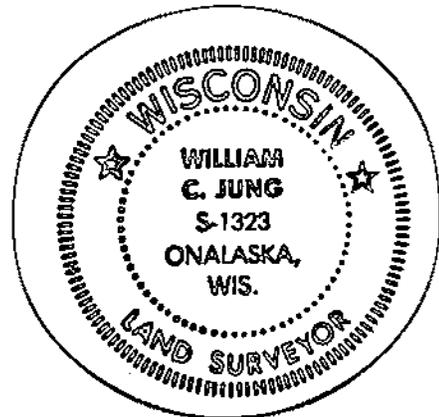

Seal