


21605160000

U. S. PUBLIC LAND SURVEY MONUMENT RECORD

SECTION 16 T 16 N, R 5 W, TOWN OF BANGOR
 LA CROSSE COUNTY

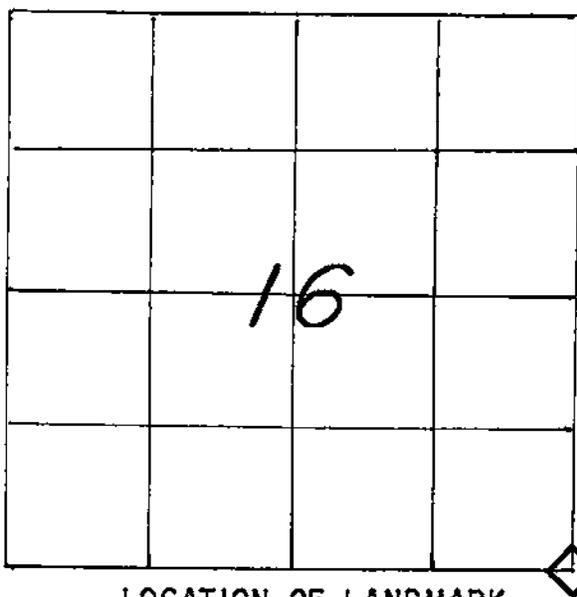

WISCONSIN COORDINATE SYSTEM
North
East
Theta Angle
Horiz. Order
Vert. Order
TYPE OF LANDMARK
6" SQUARE STONE.
BEARINGS ARE REFERENCED TO

LOCATION OF LANDMARK
 CREW: WILLIAM C. JUNG
 PETER F. FOLLANSBEE
 DATE: 12/23/1997

Describe any record evidence, monument evidence, testimonial evidence or any other material evidence you considered and whether the monument was found or restored through acceptance of an obliterated evidence location.

I have accepted Bliss' stone set in 1867 as the best available evidence of the original government corner position.

Describe or show any material discrepancy between the location of the restored corner and that of the corner previously restored or reestablished.

NONE KNOWN.

