


21605162000

## U. S. PUBLIC LAND SURVEY MONUMENT RECORD

SECTION 16 T 16 N, R 5 W, TOWN OF BANGOR

LA CROSSE COUNTY

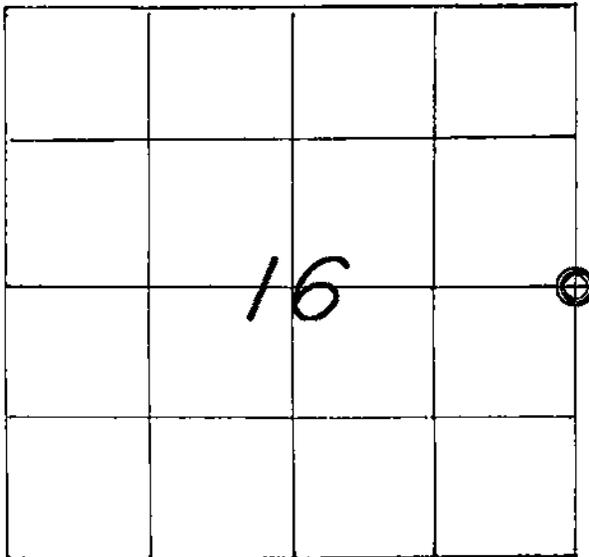

WISCONSIN COORDINATE SYSTEM

North

East

Theta Angle

Horiz. Order

Vert. Order

TYPE OF LANDMARK

IRON BAR WITH AN ALUMINUM CAP

BEARINGS ARE REFERENCED TO

## LOCATION OF LANDMARK

CREW: WILLIAM C. JUNG  
 PETER F. FOLLANSBEE  
 DATE: 5/29/1998

Describe any record evidence, monument evidence, testimonial evidence or any other material evidence you considered and whether the monument was found or restored through acceptance of an obliterated evidence location.


Paul Fairchild set an iron bar at this corner using single proportionate measurement. I agree with this decision. Fairchild's East section line measurement was 5283.51 . I set a cap on his iron bar and pounded it down 16" in the field.

Describe or show any material discrepancy between the location of the restored corner and that of the corner previously restored or reestablished.

**NONE KNOWN.**

RECORD OF DURABLE WITNESS MONUMENTS

NO	DESCRIPTION	BEARING	DISTANCE
1	CHISELLED A CROSS IN CONCRETE SPLASH PAD	S'EASTERLY ±	57.12 FT.
2	SET A 1-1/4" x 8-1/2" IRON PIPE IN GRASS WATERWAY	N'EASTERLY ±	35.06 FT.
3	SET A 3/4" x 15" IRON BAR IN GRASS WATERWAY	N'EASTERLY ±	37.20 FT.
4	SET A 1-1/4" x 21" ROUND STEEL SHAFT IN GR. WATERWAY	N'WESTERLY ±	61.01 FT.

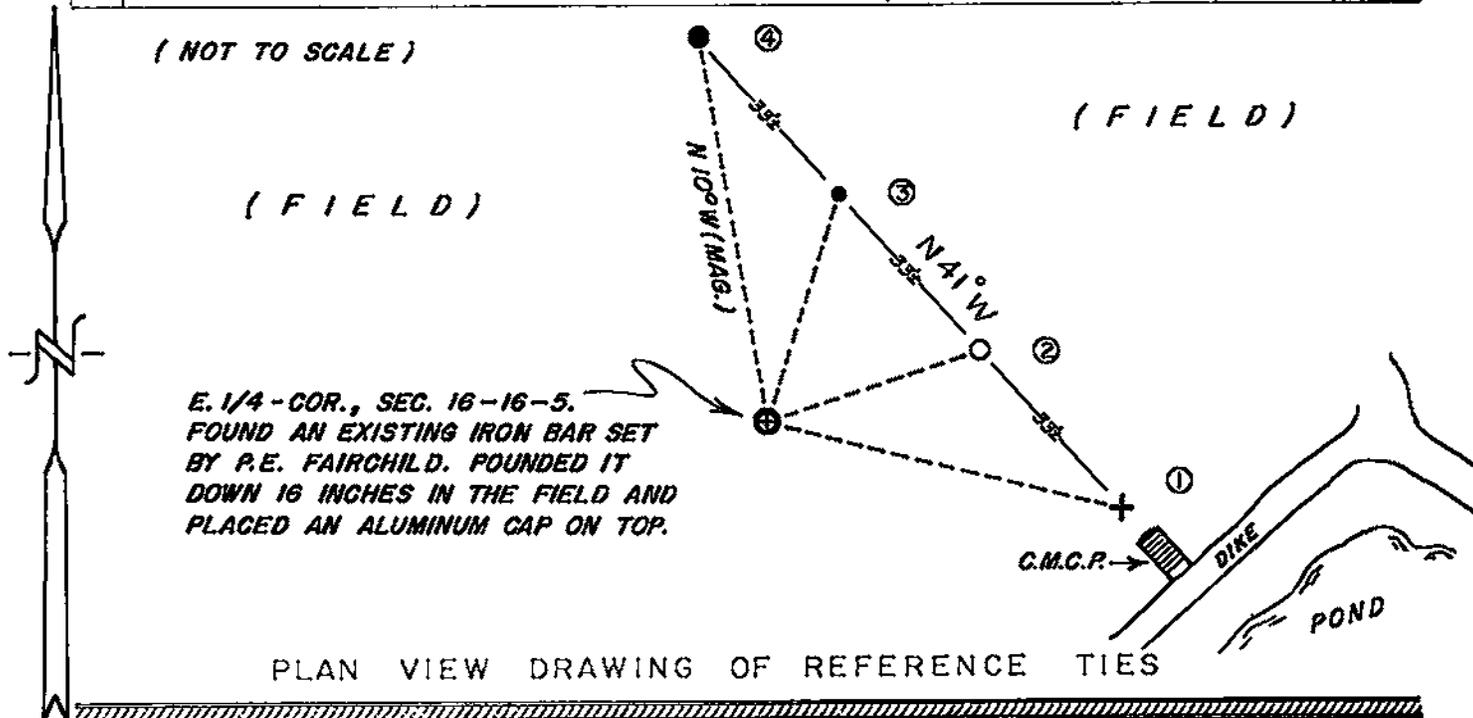

MAP SHOWING DISTANCE AND DIRECTION TO OTHER PUBLIC LAND SURVEY CORNERS USED FOR REESTABLISHING THE CORNER

No section measurements were made by me at this time. Paul Fairchild confirmed this location with his section data.

I, WILLIAM C. JUNG, COUNTY SURVEYOR  
 HEREBY CERTIFY THAT THE CORNER LOCATION SHOWN ON THIS RECORD  
 WAS DETERMINED BY ME OR UNDER MY DIRECTION AND CONTROL AND  
 THAT THIS U. S. PUBLIC LAND SURVEY MONUMENT RECORD IS CORRECT  
 AND COMPLETE TO THE BEST OF MY KNOWLEDGE AND BELIEF.

*William C. Jung*  
 Signature

8/26/98  
 Date



Seal